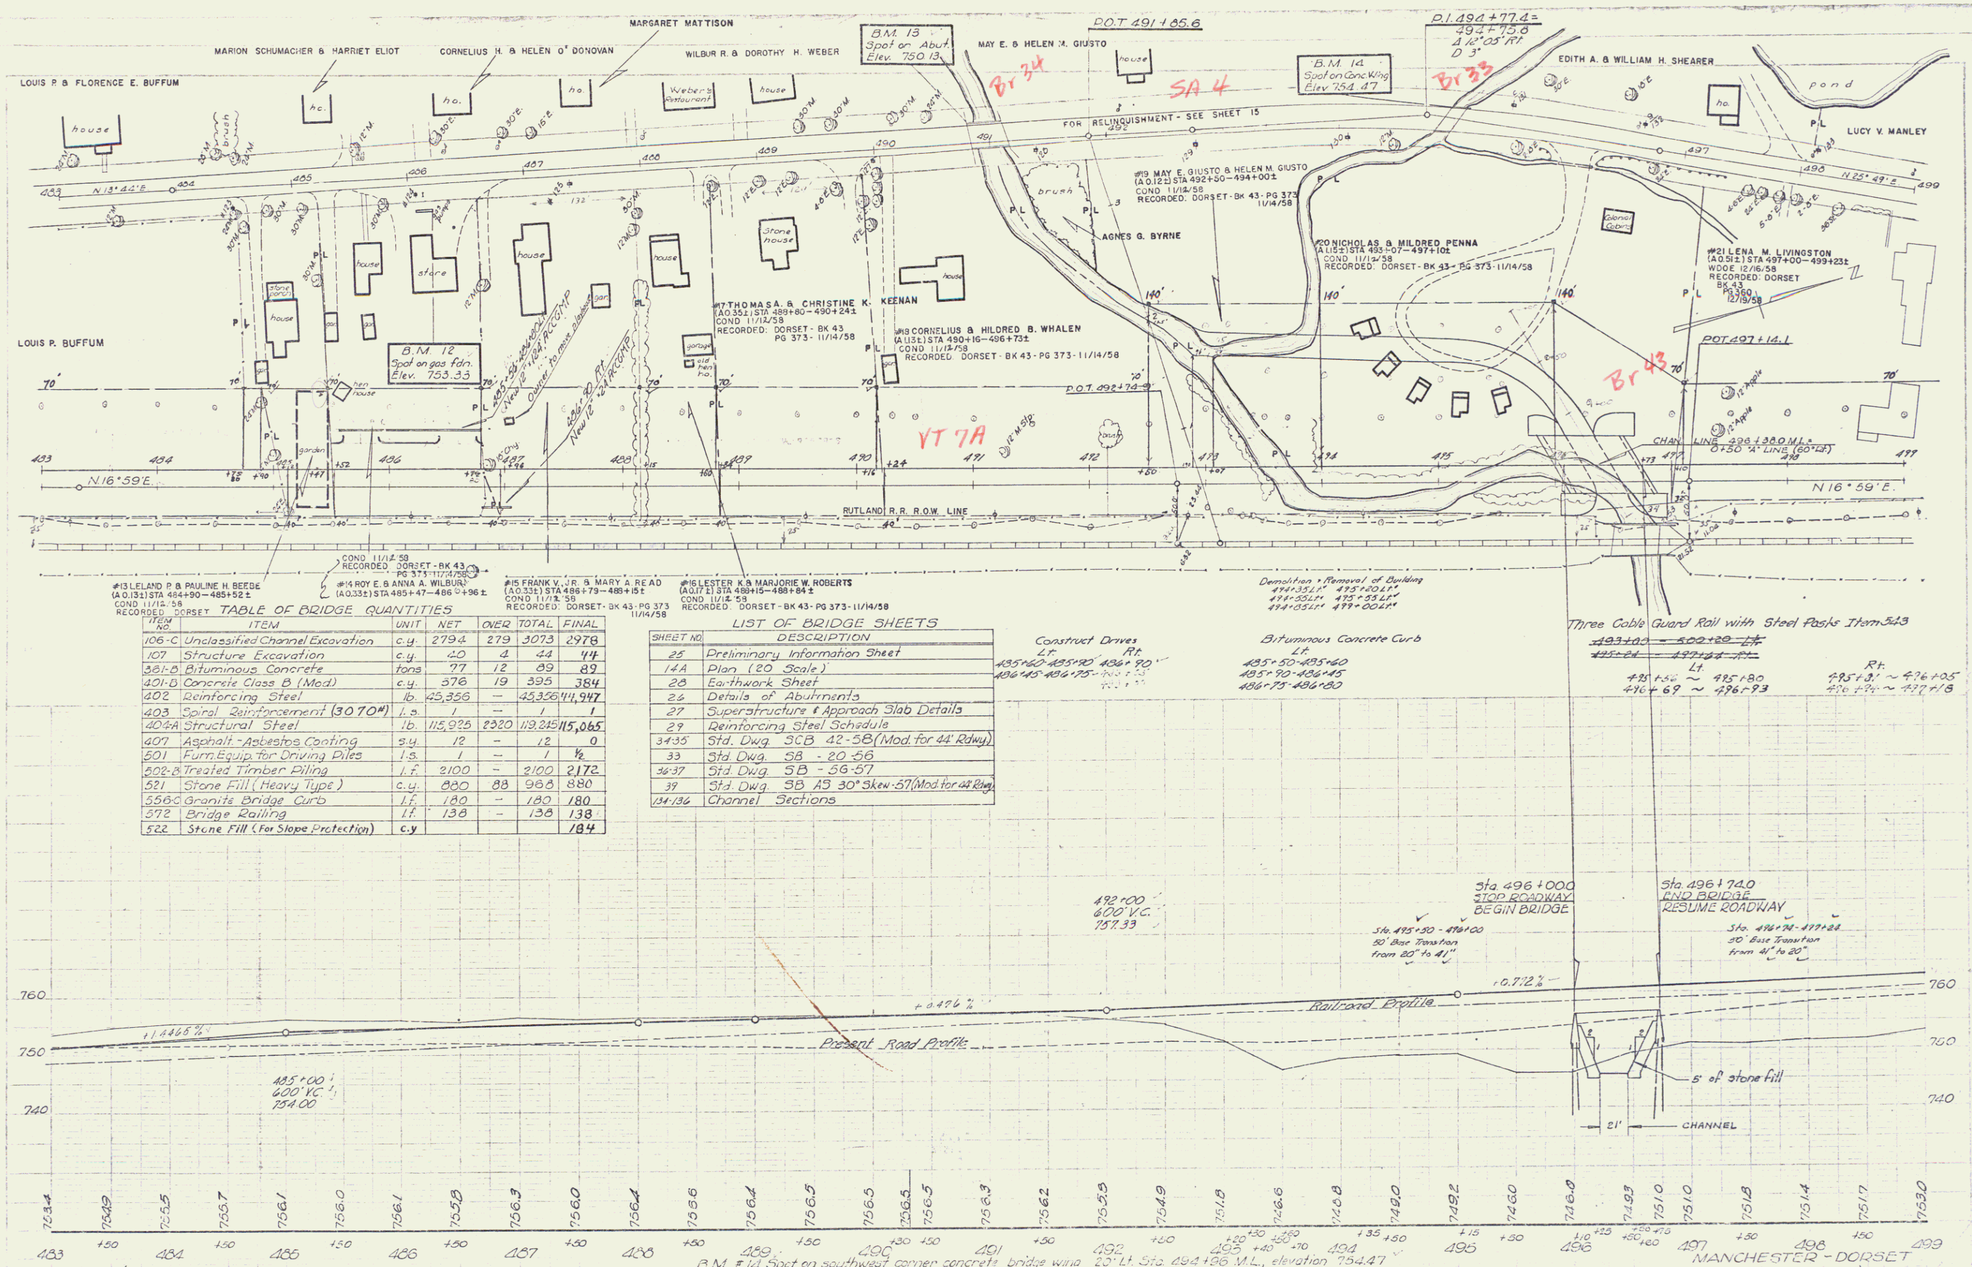

TABLE OF BRIDGE QUANTITIES

ITEM NO.	ITEM	UNIT	NET	OVER	TOTAL	FINAL
106-C	Unclassified Channel Excavation	c.y.	2794	279	3073	2978
107	Structure Excavation	c.y.	40	4	44	44
381-B	Bituminous Concrete	tons	77	12	89	89
401-B	Concrete Class B (Mod.)	c.y.	376	19	395	384
402	Reinforcing Steel	lb.	45,356	—	45,356	44,947
403	Spiral Reinforcement (3070#)	l.s.	1	—	1	1
404-A	Structural Steel	lb.	115,925	2320	113,245	115,065
407	Asphalt-Asbestos Coating	s.y.	12	—	12	0
501	Furn. Equip. for Driving Piles	l.s.	1	—	1	½
502-B	Treated Timber Piling	l.f.	2100	—	2100	2172
521	Stone Fill (Heavy Type)	c.y.	880	88	968	880
556-C	Granite Bridge Curb	l.f.	180	—	180	180
572	Bridge Railing	l.f.	138	—	138	138
522	Stone Fill (For Slope Protection)	c.y.				184

LIST OF BRIDGE SHEETS

SHEET NO.	DESCRIPTION
25	Preliminary Information Sheet
14A	Plan (20 Scale)
28	Earthwork Sheet
26	Details of Abutments
27	Superstructure & Approach Slab Details
29	Reinforcing Steel Schedule
34-35	Std. Dwg. SCB 42-58 (Mod. for 44' Rdwy.)
33	Std. Dwg. SB - 20-56
36-37	Std. Dwg. SB - 56-57
39	Std. Dwg. SB A3 30° Skew-57 (Mod. for 48' Rdwy.)
134-136	Channel Sections

9