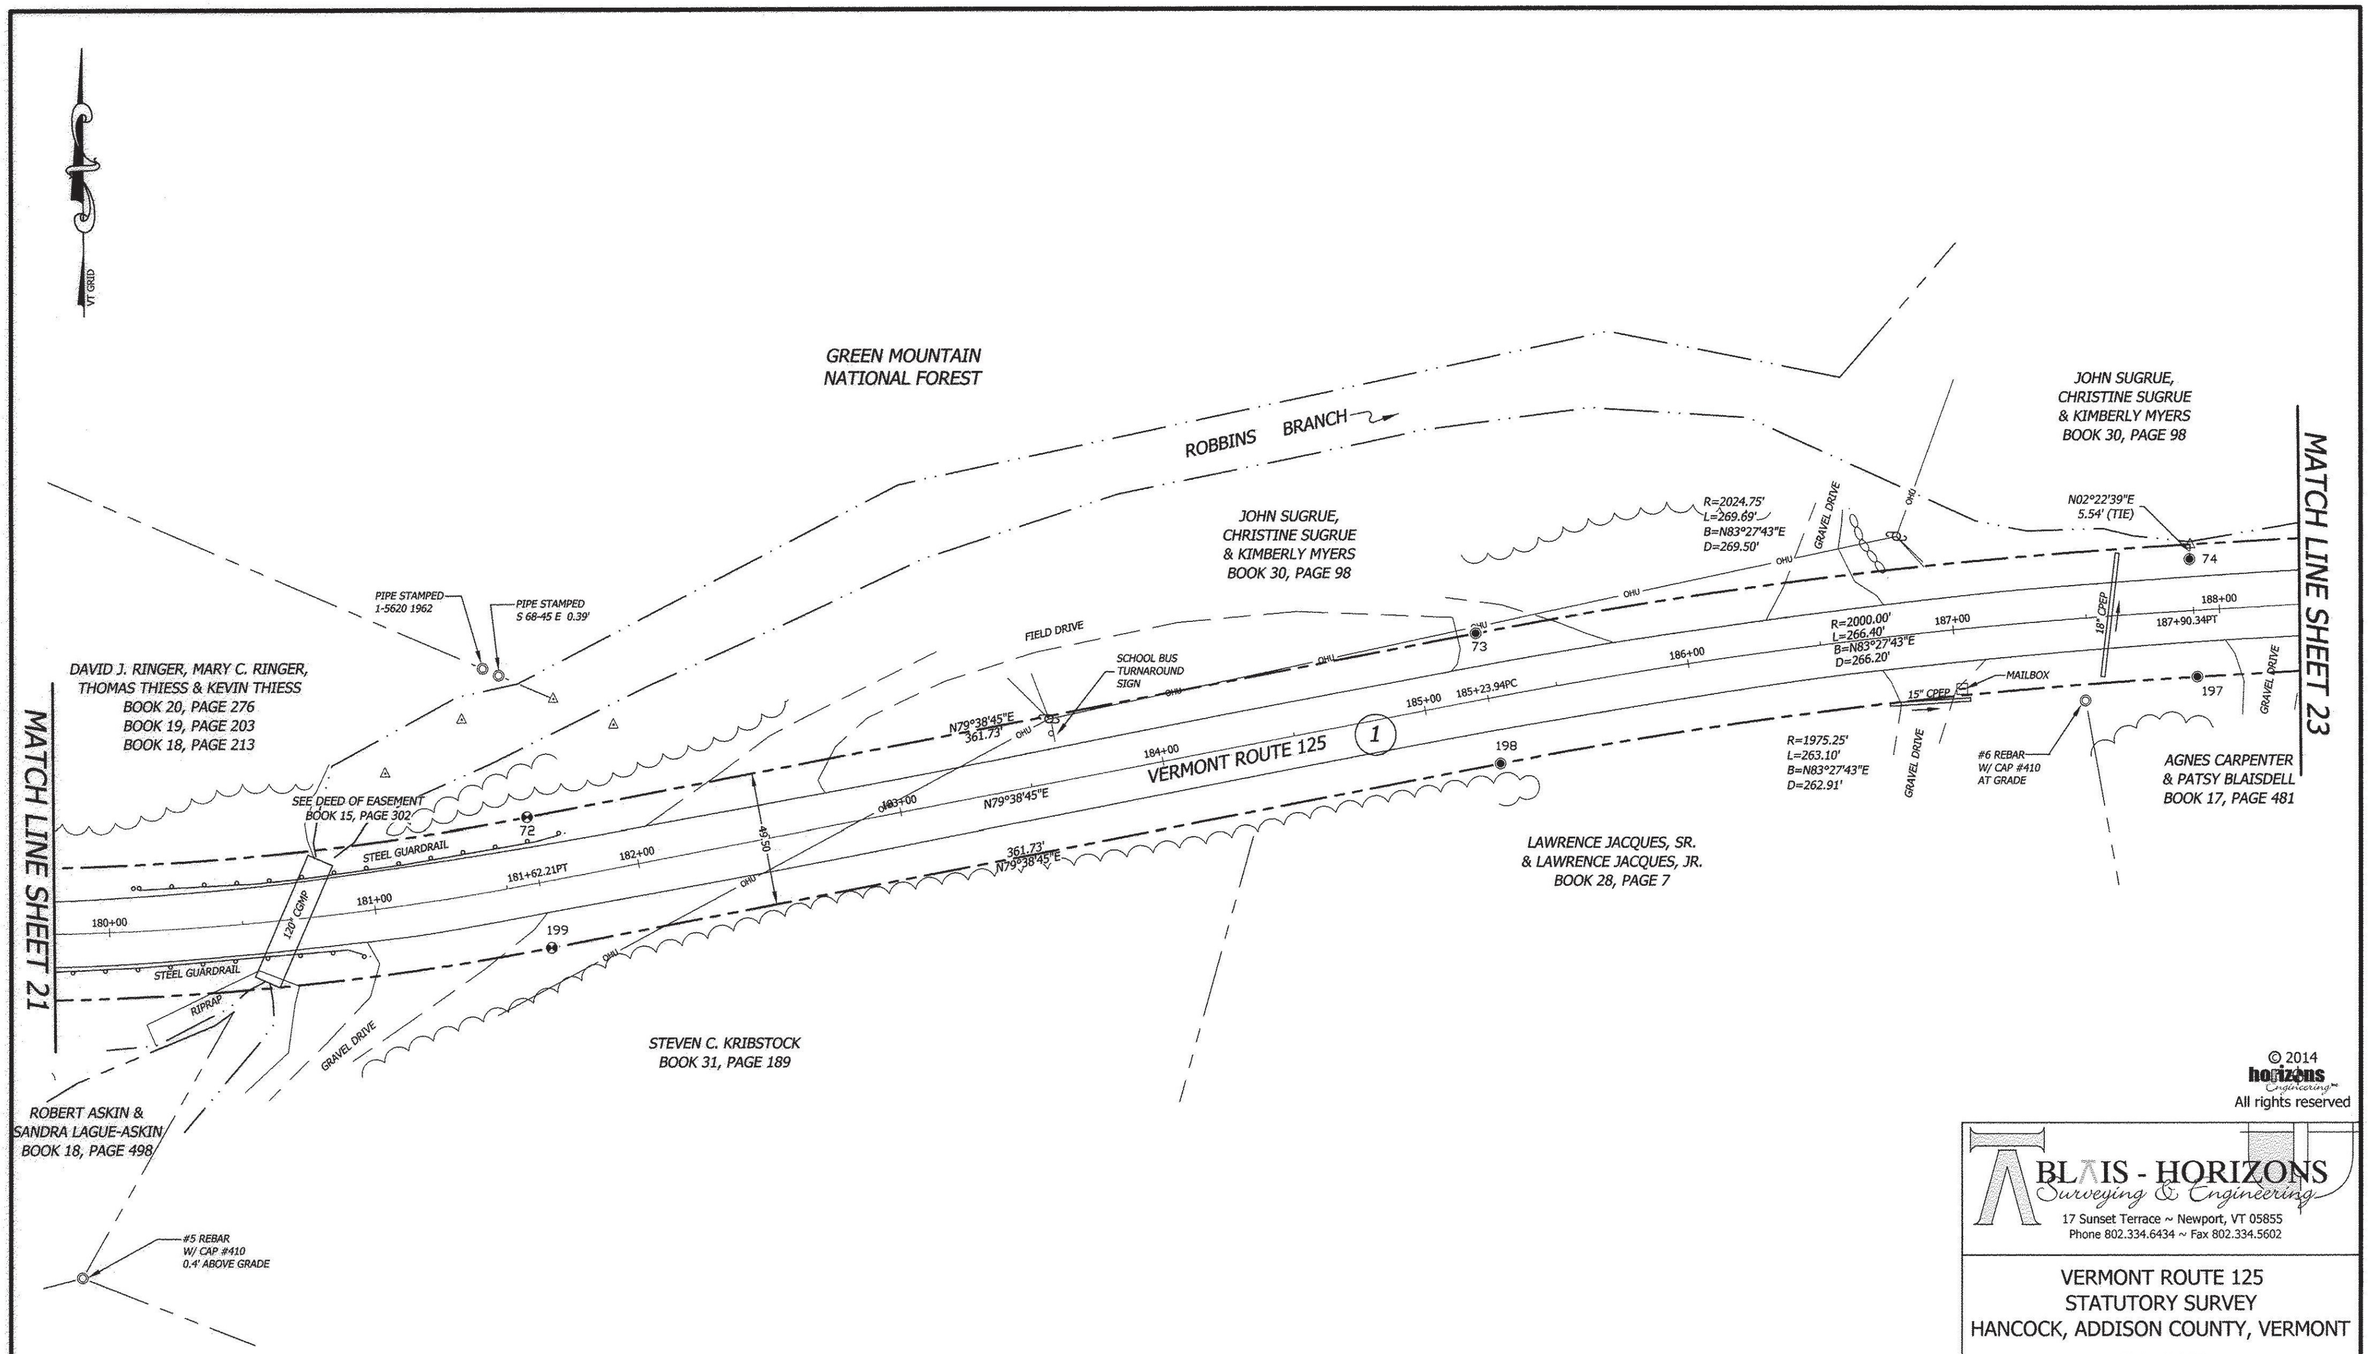

© 2014 horizons Engineering™ All rights reserved

BLAIS - HORIZONS Surveying & Engineering
17 Sunset Terrace ~ Newport, VT 05855
Phone 802.334.6434 ~ Fax 802.334.5602

VERMONT ROUTE 125
STATUTORY SURVEY
HANCOCK, ADDISON COUNTY, VERMONT

PREPARED FOR

VERMONT AGENCY OF TRANSPORTATION
1 NATIONAL LIFE DRIVE
MONTPELIER, VT 05633-5001

MONUMENT DETAIL TABLE

PT.	NORTHING	EASTING	BASELINE OFFSET	DESCRIPTION
72	520409.11	1531403.56	181+62.21 24.75 L	FENO MARKER 0.7' AG
73	520474.12	1531759.40	185+23.94 24.75 L	5/8-INCH REBAR FLUSH WITH GRADE
74	520499.27	1532026.91	187+89.85 19.23 L	5/8-INCH REBAR 0.5' AG
197	520455.36	1532029.49	187+90.34 24.75 R	5/8-INCH REBAR 0.0' AG
198	520425.43	1531768.29	185+23.94 24.75 R	5/8-INCH REBAR 1.0' AG
199	520360.41	1531412.45	181+62.21 24.75 R	FENO MARKER 0.2' AG

0 40 80 120

7/24/2014
NATHAN P. NADEAU, LS — DATE

I CERTIFY THAT THIS IS A CORRECT SURVEY TO THE BEST OF MY KNOWLEDGE BASED UPON AN EDM TOTAL STATION AND GPS FIELD SURVEY AND TOWN OF HANCOCK AND REFERENCED LAND AND HIGHWAY RECORDS. THIS PLAT MEETS THE REQUIREMENTS OF 27 VSA SECTION 1403.

STATE OF VERMONT — NATHAN P. NADEAU No. 754 — LICENSED LAND SURVEYOR

DATE: 7-23-2014	SCALE 1IN. = 40FT.
SURV'D BY: DR/JB/JN	DRAWN BY: NPN/AJN
CHECK'D BY: NPN/AJN	PROJECT #: 12568

SHEET 22 OF 45

BLAIS-HORIZONS CERTIFIES THAT THIS DRAWING WAS PRODUCED AS AN ORIGINAL INK ON MYLAR
SIGNATURE