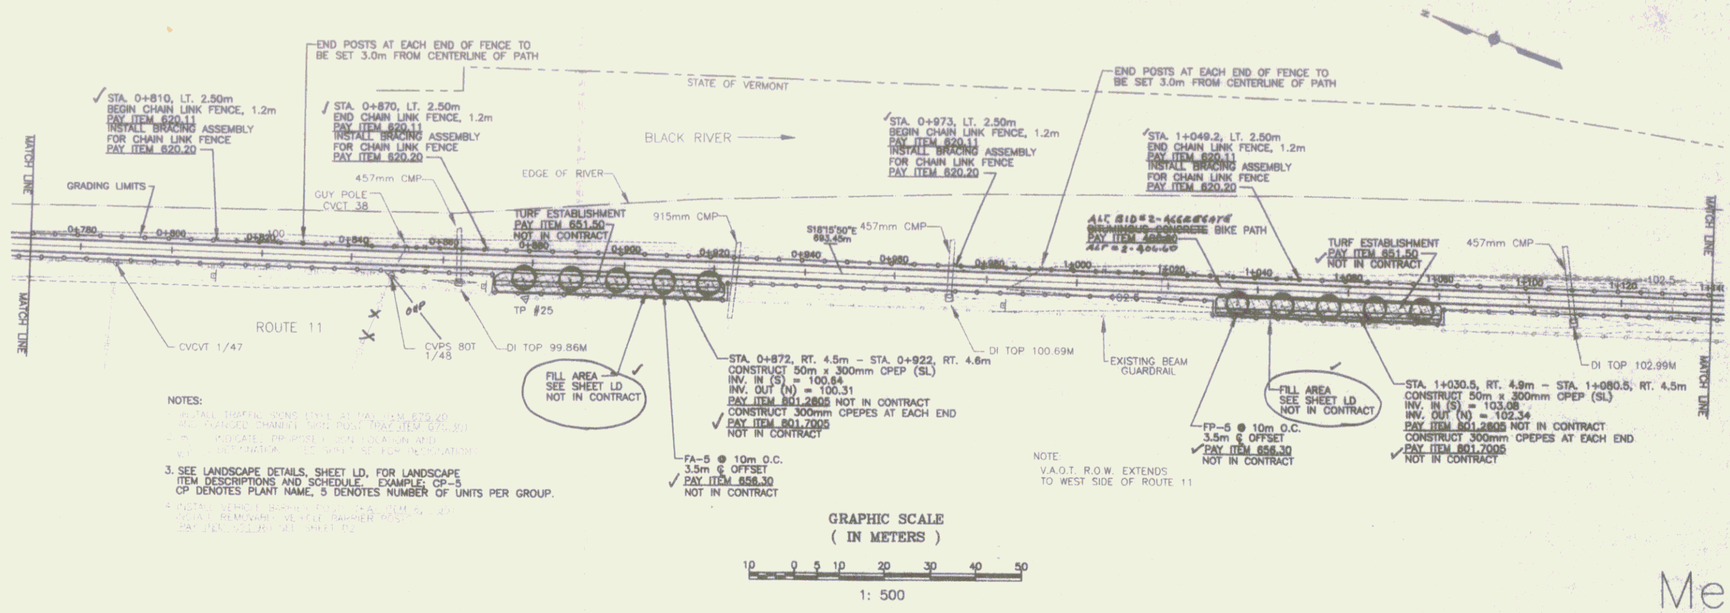

Metric

DATUM
VERTICAL: NGVD1929
HORIZONTAL: N/A

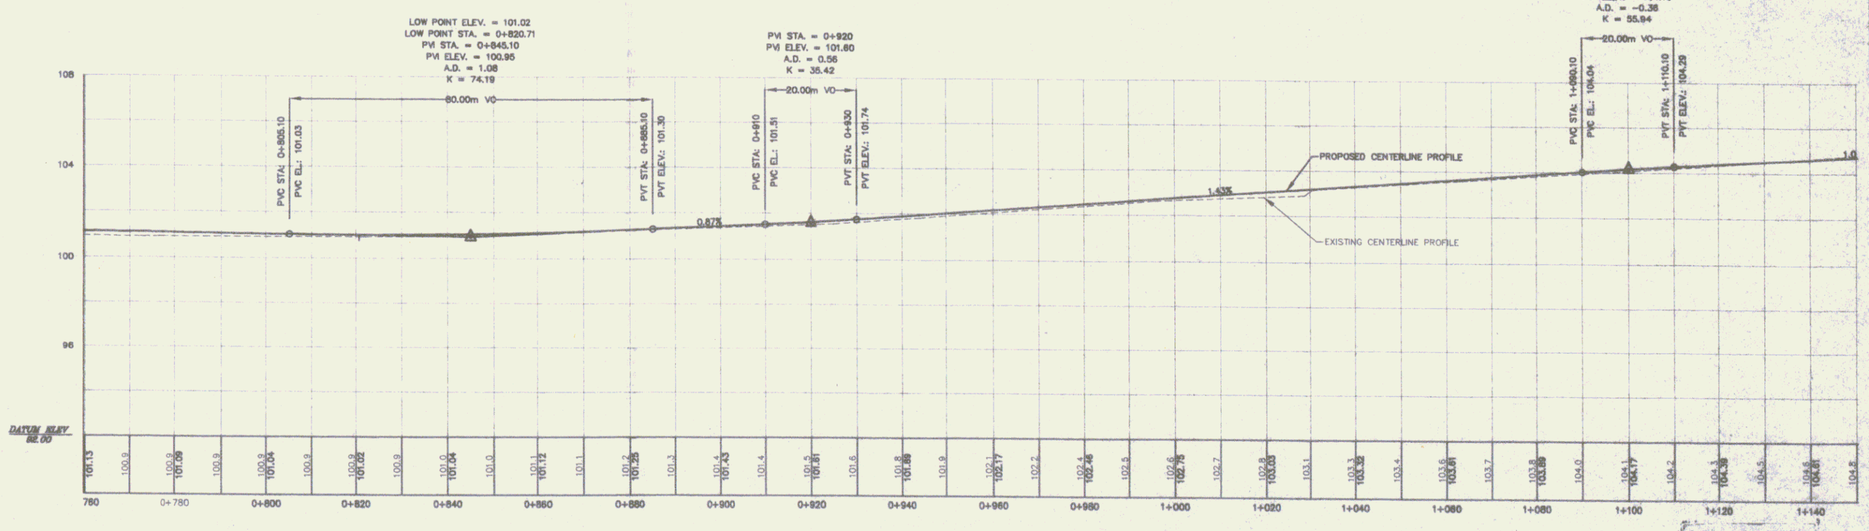

BIKE PATH PROFILE
SCALE : HORIZ. 1:500
VERT. 1:100

RECORD DRAWINGS

SHEET 5

5

NO.	DATE	REVISIONS	BY
3	11/98	REVISED PER REVIEW COMMENTS	AJP
2	8/98	REVISED PER REVIEW COMMENTS	AJP
1	3/98	REVISED PER REVIEW COMMENTS	AJP

SPRINGFIELD TRANSPORTATION PATH
PHASE 1
TOWN OF SPRINGFIELD
SPRINGFIELD, VERMONT
PLAN AND PROFILE

METRIC

PP3