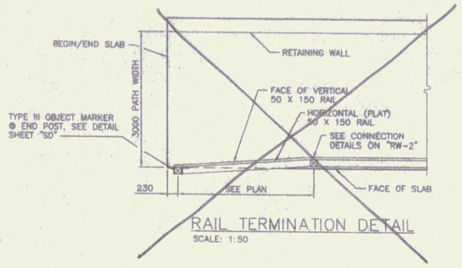

RAIL TERMINATION DETAIL
SCALE: 1:50

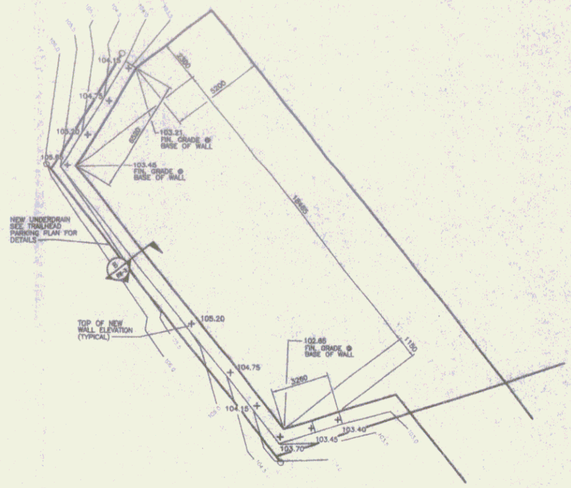

TRAILHEAD PARKING AREA
RETAINING WALL LAYOUT PLAN
SCALE: 1:125

ALL WORK RELATING TO NEW RETAINING WALL SHALL BE PAID SUBSIDIARY TO ITEM 599.01

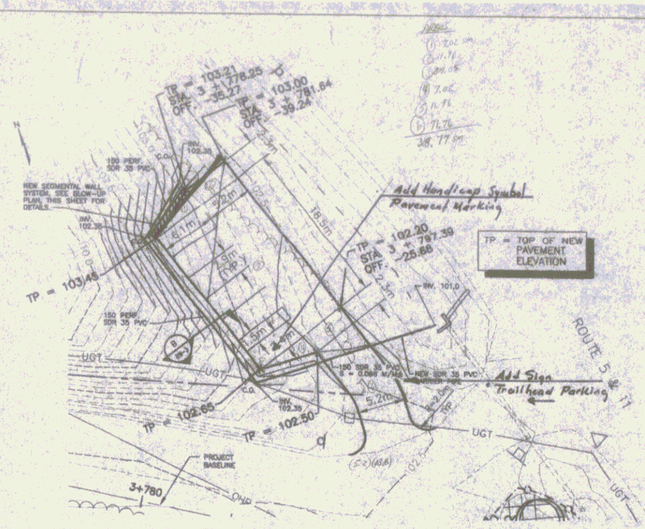

TRAILHEAD PARKING AREA PLAN
SCALE: 1:250

NOTES:
1. SEGMENTAL WALL SYSTEM (SWS) SHALL BE CONSTRUCTED TO THE LINES AND GRADES DESIGNATED ON THESE DRAWINGS. CONTRACTOR SHALL SUBMIT DESIGN, LATEST EDITION OF MANUFACTURER'S SPECIFICATIONS, METHOD OF INSTALLATION, AND LIST OF MATERIALS PROPOSED FOR USE, TO BE APPROVED BY THE ENGINEER. ACCEPTABLE SWS MANUFACTURERS ARE KEYSTONE, VERSA-LOK, ANCHOR WALL SYSTEMS, OR APPROVED EQUAL.
2. SEE SHEET PP-10 FOR ADDITIONAL INFORMATION REGARDING TRAILHEAD PARKING AREA PLAN.

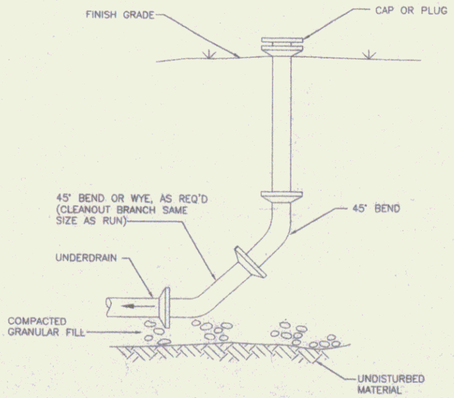

CLEANOUT TO GRADE DETAIL
NOT TO SCALE

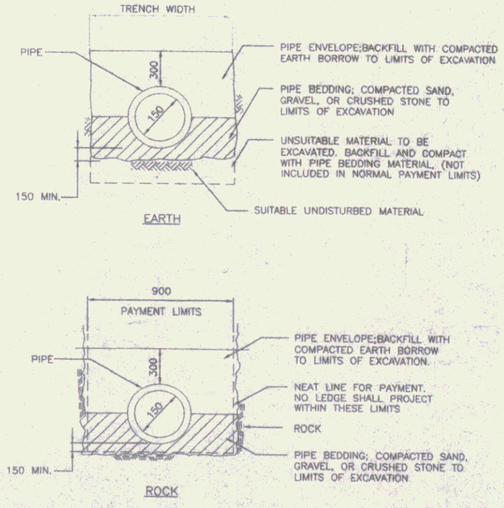

CARRIER PIPE TRENCH SECTIONS
NOT TO SCALE

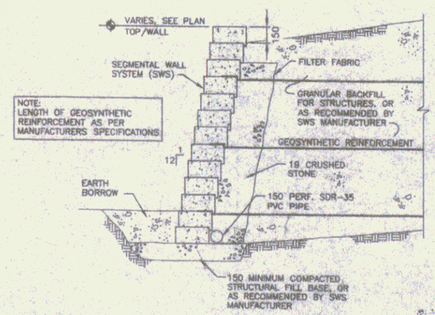

SECTION
1:20

RECORD DRAWINGS

SPRINGFIELD TRANSPORTATION PATH
PHASE 1
TOWN OF SPRINGFIELD
SPRINGFIELD, VERMONT
TRAILHEAD PARKING AREA RETAINING WALL

RW-3

SHEET 16

16