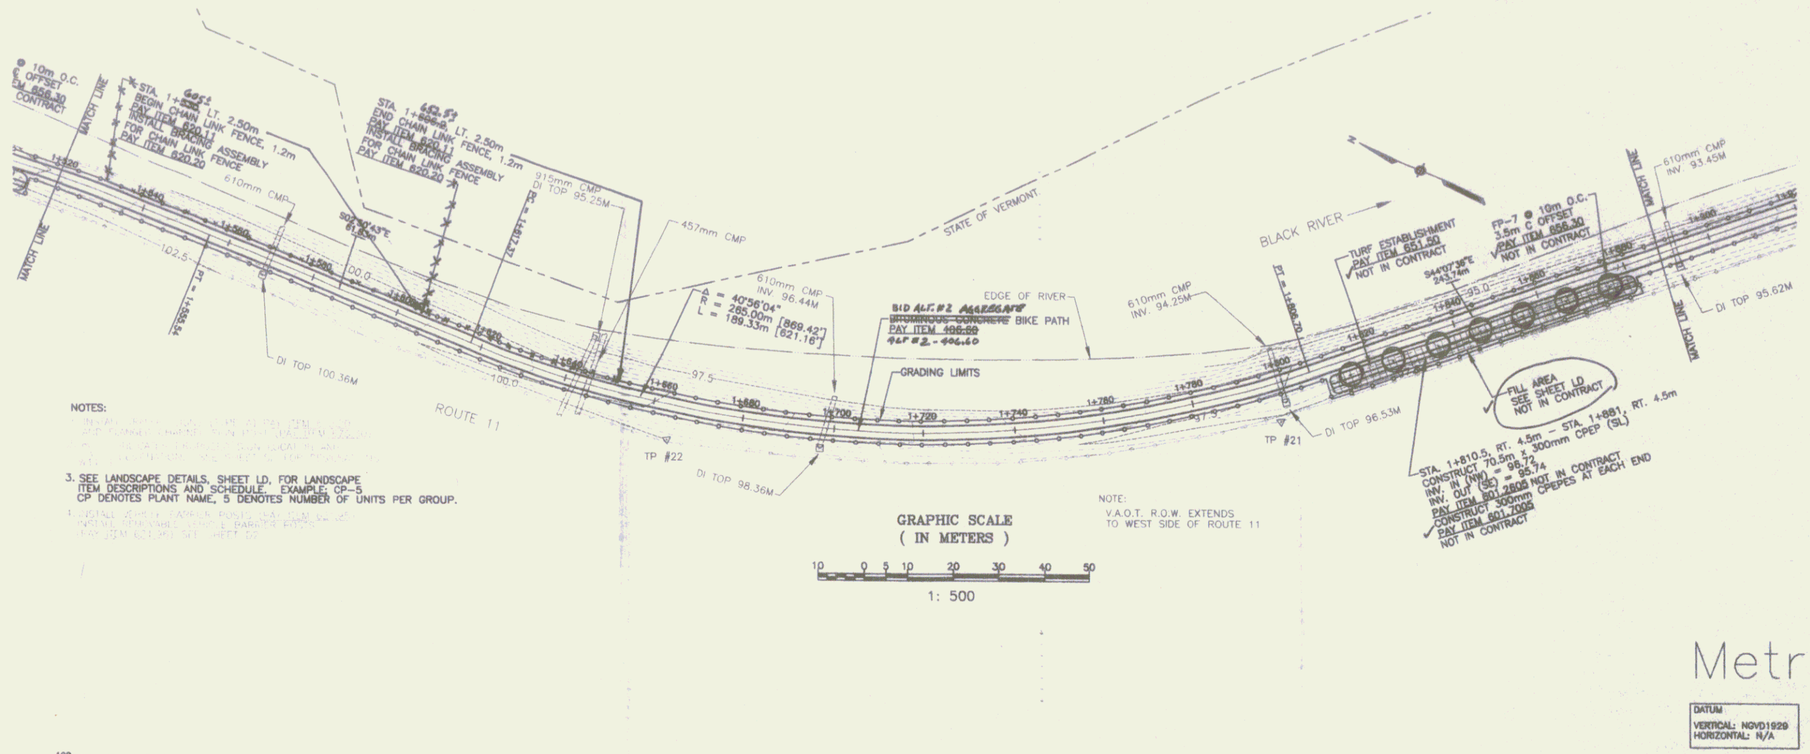
STATE OF VERMONT
BLACK RIVER
ROUTE 11
EDGE OF RIVER
GRADING LIMITS
MATCH LINE
TURF ESTABLISHMENT
PAY ITEM 651.50
NOT IN CONTRACT
FP-7 @ 10m O.C.
3.5m C OFFSET
PAY ITEM 656.30
NOT IN CONTRACT
FILL AREA
SEE SHEET LD
NOT IN CONTRACT
DI TOP 100.36M
DI TOP 98.36M
DI TOP 96.53M
DI TOP 95.62M
TP #22
TP #21
610mm CMP
457mm CMP
915mm CMP
DI TOP 95.25M
610mm CMP INV. 96.44M
610mm CMP INV. 94.25M
610mm CMP INV. 93.45M
S44°07'38"E
243.74m
S02°07'43"E
61.8m
STA. 1+520.5
BEGIN CHAIN LINK FENCE, 1.2m
PAY ITEM 620.10
INSTALL ONE CHAIN LINK FENCE, 2.50m
FOR CHAIN BIKING ASSEMBLY
PAY ITEM 620.20
STA. 1+880.5
END CHAIN LINK FENCE, 1.2m
PAY ITEM 620.10
INSTALL ONE CHAIN LINK FENCE, 2.50m
FOR CHAIN BIKING ASSEMBLY
PAY ITEM 620.20
STA. 1+810.5, RT. 4.5m — STA. 1+881, RT. 4.5m
CONSTRUCT 70.5m x 300mm CPEP (SL)
INV. IN (NW) = 96.72
INV. OUT (SE) = 96.74
PAY ITEM 601.2805 NOT IN CONTRACT
CONSTRUCT 300mm CPEPES AT EACH END
PAY ITEM 601.7005
NOT IN CONTRACT
NOTES:
3. SEE LANDSCAPE DETAILS, SHEET LD, FOR LANDSCAPE ITEM DESCRIPTIONS AND SCHEDULE. EXAMPLE: CP-5 CP DENOTES PLANT NAME, 5 DENOTES NUMBER OF UNITS PER GROUP.
NOTE:
V.A.O.T. R.O.W. EXTENDS TO WEST SIDE OF ROUTE 11
GRAPHIC SCALE
(IN METERS)
1: 500
Metric
DATUM
VERTICAL: NGVD1929
HORIZONTAL: N/A
PVI STA. = 1+840
PVI ELEV. = 97.00
A.D. = 0.52
K = 38.55
20.00m VC
PVC STA: 1+830
PVC EL: 97.17
PVT STA: 1+850
PVT ELEV: 96.68
-1.70%
-1.18%
PROPOSED CENTERLINE PROFILE
EXISTING CENTERLINE PROFILE
610mm CMP
DATUM ELEV 92.00
BIKE PATH PROFILE
SCALE : HORIZ. 1:500
VERT. 1:100
RECORD DRAWINGS
SHEET 7
SPRINGFIELD TRANSPORTATION PATH
PHASE 1
TOWN OF SPRINGFIELD
SPRINGFIELD, VERMONT
PLAN AND PROFILE
METRIC
PP5
7