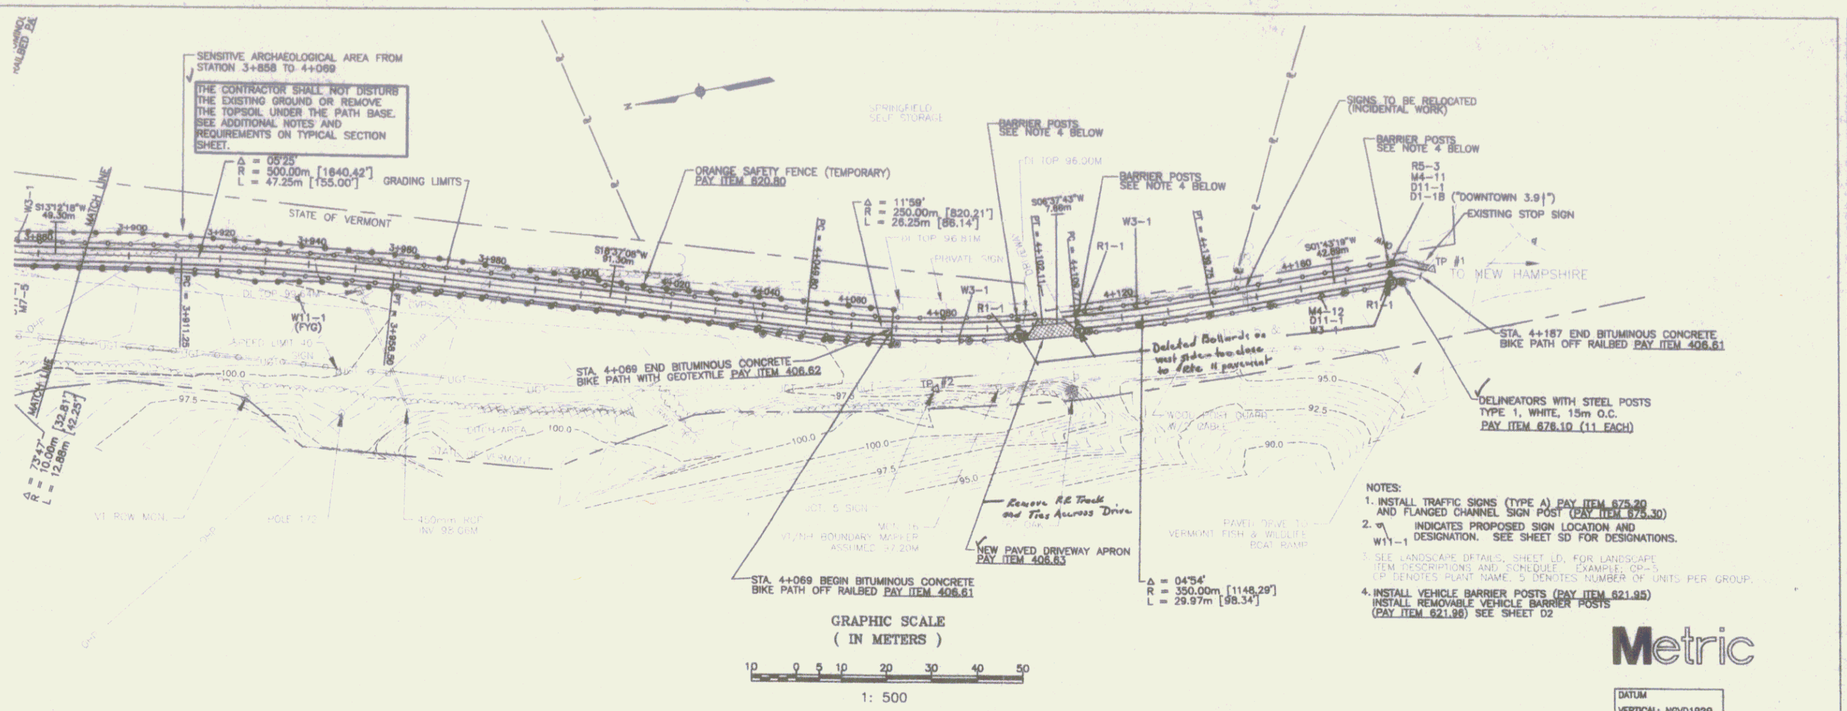

NOTES:

1. INSTALL TRAFFIC SIGNS (TYPE A) PAY ITEM 675.20 AND FLANGED CHANNEL SIGN POST (PAY ITEM 675.30)
2. W11-1 INDICATES PROPOSED SIGN LOCATION AND DESIGNATION. SEE SHEET SD FOR DESIGNATIONS.
3. SEE LANDSCAPE DETAILS, SHEET LD, FOR LANDSCAPE ITEM DESCRIPTIONS AND SCHEDULE. EXAMPLE: OP-5 (P DENOTES PLANT NAME, 5 DENOTES NUMBER OF UNITS PER GROUP.
4. INSTALL VEHICLE BARRIER POSTS (PAY ITEM 621.95) INSTALL REMOVABLE VEHICLE BARRIER POSTS (PAY ITEM 621.96) SEE SHEET D2

Metric

DATUM
VERTICAL: NGVD1929
HORIZONTAL: N/A

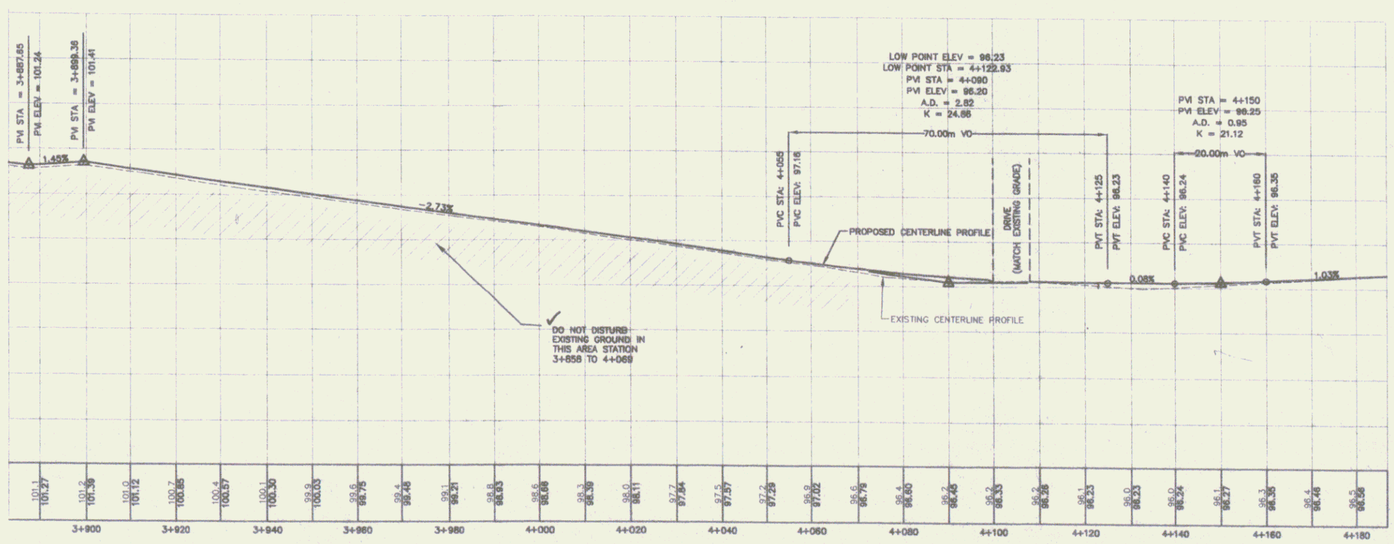

BIKE PATH PROFILE
SCALE : HORIZ. 1:500
VERT. 1:100

RECORD DRAWINGS

DuBois & King
engineering planning management development
100 Parkwood Road Boston, New Hampshire 03303 (603) 225-7920

NO.	DATE	REVISIONS		
2	6/99	REVISED PER REVIEW COMMENTS	JJP	DAF
1	3/99	REVISED PER REVIEW COMMENTS	JJR	DAF

SPRINGFIELD TRANSPORTATION PATH
PHASE 1
TOWN OF SPRINGFIELD
SPRINGFIELD, VERMONT
PLAN AND PROFILE

METRIC

PP11

SHEET 13

13