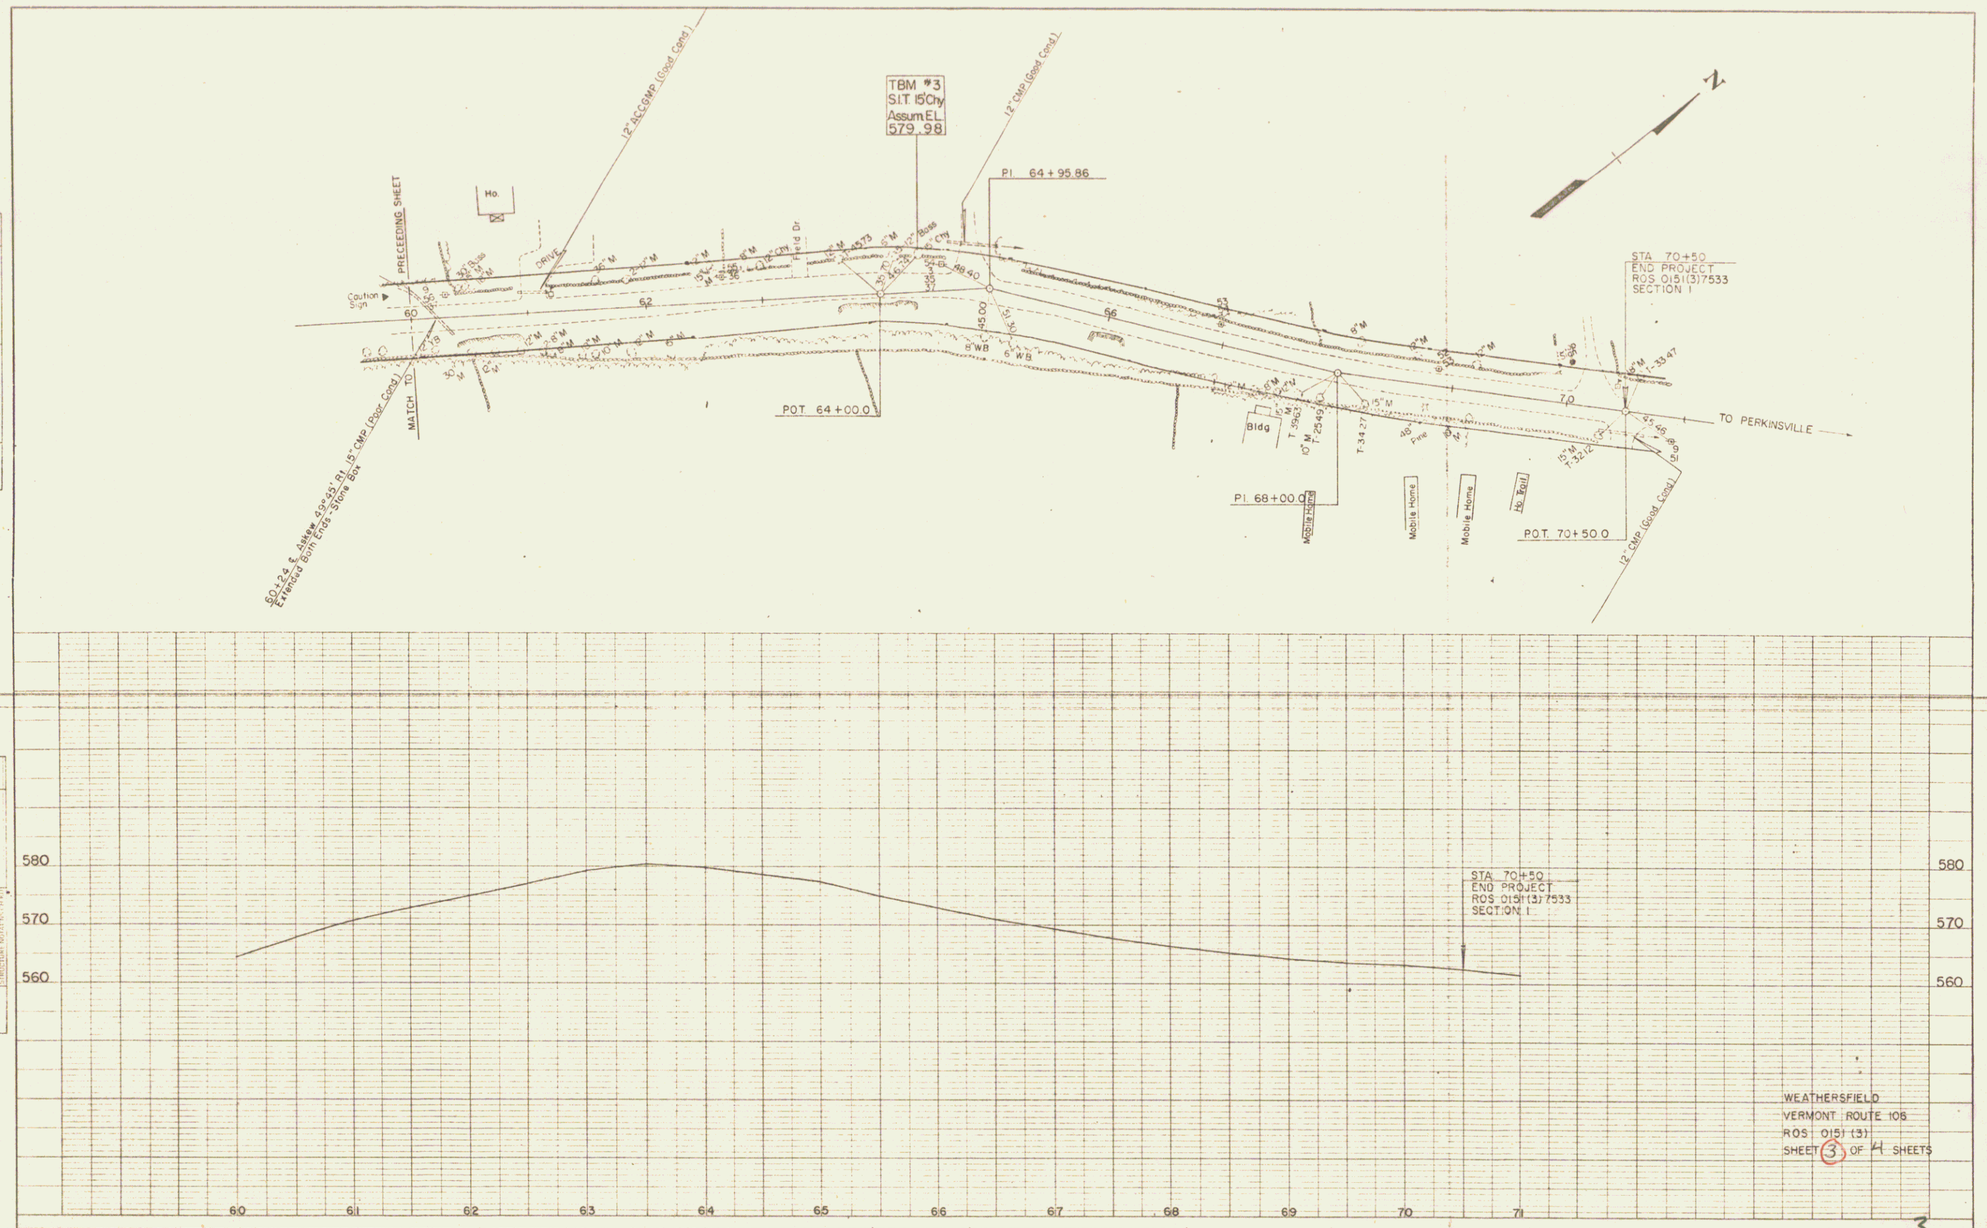
TBM #3
S.I.T. 15" Chy
Assum EL
579.98
12" ASCGMP (Good Cond.)
12" CMP (Good Cond.)
PI 64+95.86
PRECEEDING SHEET
Ho.
DRIVE
Caution Sign
MATCH TO
50+72.6 Ahead 49°45' Rt. 15" CMP (Poor Cond.)
Extended Both Ends Stone Box
POT 64+00.0
PI 68+00.0
Bldg
Mobile Home
Mobile Home
Mobile Home
Ho. Trailer
POT 70+50.0
12" CMP (Good Cond.)
STA 70+50
END PROJECT
ROS 015(3)7533
SECTION 1
TO PERKINSVILLE
N
580
570
560
60
61
62
63
64
65
66
67
68
69
70
71
WEATHERSFIELD
VERMONT ROUTE 106
ROS 015(3)
SHEET 3 OF 4 SHEETS
PLAN
PROFILE
K+E PLATE 1, PLAN-PROFILE
KEUFFEL & ESSER CO.

3