INDEX OF SHEETS

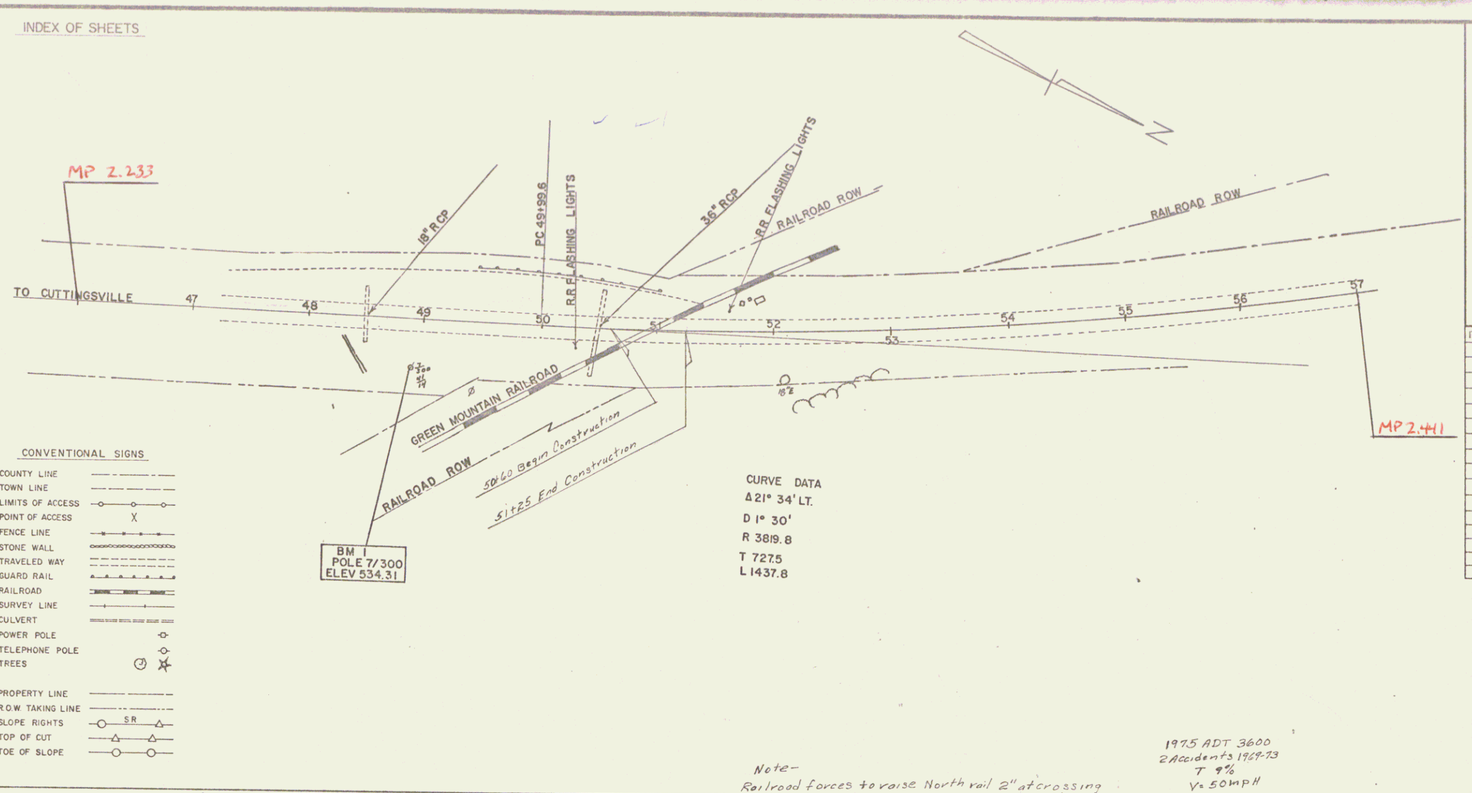

ITEM NO	ITEM	UNIT	NET		TOTAL	FINAL

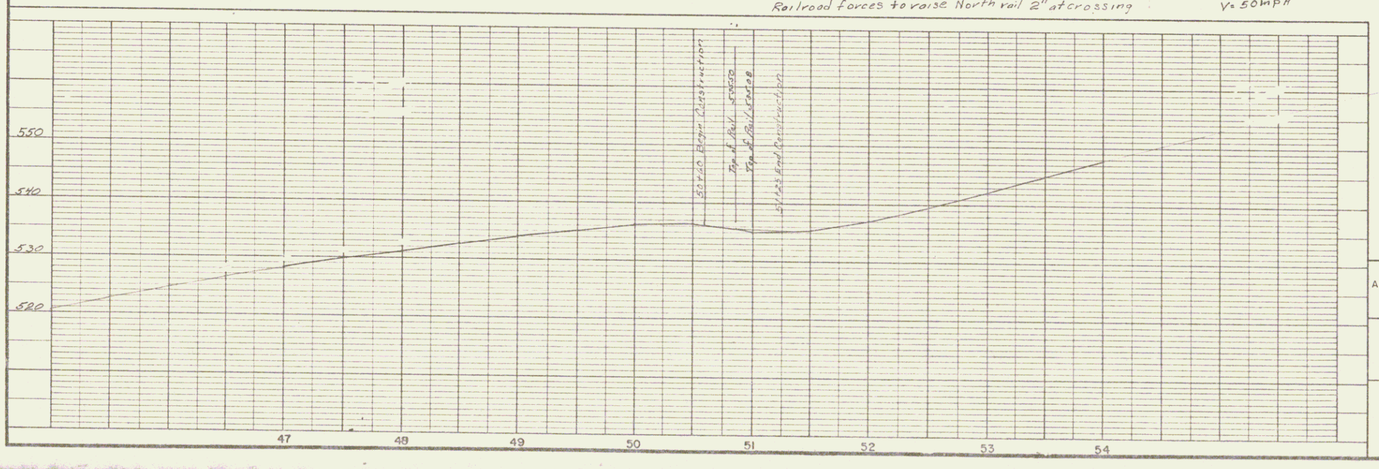

TYPICAL SECTION

Pin # 13R247

PRATT'S CROSSING

APPROVED R.O.W. DIRECTOR DATE 4-18-75

SUBMITTED BY ORDER OF THE STATE HIGHWAY BOARD

APPROVED CHIEF ENGINEER DATE 4-15-75

DEPARTMENT OF TRANSPORTATION
FEDERAL HIGHWAY ADMINISTRATION

APPROVED DIVISION ENGINEER DATE

STATE OF VERMONT
DEPARTMENT OF HIGHWAYS

TOWN OF SHREWSBURY ITE. NO. 103

DOT NO. CM 859 886Y

LOG STA. 2.33

SURV. STA

DESIGNED BY STEVENS DATE 1/10/75

DRAWN BY DATE

CHECKED BY DATE

Design Supervisor DATE

PROJECT SHREWSBURY PROJ. NO. RRS000S(3)

21