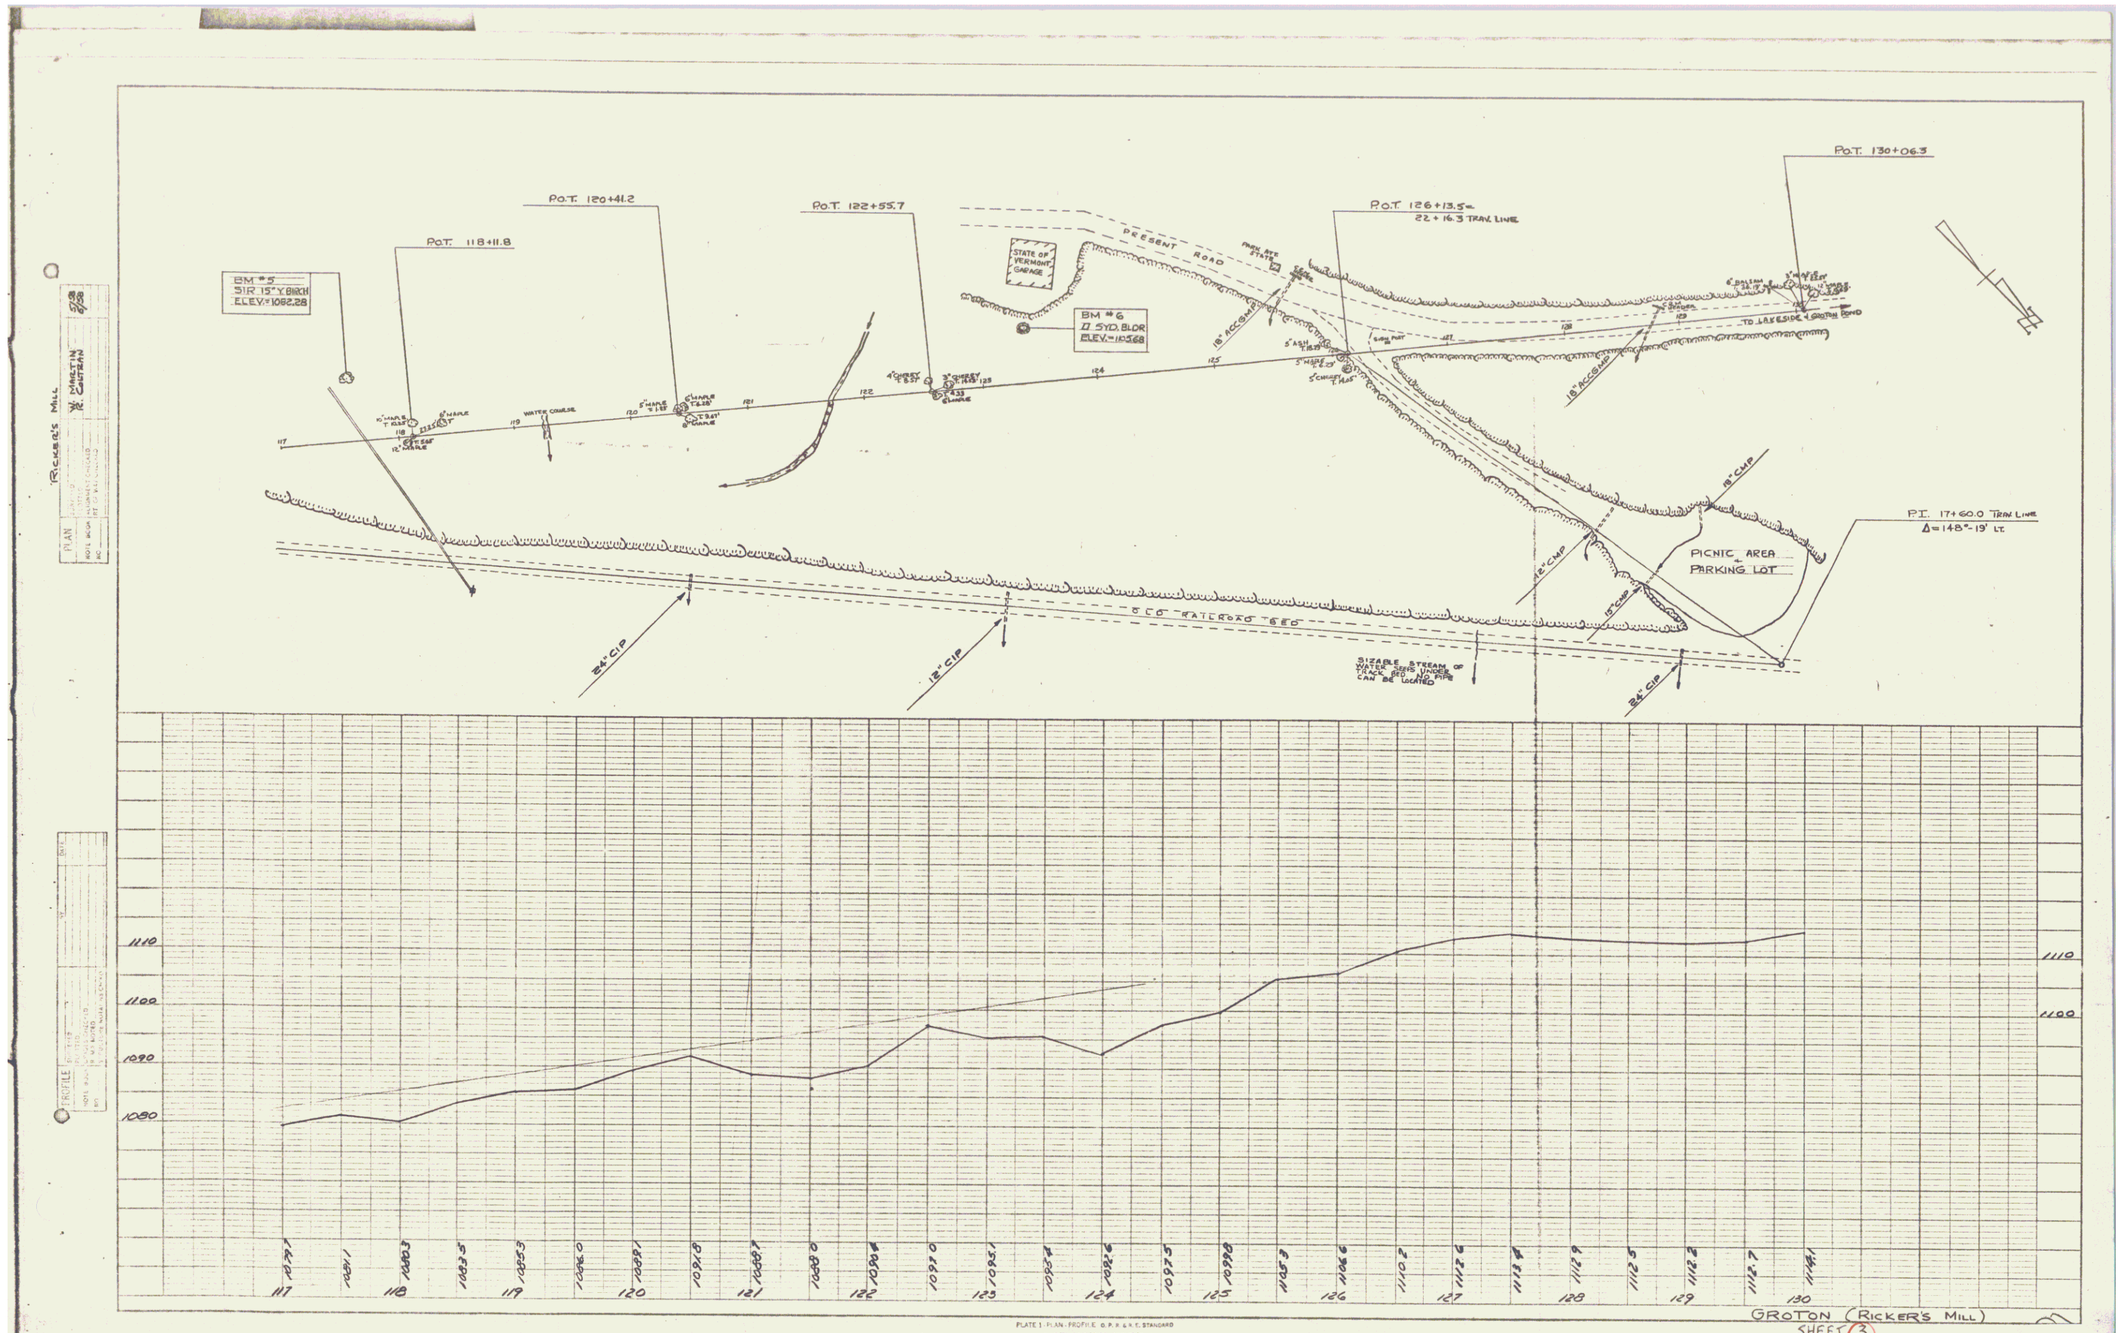

PLATE 1 - PLAN - PROFILE G.P.R.&R.T. STANDARD
KEUFFEL & ESSER CO. NEW YORK

3