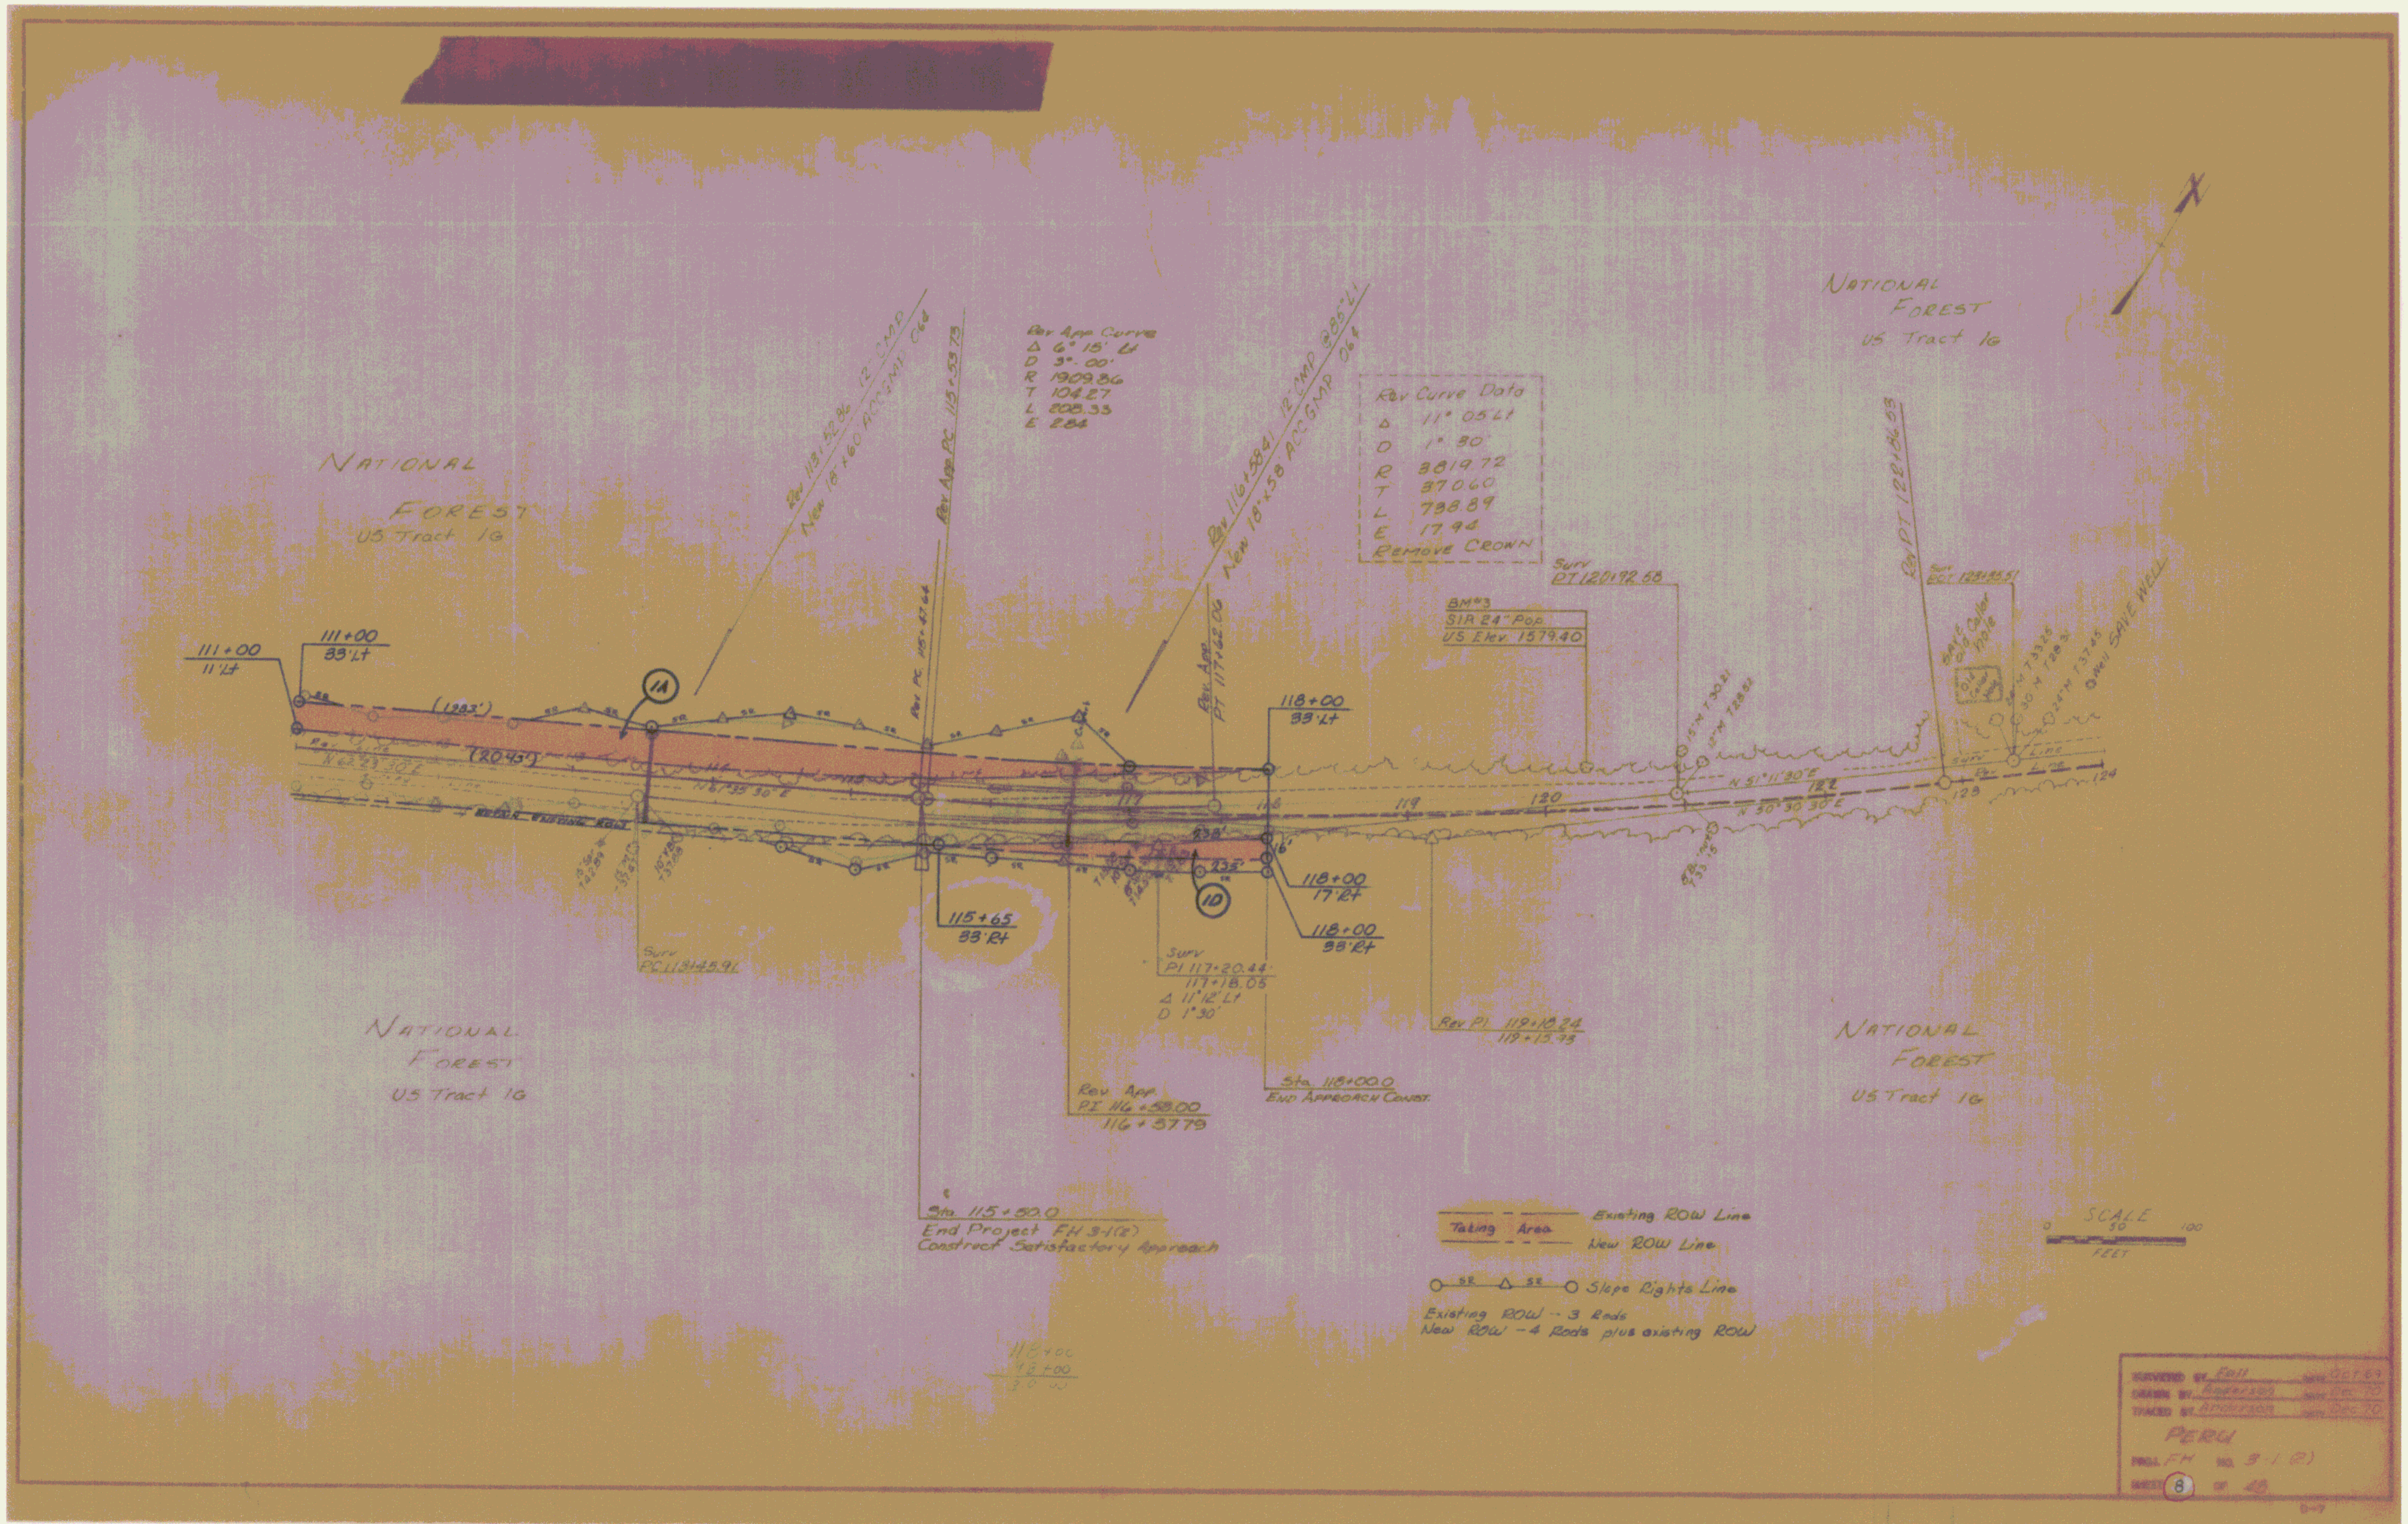
NATIONAL FOREST
US Tract 16
Rev App Curve
Δ 6° 15' Lt
D 3° 00'
R 1909.86
T 104.27
L 208.33
E 2.84
Rev Curve Data
Δ 11° 05' Lt
D 1° 30'
R 3819.72
T 370.60
L 738.89
E 17.94
Remove CROWN
Rev App PC 115+53.73
Rev 116+58.41 12" CMP @ 86° Lt
New 18"x 58' ACCGMP .064
BM#3
SIR 24" Pop
US Elev. 1579.40
111+00
11' Lt
111+00
33' Lt
118+00
33' Lt
118+00
17' Rt
118+00
33' Rt
115+65
33' Rt
Rev App
P.I. 116+58.00
116+57.79
Sta. 118+00.0
End Approach Const.
Sta. 115+50.0
End Project FH 3-1(2)
Construct Satisfactory Approach
Taking Area
Existing ROW Line
New ROW Line
Slope Rights Line
Existing ROW - 3 Rods
New ROW - 4 Rods plus existing ROW
SCALE
0 50 100
FEET
Peru
FH 3-1 (2)
8 of 48