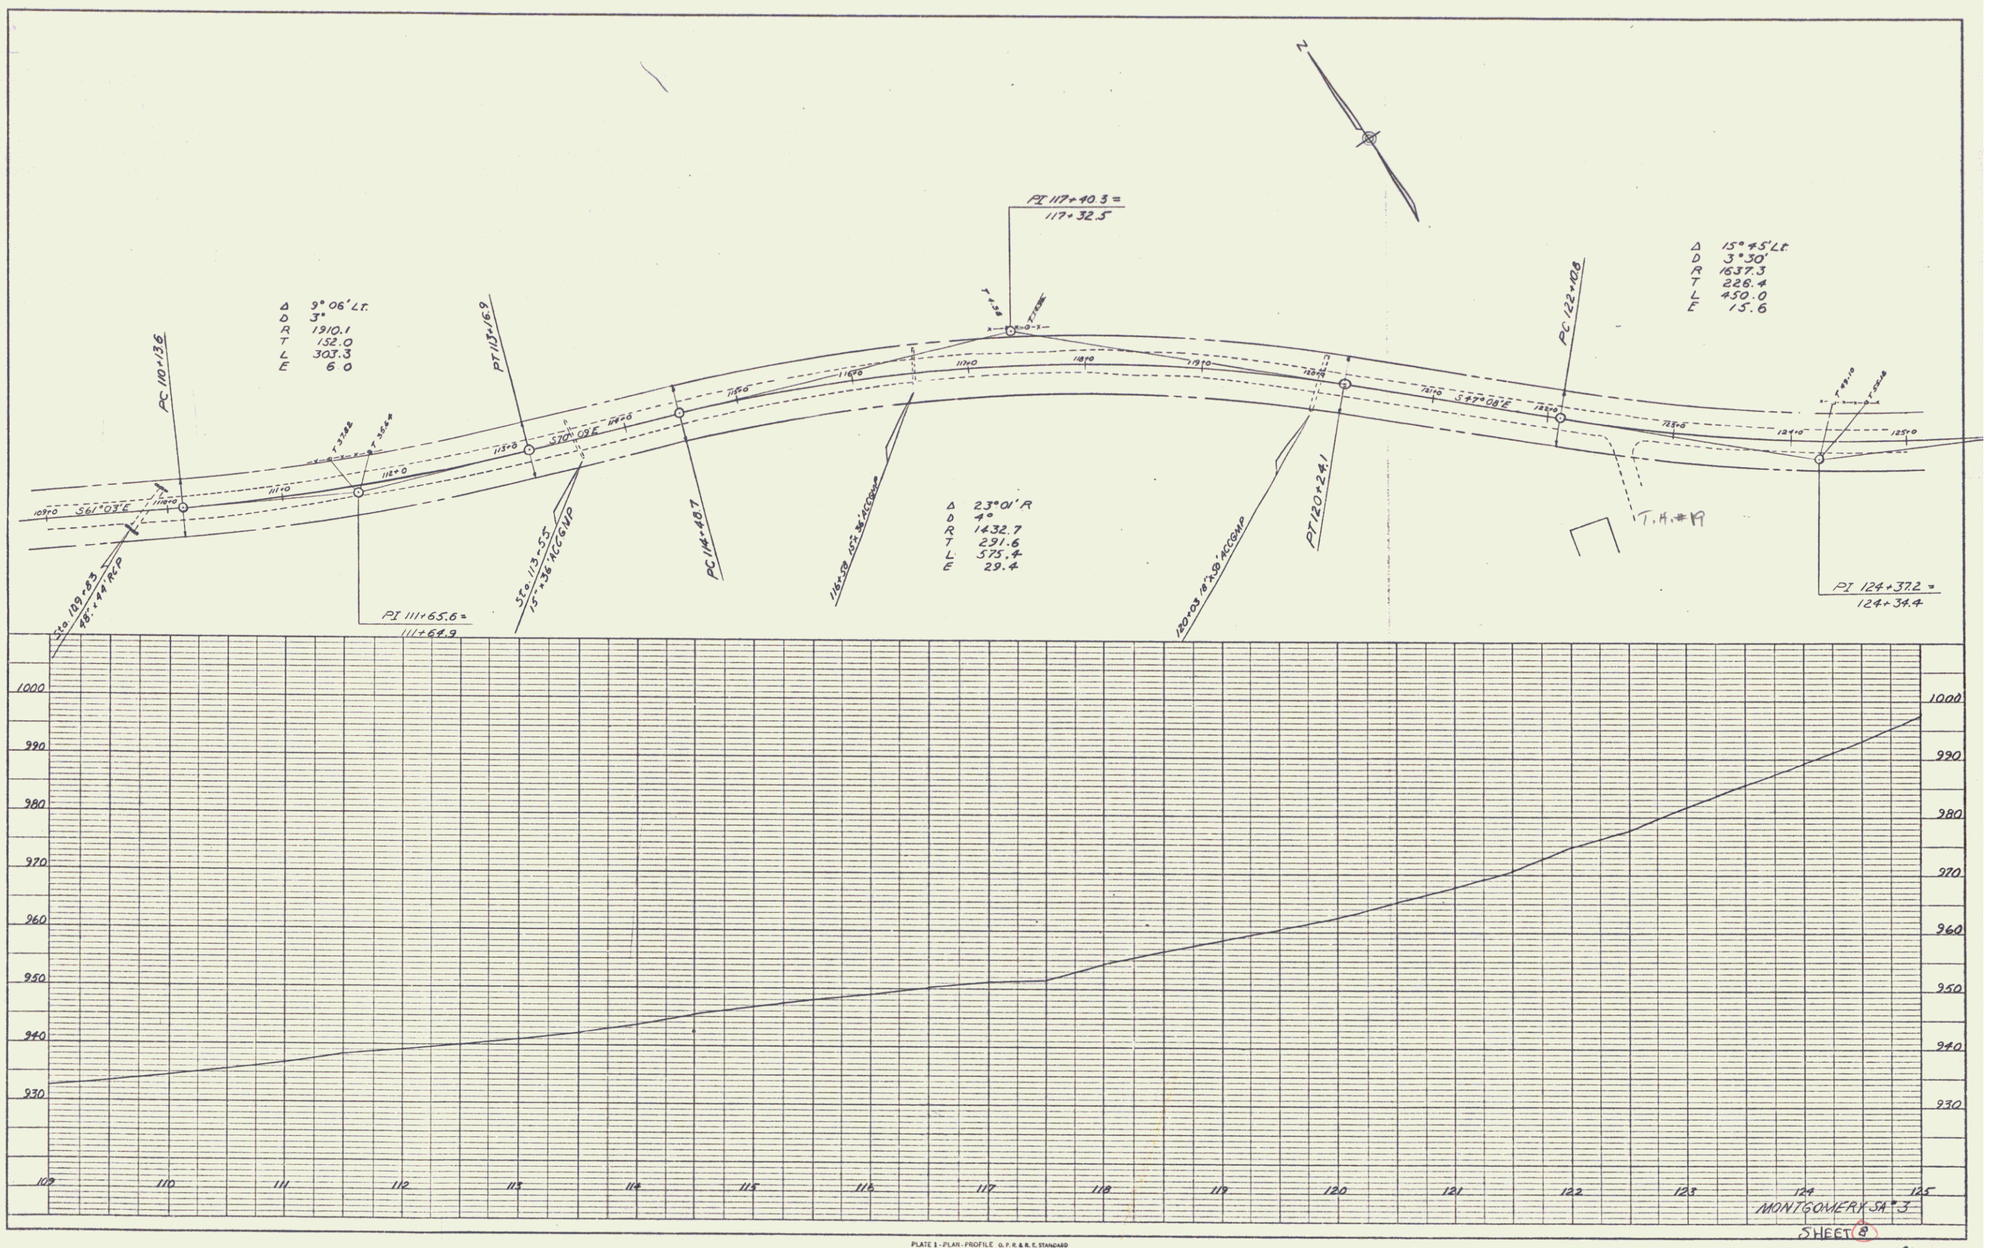

PLAN
SURVEYED
PLOTTED
NOTE BOOK ALIGNMENT CHECKED
R.E. INSPECTOR
NO. TRACED
BY Spaulding
DATE 1/11
BY Lane
DATE 1/11
BY S Murray
DATE 3/11

PROFILE
SURVEYED
PLOTTED
NOTE BOOK GRADES CHECKED
B.M. NOTED
NO. LETTERING (PLATING OVER)
BY Spaulding
DATE 1/11
BY Lane
DATE 1/11

PLATE 1 - PLAN - PROFILE O. P. R. & R. E. STANDARD
KEUFFEL & ESSER CO., NEW YORK.
K & E Co. No. 348-105
Sheet
Section Area
Section Area

8