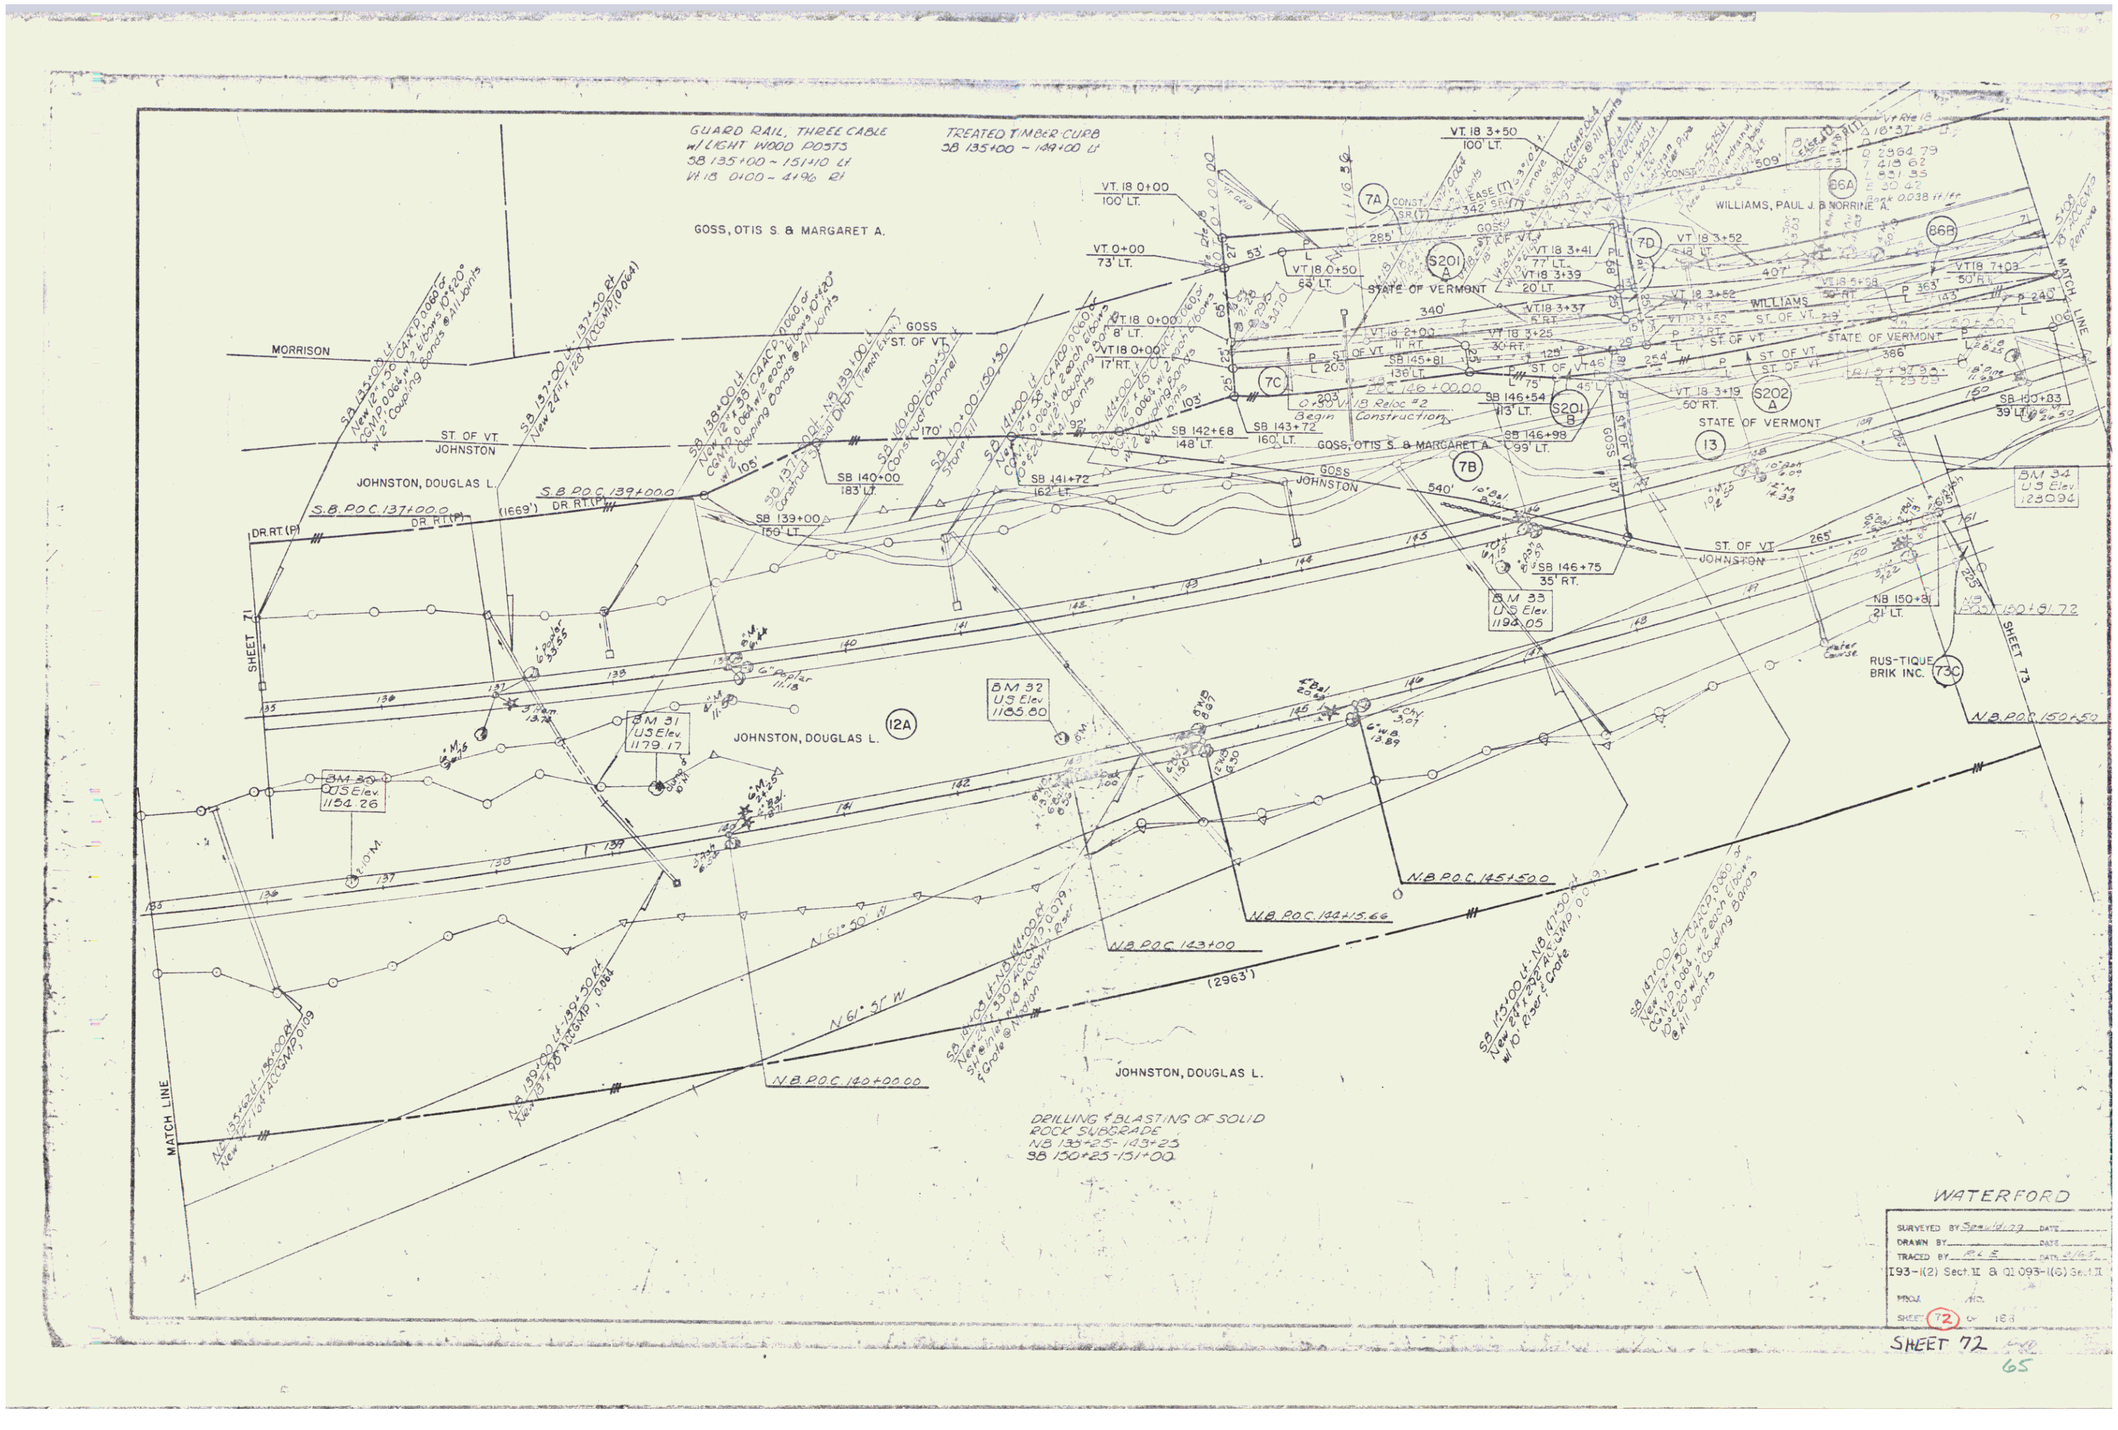
GUARD RAIL, THREE CABLE w/ LIGHT WOOD POSTS SB 135+00 ~ 151+10 Lt VT 18 0+00 ~ 4+96 Rt
TREATED TIMBER CURB SB 135+00 ~ 149+00 Lt
GOSS, OTIS S. & MARGARET A.
WILLIAMS, PAUL J. & NORRINE A.
STATE OF VERMONT
MORRISON
ST. OF VT. JOHNSTON
JOHNSTON, DOUGLAS L.
GOSS
ST. OF VT.
S.B. P.O.C. 137+00.0
S.B. P.O.C. 139+00.0
(1669') DR. RT. (P)
DR. RT. (P)
SHEET 71
SHEET 73
MATCH LINE
BM 31 US Elev 1179.17
BM 32 US Elev 1185.80
BM 33 US Elev 1192.05
BM 34 US Elev 1250.94
RUS-TIQUE BRIK INC.
Begin Construction
N.B. P.O.C. 140+00.00
N.B. P.O.C. 143+00
N.B. P.O.C. 145+50.0
N.B. P.O.C. 150+50
N 61° 50' W
N 61° 51' W
(2963')
DRILLING & BLASTING OF SOLID ROCK SUBGRADE
NB 135+25 - 143+25
SB 150+25 - 151+00
WATERFORD
I 93-1(2) Sect. 1Z & QI 093-1(6) Sect. 1I
SHEET 72 OF 163
SHEET 72
65