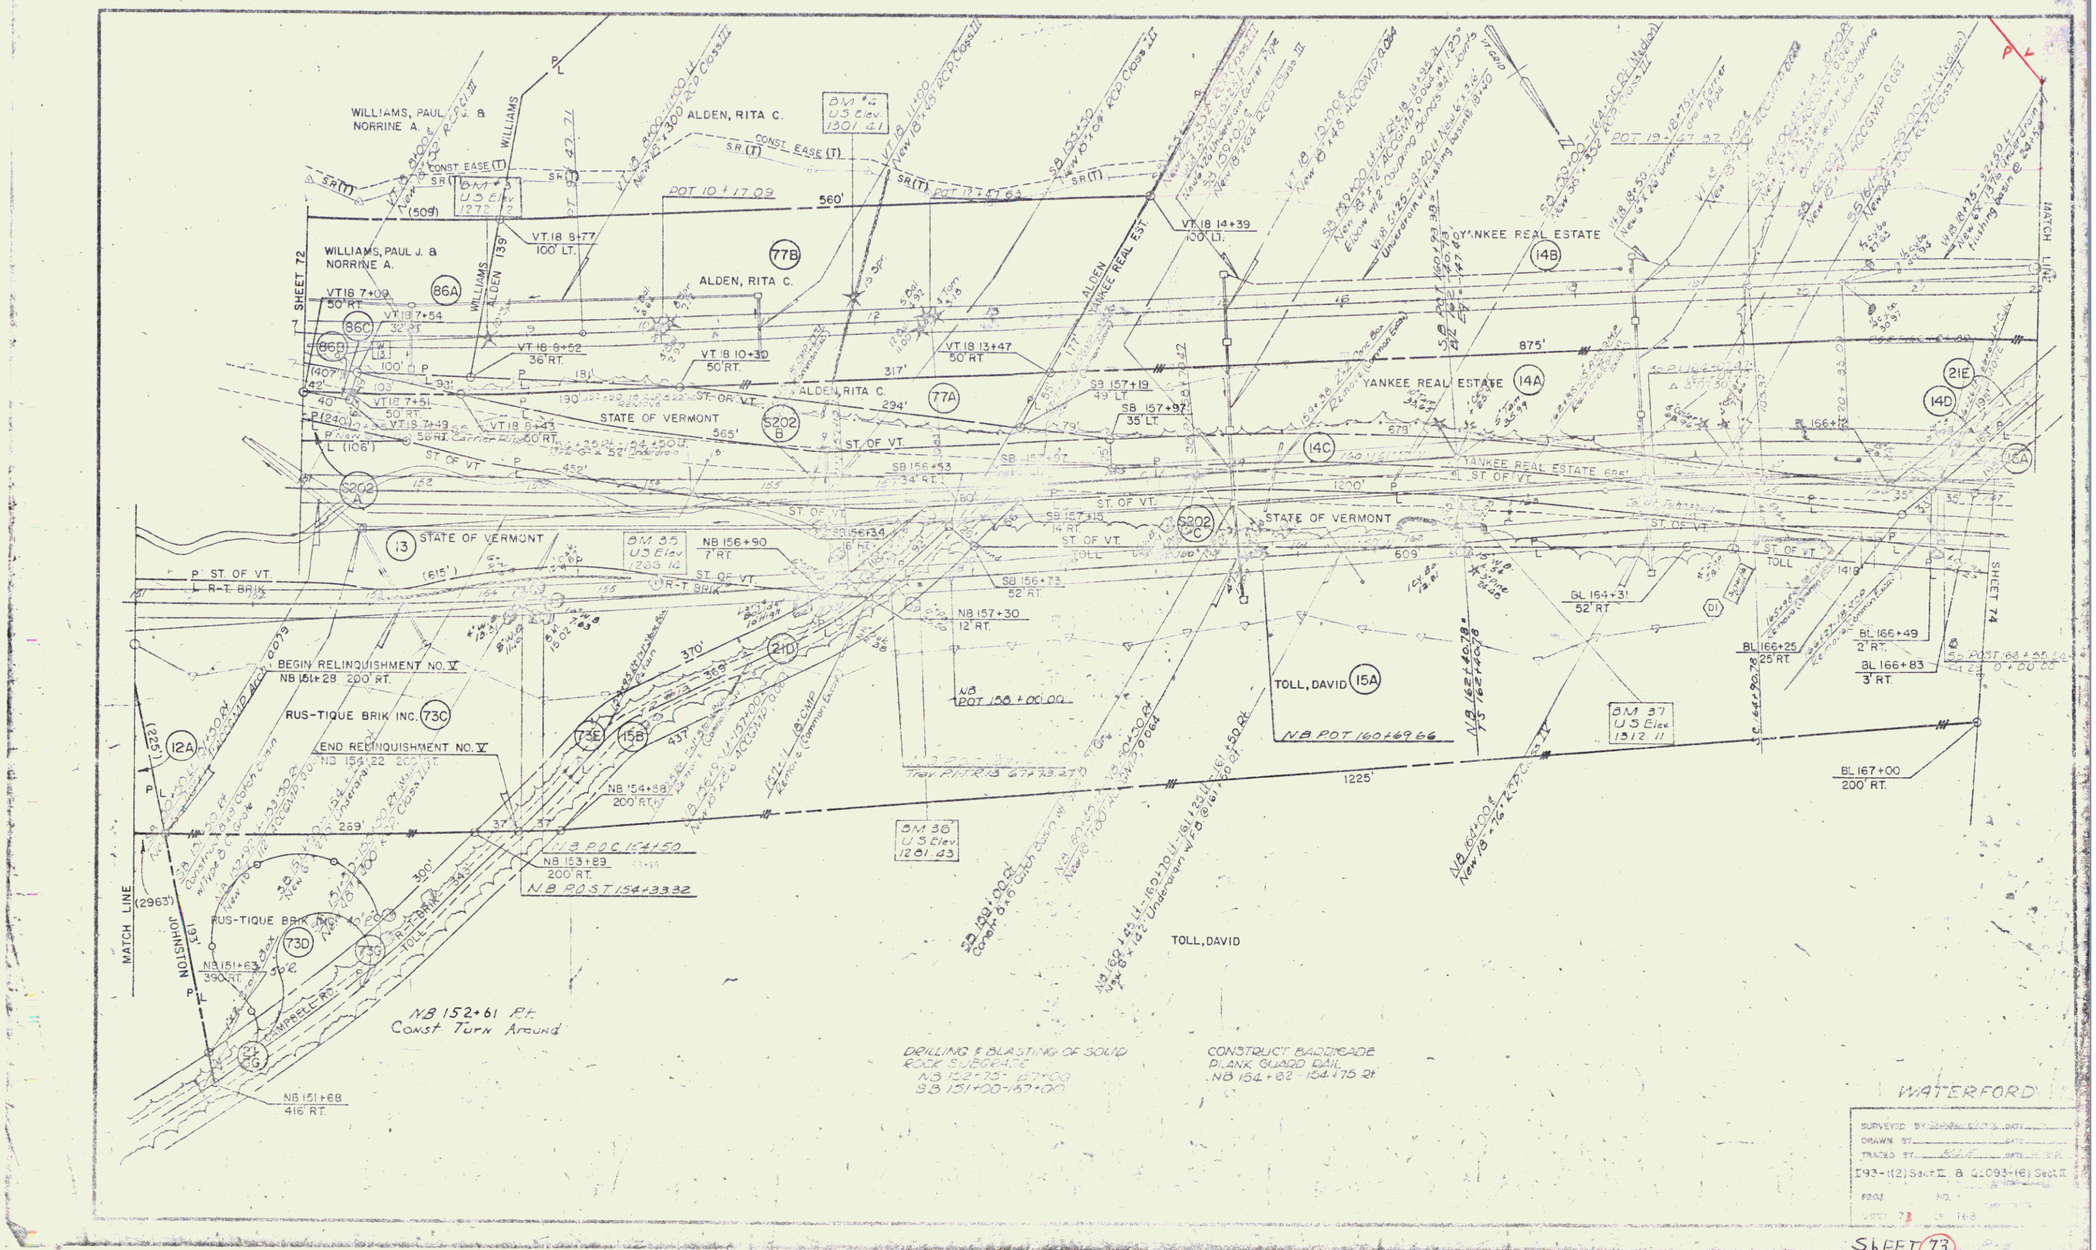
WILLIAMS, PAUL J. & NORRINE A.
ALDEN, RITA C.
YANKEE REAL ESTATE
STATE OF VERMONT
TOLL, DAVID
RUS-TIQUE BRIK INC.
BEGIN RELINQUISHMENT NO. V
END RELINQUISHMENT NO. V
SHEET 72
SHEET 74
MATCH LINE
NB 152+61 Rt.
Const Turn Around
DRILLING & BLASTING OF SOLID ROCK SUBGRADE
CONSTRUCT BARRICADE PLANK GUARD RAIL
WATERFORD
SHEET 73