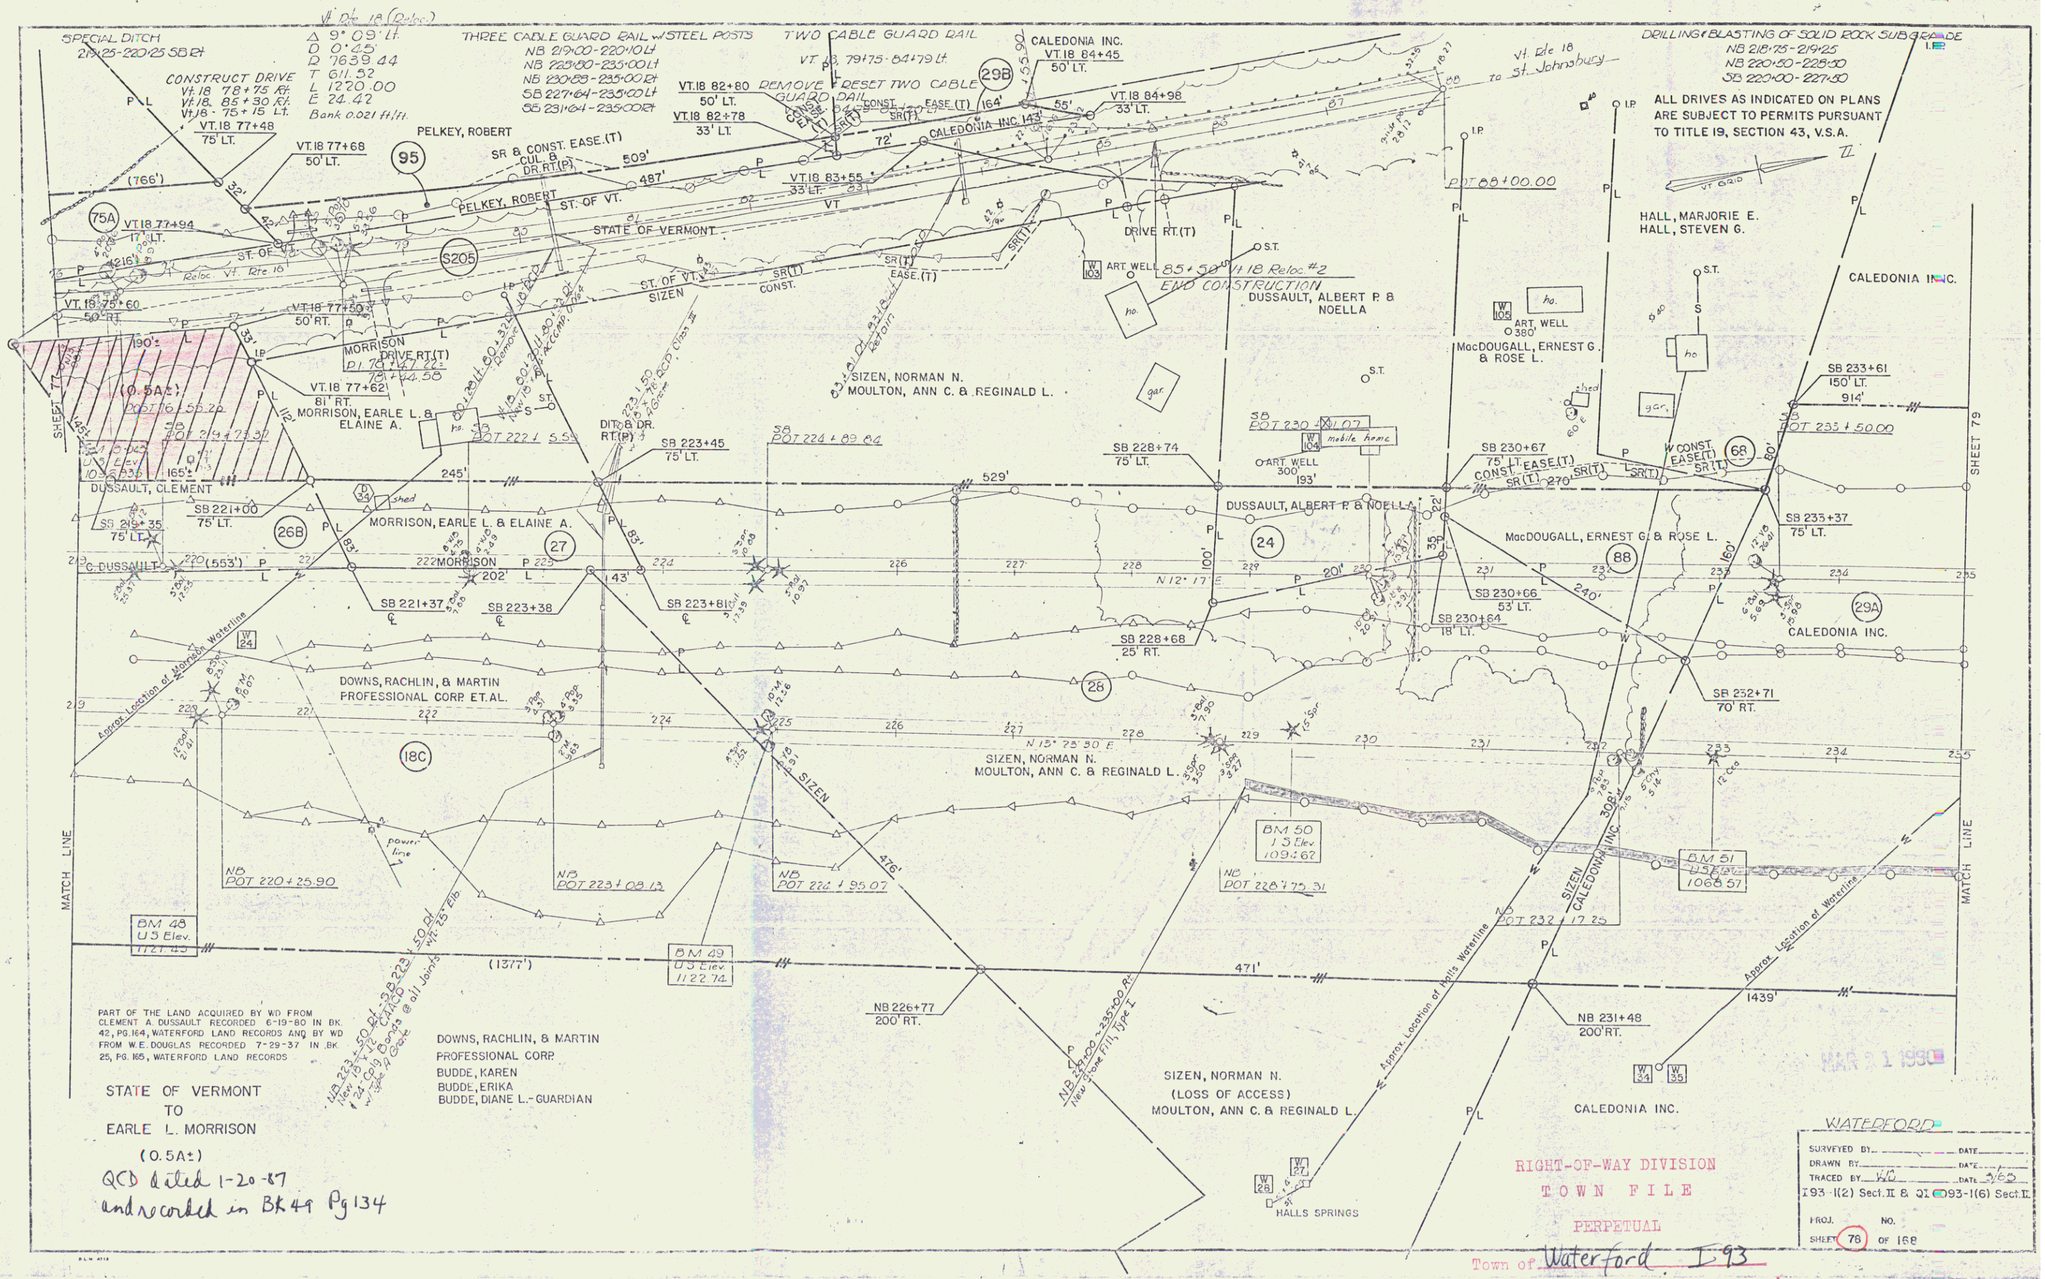
SPECIAL DITCH
CONSTRUCT DRIVE
THREE CABLE GUARD RAIL w/STEEL POSTS
TWO CABLE GUARD RAIL
REMOVE & RESET TWO CABLE GUARD RAIL
CALEDONIA INC.
PELKEY, ROBERT
STATE OF VERMONT
DRIVE RT.(T)
ART. WELL
END CONSTRUCTION
DUSSAULT, ALBERT P. & NOELLA
SIZEN, NORMAN N.
MOULTON, ANN C. & REGINALD L.
MORRISON, EARLE L. & ELAINE A.
DUSSAULT, CLEMENT
DOWNS, RACHLIN, & MARTIN PROFESSIONAL CORP. ET.AL.
MacDOUGALL, ERNEST G. & ROSE L.
HALL, MARJORIE E.
HALL, STEVEN G.
DRILLING & BLASTING OF SOLID ROCK SUBGRADE
ALL DRIVES AS INDICATED ON PLANS ARE SUBJECT TO PERMITS PURSUANT TO TITLE 19, SECTION 43, V.S.A.
MATCH LINE
SHEET 79
BM 48 U.S. Elev. 1121.45
BM 49 U.S. Elev. 1122.74
BM 50 U.S. Elev. 1091.62
BM 51 U.S. Elev. 1068.51
HALLS SPRINGS
PART OF THE LAND ACQUIRED BY WD FROM CLEMENT A. DUSSAULT RECORDED 6-19-80 IN BK. 42, PG. 164, WATERFORD LAND RECORDS AND BY WD FROM W.E. DOUGLAS RECORDED 7-29-37 IN BK. 25, PG. 165, WATERFORD LAND RECORDS
STATE OF VERMONT
TO
EARLE L. MORRISON
(0.5A±)
QCD filed 1-20-87
and recorded in Bk 49 Pg 134
DOWNS, RACHLIN, & MARTIN PROFESSIONAL CORP.
BUDDE, KAREN
BUDDE, ERIKA
BUDDE, DIANE L.-GUARDIAN
SIZEN, NORMAN N.
(LOSS OF ACCESS)
MOULTON, ANN C. & REGINALD L.
CALEDONIA INC.
RIGHT-OF-WAY DIVISION
TOWN FILE
PERPETUAL
Town of Waterford I 93
WATERFORD
SURVEYED BY
DRAWN BY
TRACED BY WD
I 93-1(2) Sect. II & QI 093-1(6) Sect. II
PROJ. NO.
SHEET 78 OF 168
MAR 21 1990