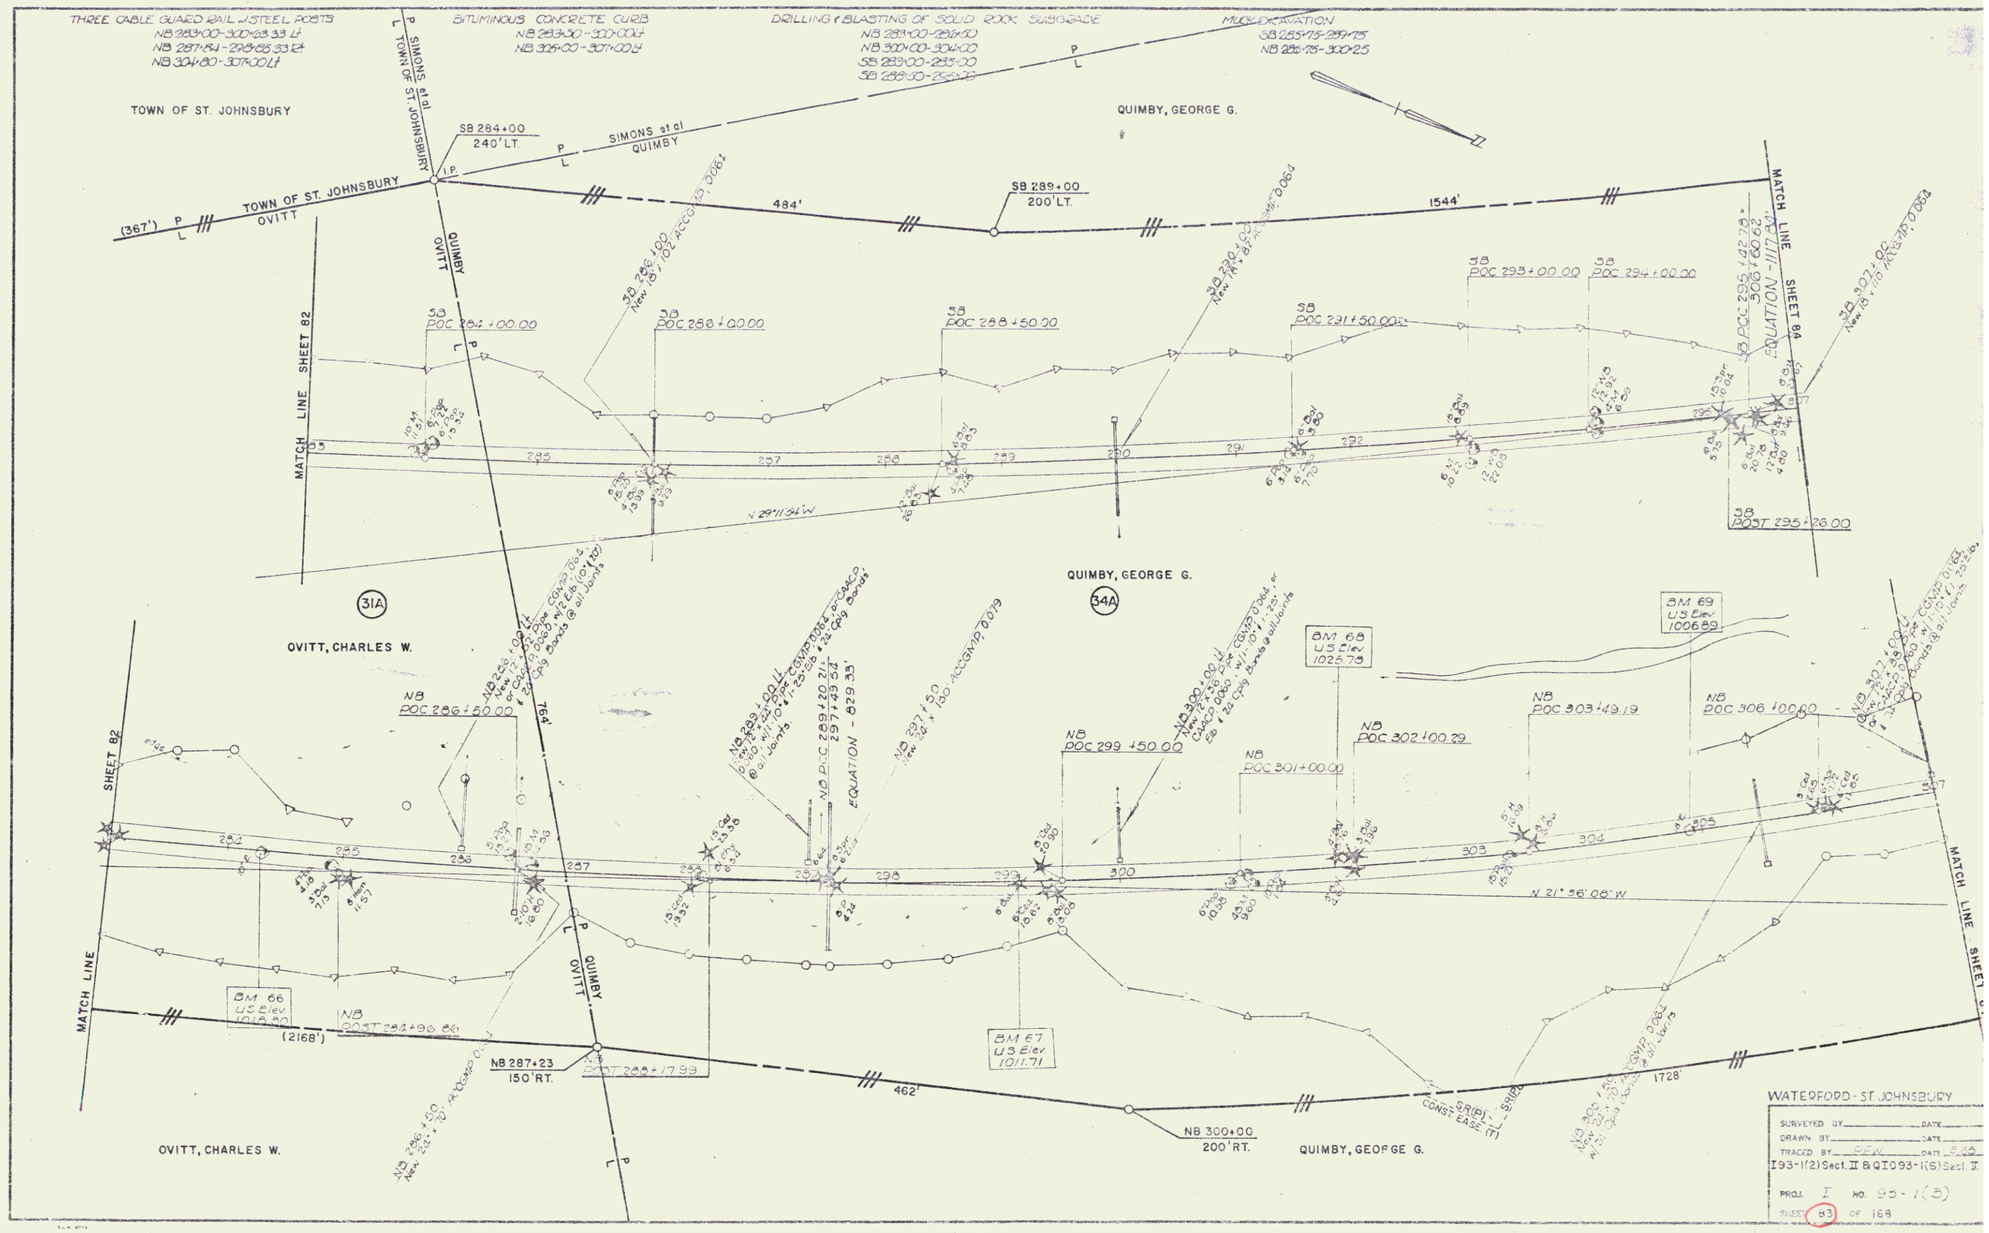
THREE CABLE GUARD RAIL W/STEEL POSTS
NB 283+00-300+83.33 LT
NB 287+84-298+85.33 RT
NB 304+80-307+00 LT
BITUMINOUS CONCRETE CURB
NB 283+00-300+00 LT
NB 326+00-307+00 LT
DRILLING & BLASTING OF SOLID ROCK SUBGRADE
NB 283+00-295+00
NB 300+00-304+00
SB 283+00-285+00
SB 288+00-295+75
MUCK EXCAVATION
SB 285+75-289+75
NB 298+75-300+25
TOWN OF ST. JOHNSBURY
QUIMBY, GEORGE G.
SB 284+00
240' LT.
SIMONS et al
QUIMBY
TOWN OF ST. JOHNSBURY
OVITT
(367')
484'
SB 289+00
200' LT.
1544'
MATCH LINE SHEET 84
MATCH LINE SHEET 82
SB POC 284+00.00
SB POC 286+00.00
SB POC 288+50.00
SB POC 291+50.00
SB POC 293+00.00
SB POC 294+00.00
SB POST 295+26.00
EQUATION - 1172.32
N 29°11'34" W
31A
OVITT, CHARLES W.
34A
QUIMBY, GEORGE G.
BM 68
US Elev
1025.75
BM 69
US Elev
1006.89
NB POC 286+50.00
NB POC 299+50.00
NB POC 301+00.00
NB POC 302+00.29
NB POC 303+49.19
NB POC 306+00.00
EQUATION - 829.33
764'
N 21°36'08" W
BM 66
US Elev
1014.80
(2168')
NB POST 284+96.86
NB 287+23
150' RT.
NB POST 288+17.99
BM 67
US Elev
1011.71
462'
NB 300+00
200' RT.
1728'
OVITT, CHARLES W.
QUIMBY, GEORGE G.
WATERFORD - ST. JOHNSBURY
SURVEYED BY
DATE
DRAWN BY
DATE
TRACED BY
DATE
I93-1(2)Sect.II & QI093-1(5)Sect.II
PROJ. I NO. 93-1(3)
SHEET 83 OF 168

76