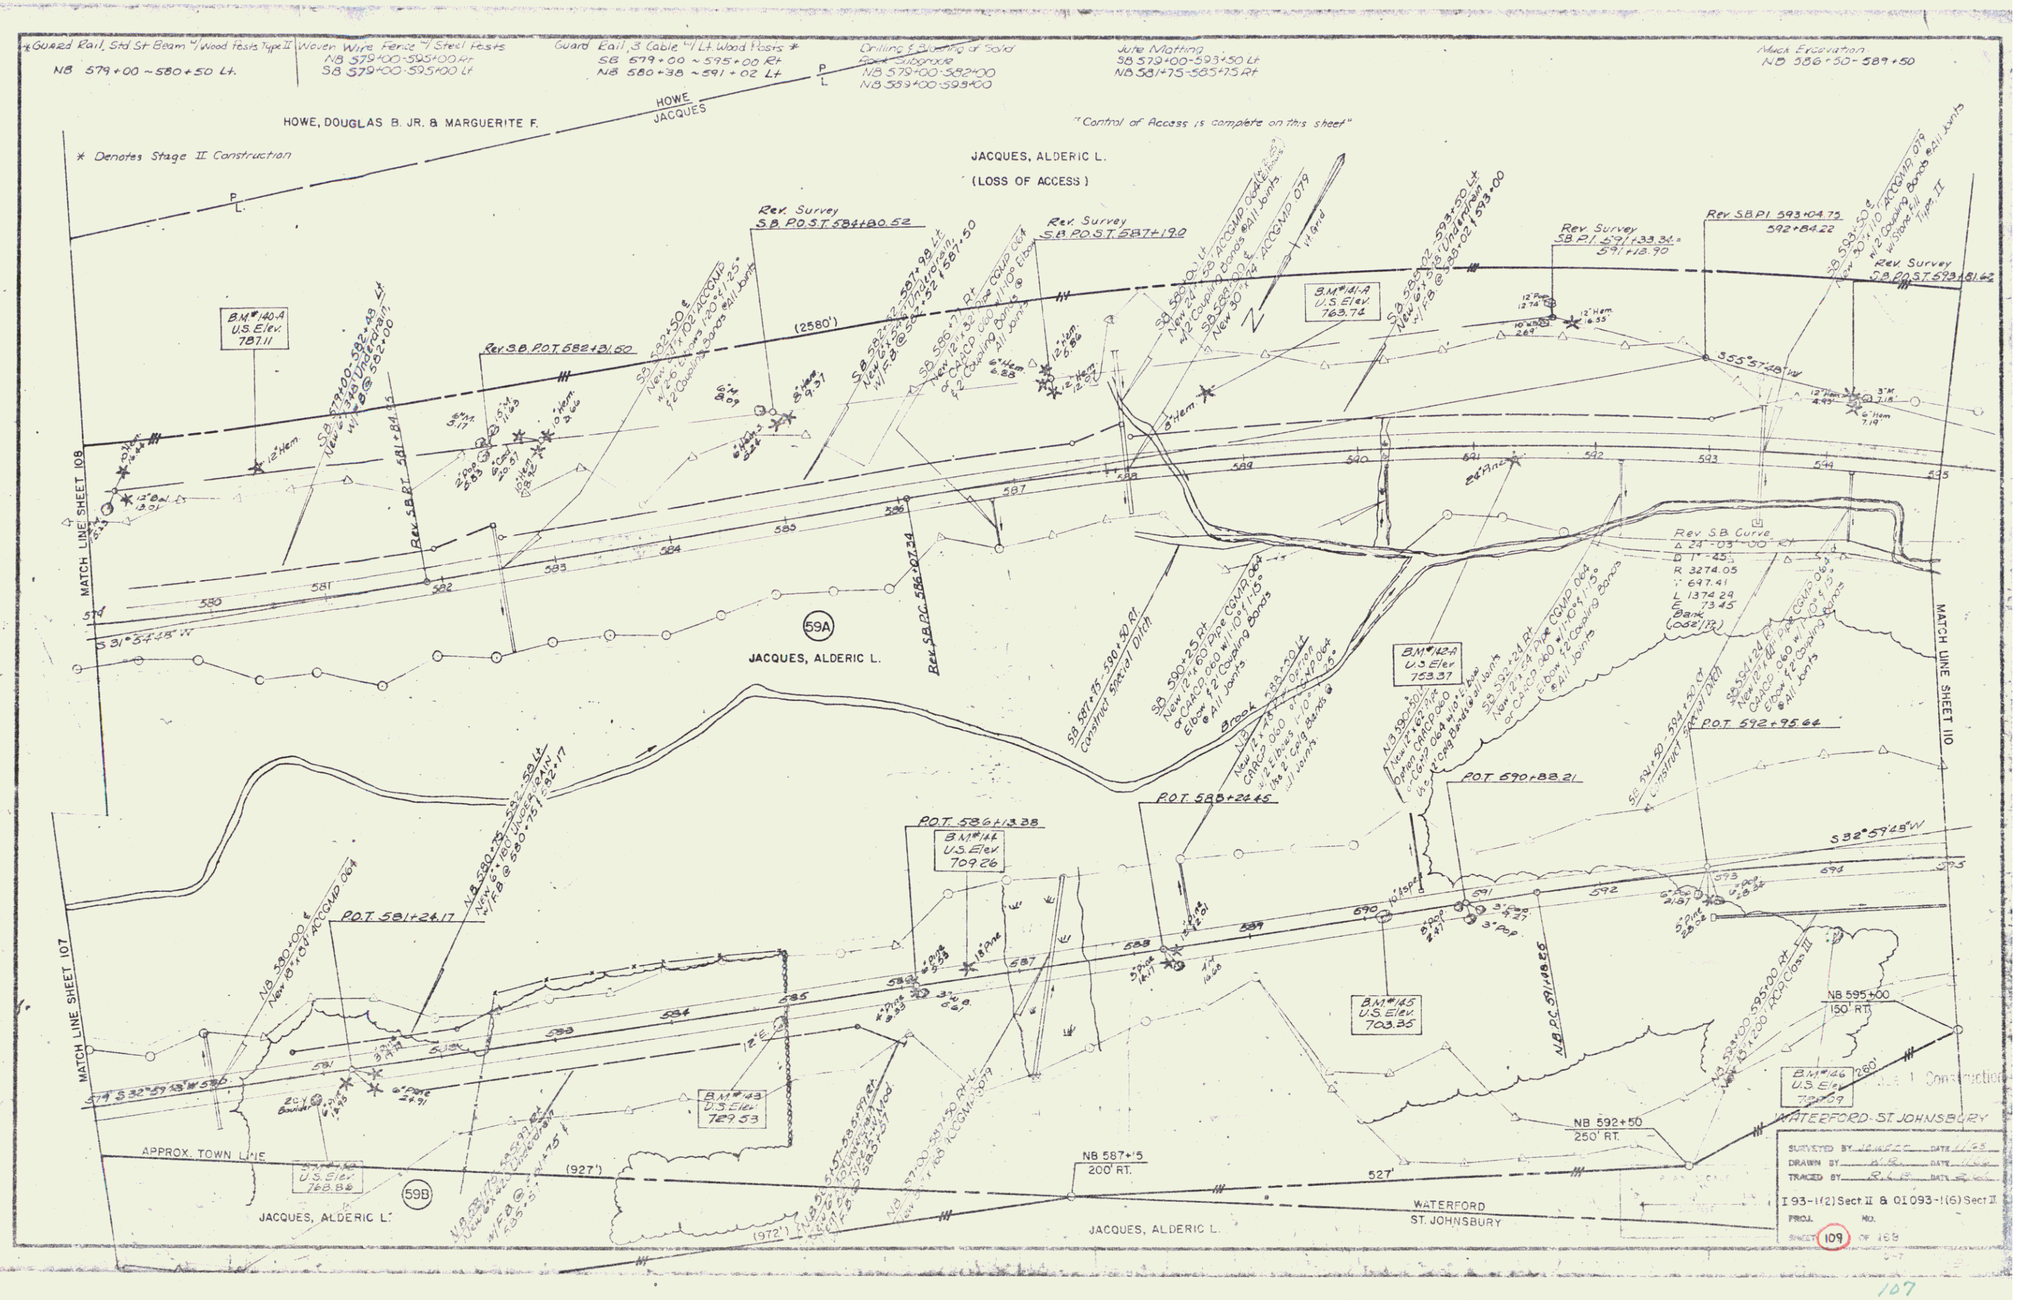
Guard Rail, Std Sr Beam w/ Wood Posts Type II
NB 579+00 - 580+50 Lt.
Woven Wire Fence w/ Steel Posts
NB 579+00 - 595+00 Rt
SB 579+00 - 595+00 Lt
Guard Rail, 3 Cable w/ Lt. Wood Posts *
SB 579+00 - 595+00 Rt
NB 580+38 - 591+02 Lt
Drilling & Blasting of Solid Rock Subgrade
NB 579+00 - 582+00
NB 589+00 - 595+00
Jute Matting
SB 579+00 - 593+50 Lt
NB 581+75 - 585+75 Rt
Muck Excavation
NB 586+50 - 589+50
HOWE, DOUGLAS B. JR. & MARGUERITE F.
HOWE
JACQUES
* Denotes Stage II Construction
"Control of Access is complete on this sheet"
JACQUES, ALDERIC L.
(LOSS OF ACCESS)
Rev. Survey
S.B. P.O.S.T. 584+80.52
Rev. Survey
S.B. P.O.S.T. 587+19.0
Rev. Survey
S.B. P.I. 591+33.34
591+18.90
Rev. S.B. P.I. 593+04.75
592+84.22
Rev. Survey
S.B. P.O.S.T. 593+81.62
Rev. S.B. P.O.T. 582+31.50
(2580')
B.M. #140-A
U.S. Elev.
787.11
B.M. #141-A
U.S. Elev.
763.74
B.M. #142-A
U.S. Elev.
753.37
B.M. #143
U.S. Elev.
729.53
B.M. #144
U.S. Elev.
709.26
B.M. #145
U.S. Elev.
703.35
B.M. #146
U.S. Elev.
729.57
Rev. S.B. P.O.T. 581+84.12
Rev. S.B. P.O.T. 586+07.24
Rev. S.B. P.C. 586+02.34
Rev. S.B. Curve
Δ 24°-03'-00" Rt
D 1°-45'
R 3274.05
T 697.41
L 1374.29
E 73.45
Bank (002/12)
S 31°54'48" W
S 32°59'48" W
N.B. P.C. 591+18.25
P.O.T. 581+26.17
P.O.T. 583+13.38
P.O.T. 585+24.45
P.O.T. 590+88.21
P.O.T. 592+95.64
MATCH LINE SHEET 108
MATCH LINE SHEET 107
MATCH LINE SHEET 110
59A
59B
APPROX. TOWN LINE
(927')
(972')
527'
NB 587+15
200' RT.
NB 592+50
250' RT.
NB 595+00
150' RT.
WATERFORD
ST. JOHNSBURY
WATERFORD-ST. JOHNSBURY
I 93-1(2) Sect II & QI 093-1(6) Sect II
PROJ. NO.
SHEET 109 OF 169

107