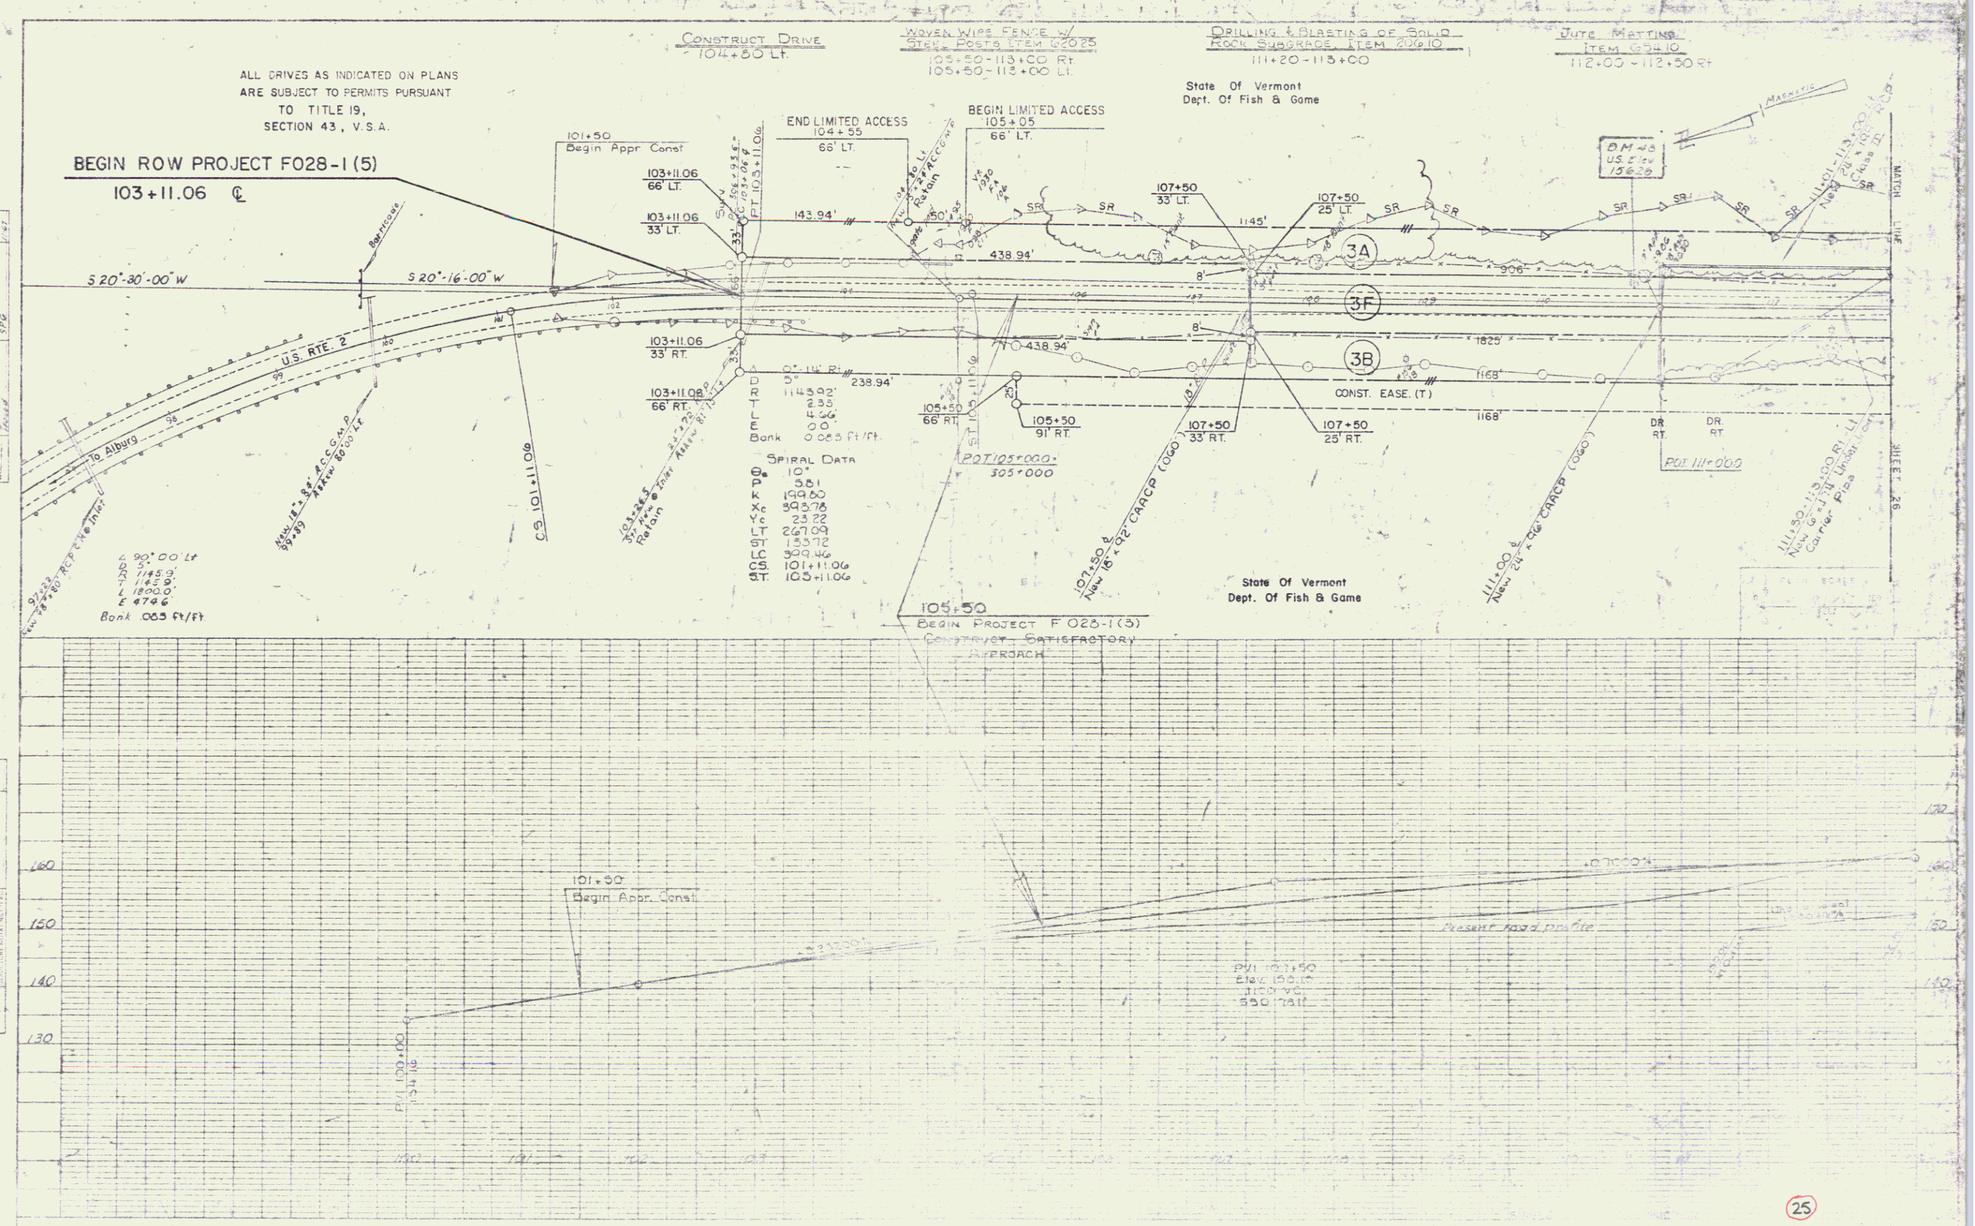
ALL DRIVES AS INDICATED ON PLANS
ARE SUBJECT TO PERMITS PURSUANT
TO TITLE 19,
SECTION 43, V.S.A.
BEGIN ROW PROJECT F028-1(5)
103+11.06 ℄
CONSTRUCT DRIVE
104+80 LT.
WOVEN WIRE FENCE W/
STEEL POSTS ITEM 62025
105+50-113+00 RT.
105+50-113+00 LT.
DRILLING & BLASTING OF SOLID
ROCK SUBGRADE, ITEM 206.10
111+20-113+00
JUTE MATTING
ITEM 654.10
112+00-112+50 RT
State Of Vermont
Dept. Of Fish & Game
END LIMITED ACCESS
104+55
66' LT.
BEGIN LIMITED ACCESS
105+05
66' LT.
101+50
Begin Appr. Const
S 20°-30'-00" W
S 20°-16'-00" W
U.S. RTE 2
To Alburg
Barricade
103+11.06
66' LT.
103+11.06
33' LT.
143.94'
438.94'
107+50
33' LT.
107+50
25' LT.
1145'
3A
3F
3B
906'
1825'
1168'
CONST. EASE. (T)
103+11.06
33' RT.
103+11.06
66' RT.
238.94'
105+50
66' RT.
105+50
91' RT.
107+50
33' RT.
107+50
25' RT.
DR. RT.
POT 105+000
305+000
POT 111+000
BM 48
US Elev
156.28
MAGNETIC
MATCH LINE
SHEET 26
SPIRAL DATA
Δ 90°-00' Lt
D 5°
R 1145.9'
T 1145.9'
L 1800.0'
E 474.6'
Bank .065 ft/ft
Δ 0°-11' Rt
D 5°
R 1145.92'
T 2.35'
L 4.66'
E 0.01'
Bank 0.065 ft/ft
SPIRAL DATA
Θs 10°
p 3.81
k 199.60
Xc 398.78
Yc 23.22
LT 267.09
ST 135.72
LC 399.46
CS. 101+11.06
ST. 105+11.06
CS 101+101.06
105+50
BEGIN PROJECT F 028-1(5)
CONTRACT SATISFACTORY
APPROACH
State Of Vermont
Dept. Of Fish & Game
101+50
Begin Appr. Const
Present Road Profile
PVI 101+50
Elev. 150.16
+100 VC
330' Tall
PVI 109+50
Elev. 134.16
160
150
140
130
25