CONSTRUCT APPROACH
Rev. T.R. 58 11+65 Lt.

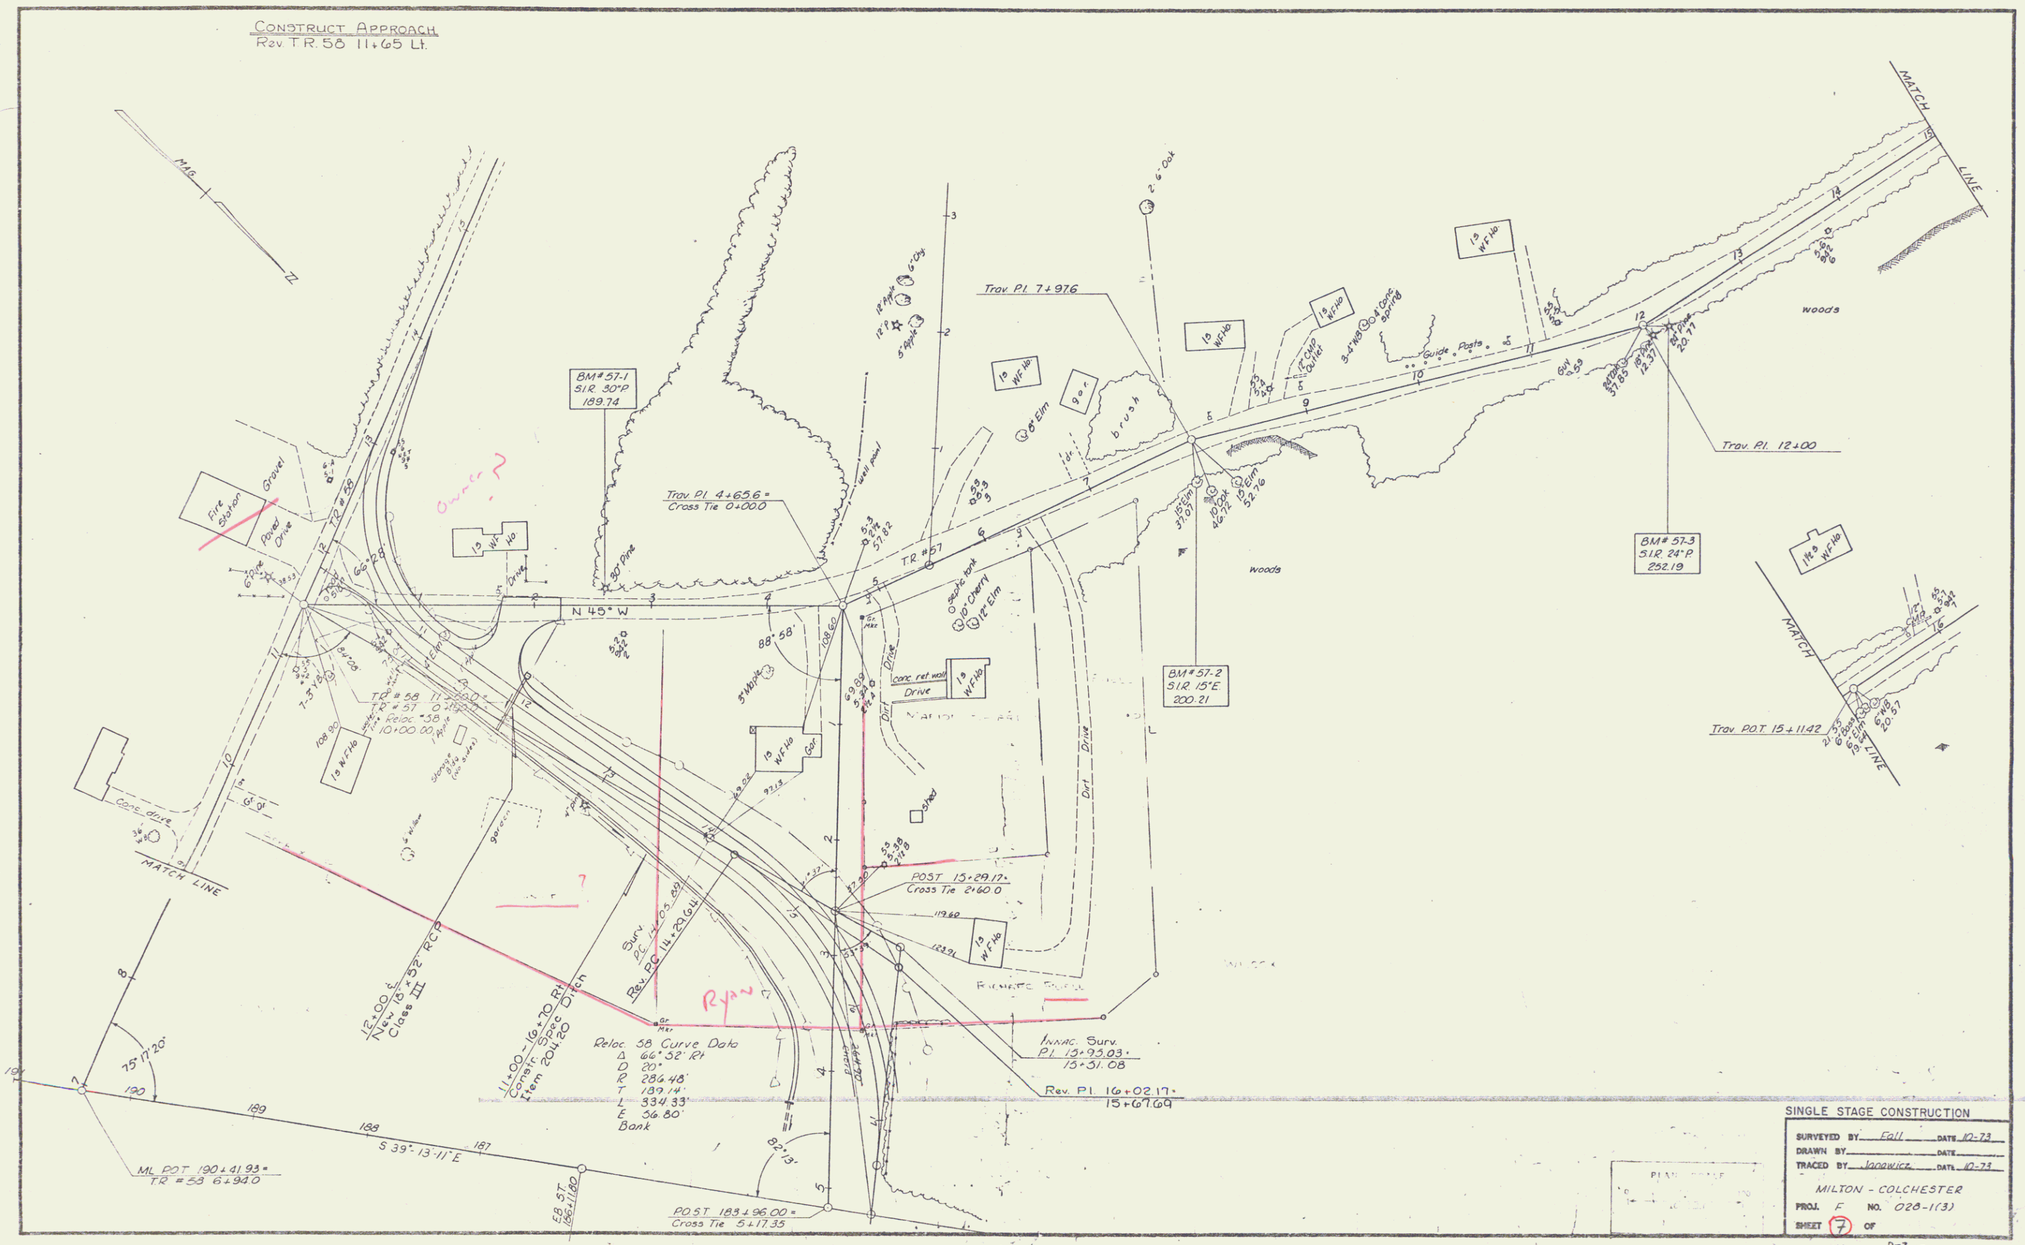

SINGLE STAGE CONSTRUCTION

SURVEYED BY Fall DATE 10-73
DRAWN BY DATE
TRACED BY Woodwick DATE 10-73

MILTON - COLCHESTER
PROJ. F NO. 028-1(13)
SHEET 7 OF

D-7 17

26