US 7
SUNDERLAND — MANCHESTER

INDEX OF SHEETS

STATE OF VERMONT
DEPARTMENT OF HIGHWAYS

PROPOSED IMPROVEMENT

TOWNS OF SUNDERLAND-MANCHESTER
COUNTY OF BENNINGTON
U.S. ROUTE 7

BEGINNING AT A POINT 1.723 MILES NORTHEASTERLY OF THE EASTERNMOST SUNDERLAND TOWN LINE AND PROCEEDING NORTHEASTERLY 0.936 MILES

LENGTH OF ROW 5614.5 FEET = 10.643 MILES
LENGTH OF BRIDGES 116.0 FEET = 0.022 MILES
LENGTH OF PROJECT 54,175 FEET = 10.258 MILES

Project F 019-1(9) Cont 1 & 2 ROWS

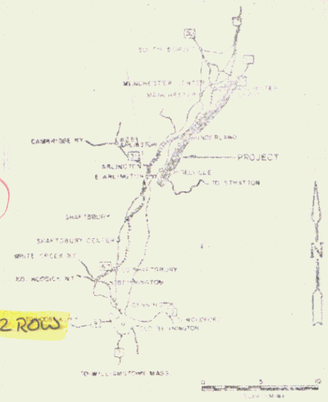
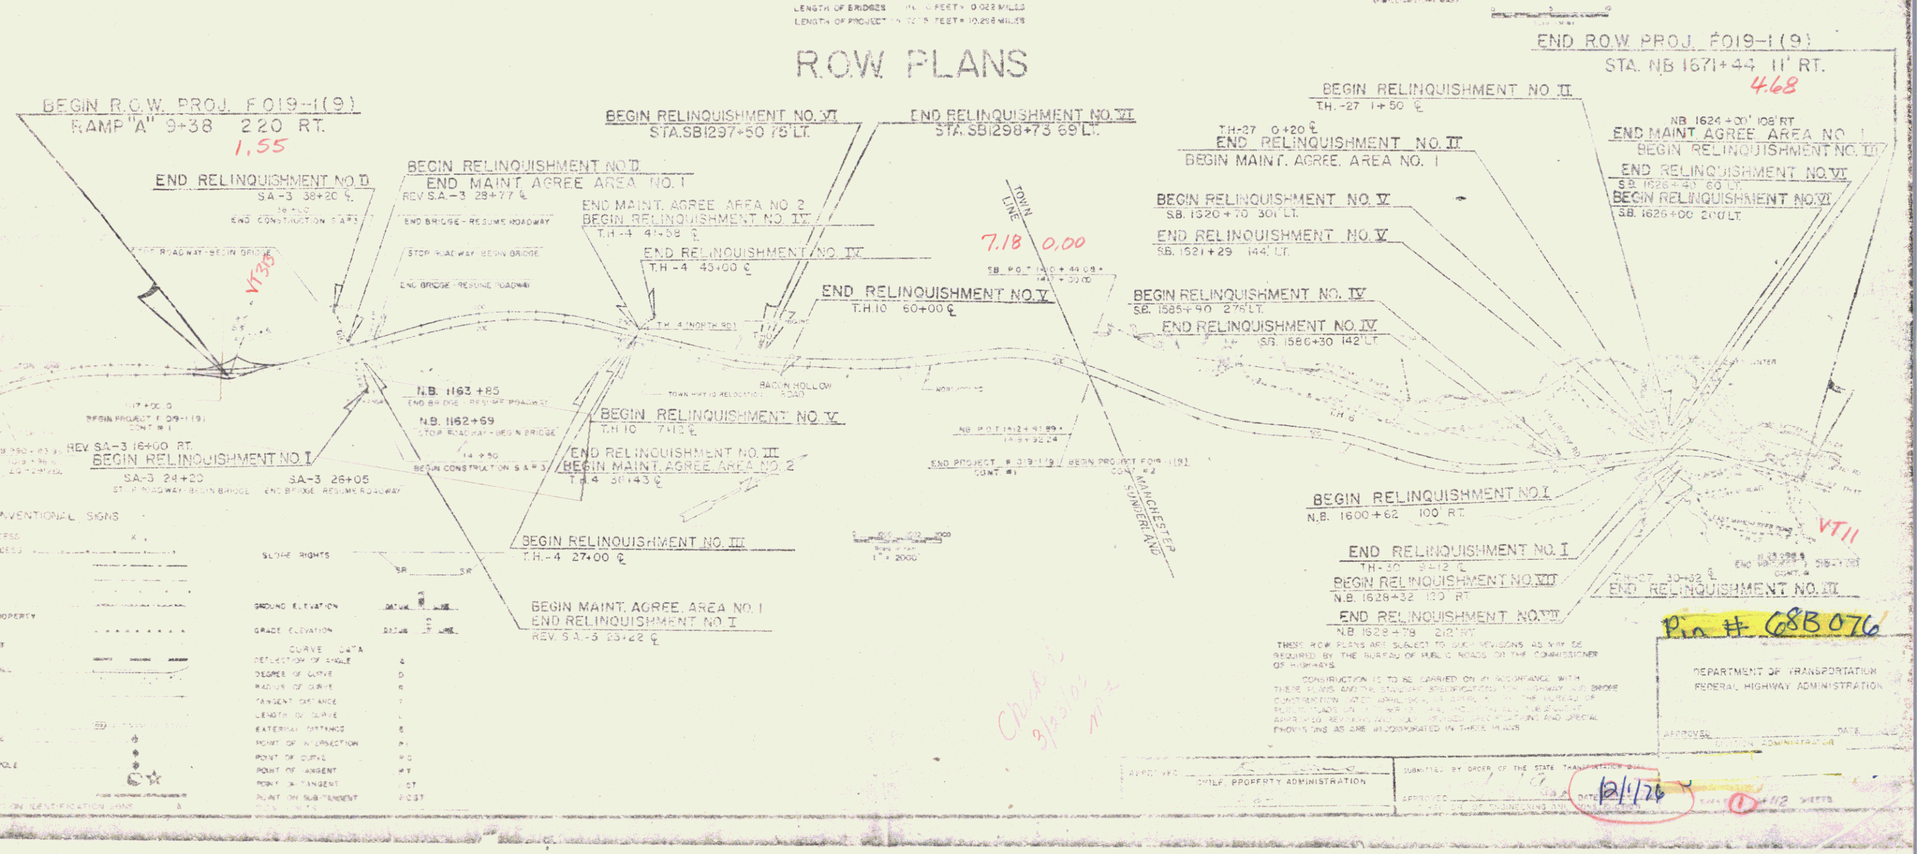
R.O.W. PLANS