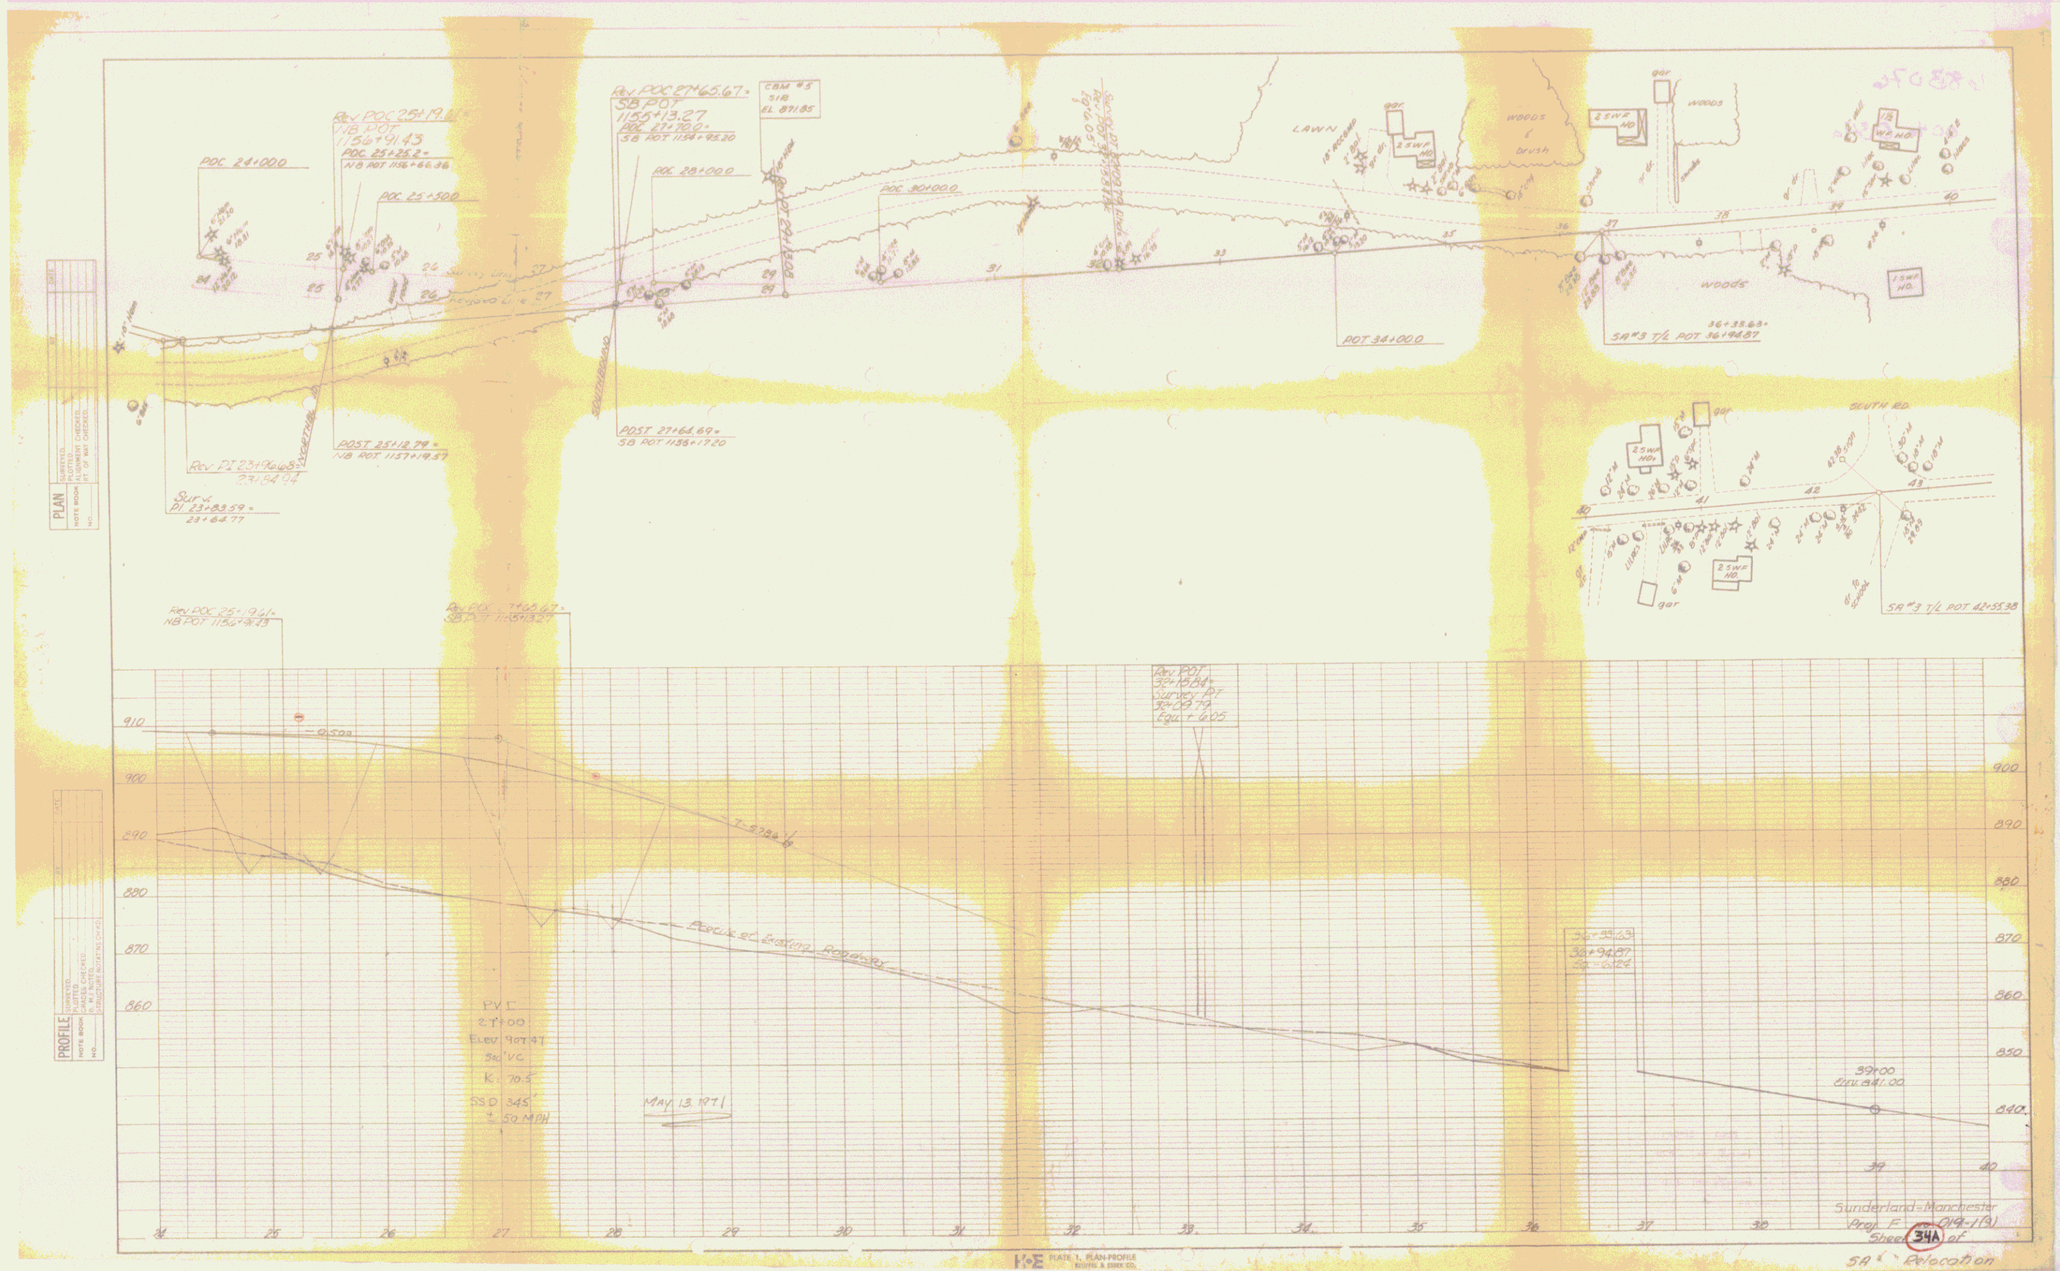
PLAN
PROFILE
POC 24+00.0
POC 25+50.0
POC 28+00.0
POC 30+00.0
POT 34+00.0
LAWN
WOODS
WOODS & brush
SOUTH RD.
Sunderland-Manchester
Proj. E
Sheet 34A of
SA #3 Relocation
PLATE 1. PLAN-PROFILE
MAY 13 1971

4A