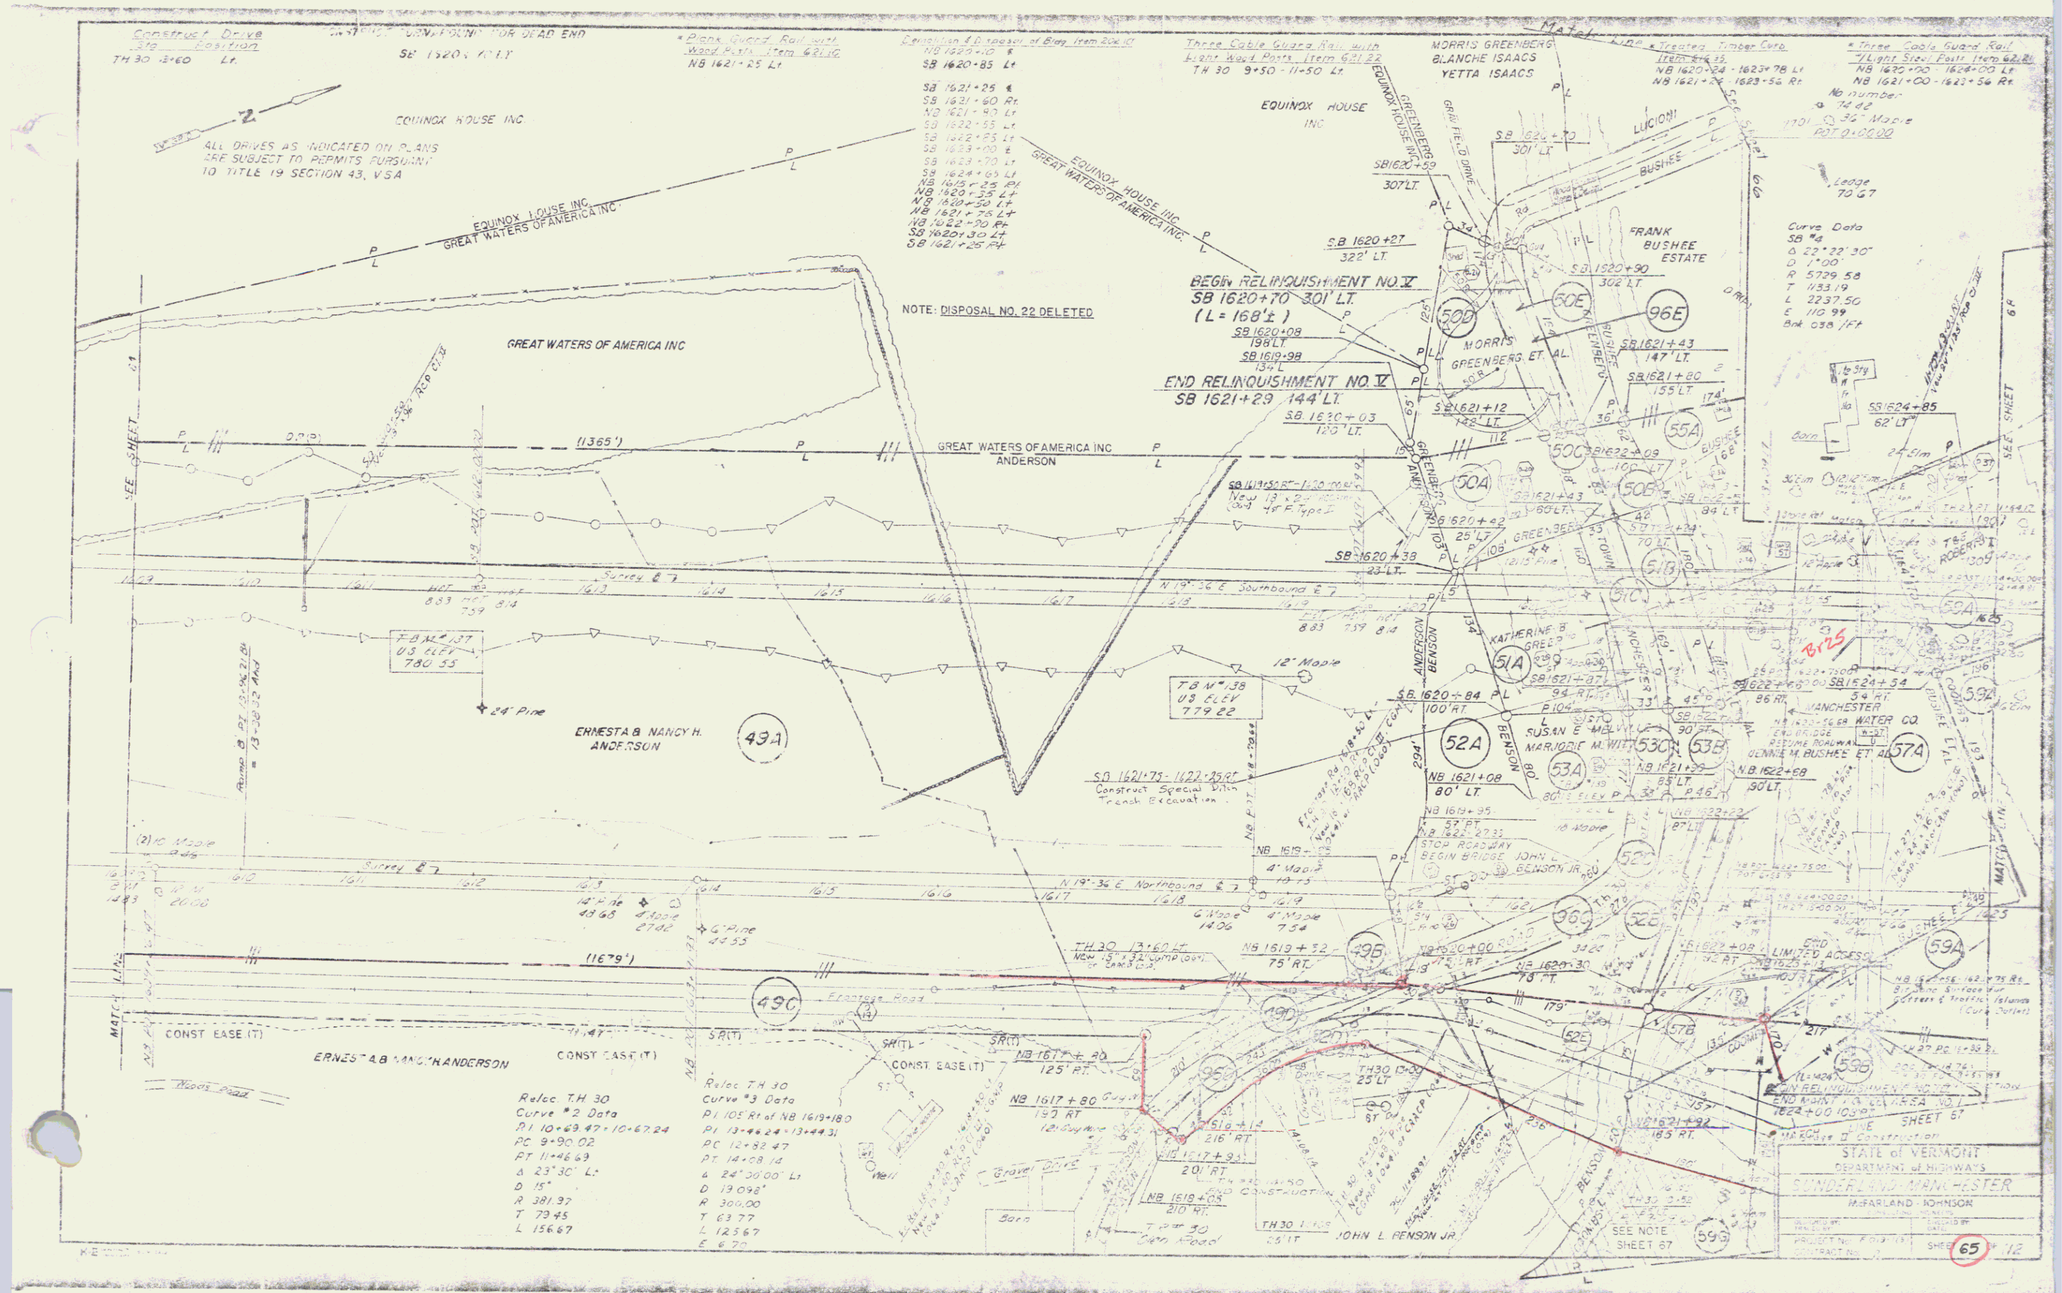
EQUINOX HOUSE INC.
GREAT WATERS OF AMERICA INC
ALL DRIVES AS INDICATED ON PLANS ARE SUBJECT TO PERMITS PURSUANT TO TITLE 19 SECTION 43, V.S.A.
NOTE: DISPOSAL NO. 22 DELETED
BEGIN RELINQUISHMENT NO. V
SB 1620+70 301' LT.
(L = 168'±)
END RELINQUISHMENT NO. V
SB 1621+29 144' LT.
MORRIS GREENBERG
BLANCHE ISAACS
YETTA ISAACS
FRANK BUSHEE ESTATE
MORRIS GREENBERG ET. AL.
GREAT WATERS OF AMERICA INC
ANDERSON
ERNEST A & NANCY H. ANDERSON
CONST EASE (T)
SEE SHEET 67
STATE of VERMONT
DEPARTMENT of HIGHWAYS
SUNDERLAND - MANCHESTER
McFARLAND - JOHNSON
SHEET 65 OF 12

36