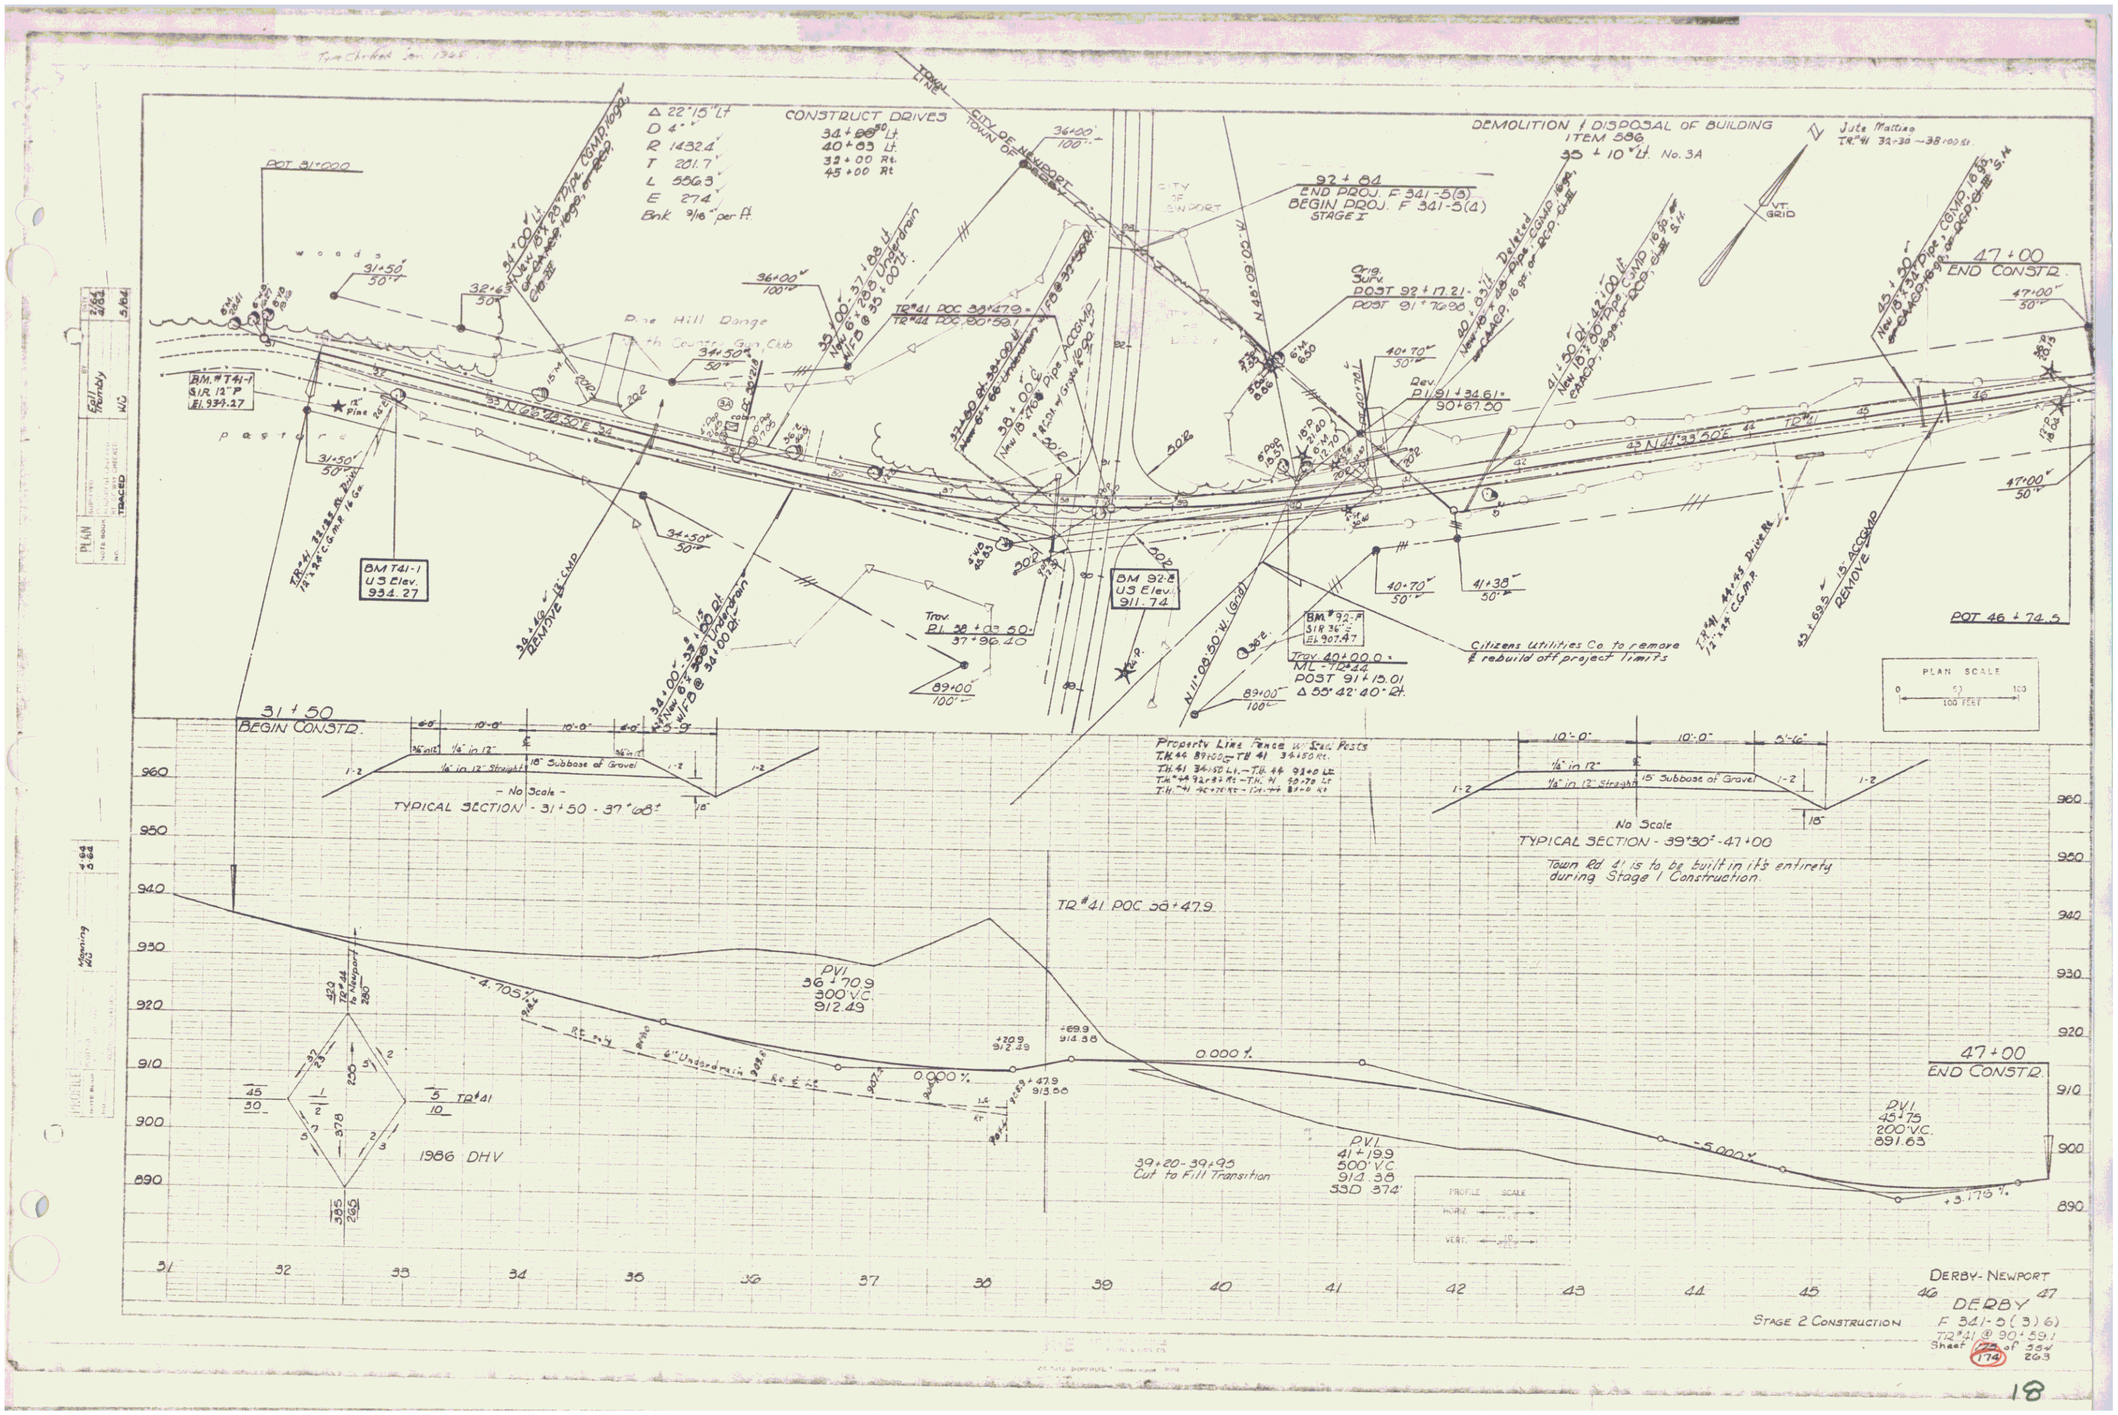
Δ 22°15' Lt
D 4°
R 1432.4'
T 201.7'
L 556.3'
E 27.4'
Bnk 9/16" per ft.
CONSTRUCT DRIVES
34+00.50 Lt.
40+03 Lt.
32+00 Rt.
45+00 Rt.
DEMOLITION & DISPOSAL OF BUILDING
ITEM 586
33+10' Lt. No. 3A
Jute Mallow
TR #41 32+30 ~ 38+00 Rt.
92+84
END PROJ. F 341-5(3)
BEGIN PROJ. F 341-5(4)
STAGE I
POST 92+17.21
POST 91+76.98
Rev. PI 91+34.61
90+67.50
47+00
END CONSTR.
POST 46+74.5
31+50
BEGIN CONSTR.
BM T41-1
U.S. Elev.
934.27
BM 92-8
U.S. Elev.
911.74
Citizens Utilities Co. to remove & rebuild off project limits
Property Line Fence w/ Steel Posts
PLAN SCALE
100 FEET
- No Scale -
TYPICAL SECTION - 31+50 - 37+68±
No Scale
TYPICAL SECTION - 39+30± - 47+00
Town Rd 41 is to be built in it's entirety during Stage 1 Construction.
TR #41 POC 36+47.9
PVI
36+70.9
300' V.C.
912.49
-4.705 %
0.000 %
PVI
41+19.9
500' V.C.
914.38
SSD 374'
39+20 - 39+95
Cut to Fill Transition
PVI
45+75
200' V.C.
891.63
-5.000 %
+3.175 %
1986 DHV
PROFILE SCALE
HORIZ.
VERT.
STAGE 2 CONSTRUCTION
DERBY-NEWPORT
DERBY
F 341-5(3)6)
TR #41 @ 90+59.1
Sheet 174 of 354
263
18