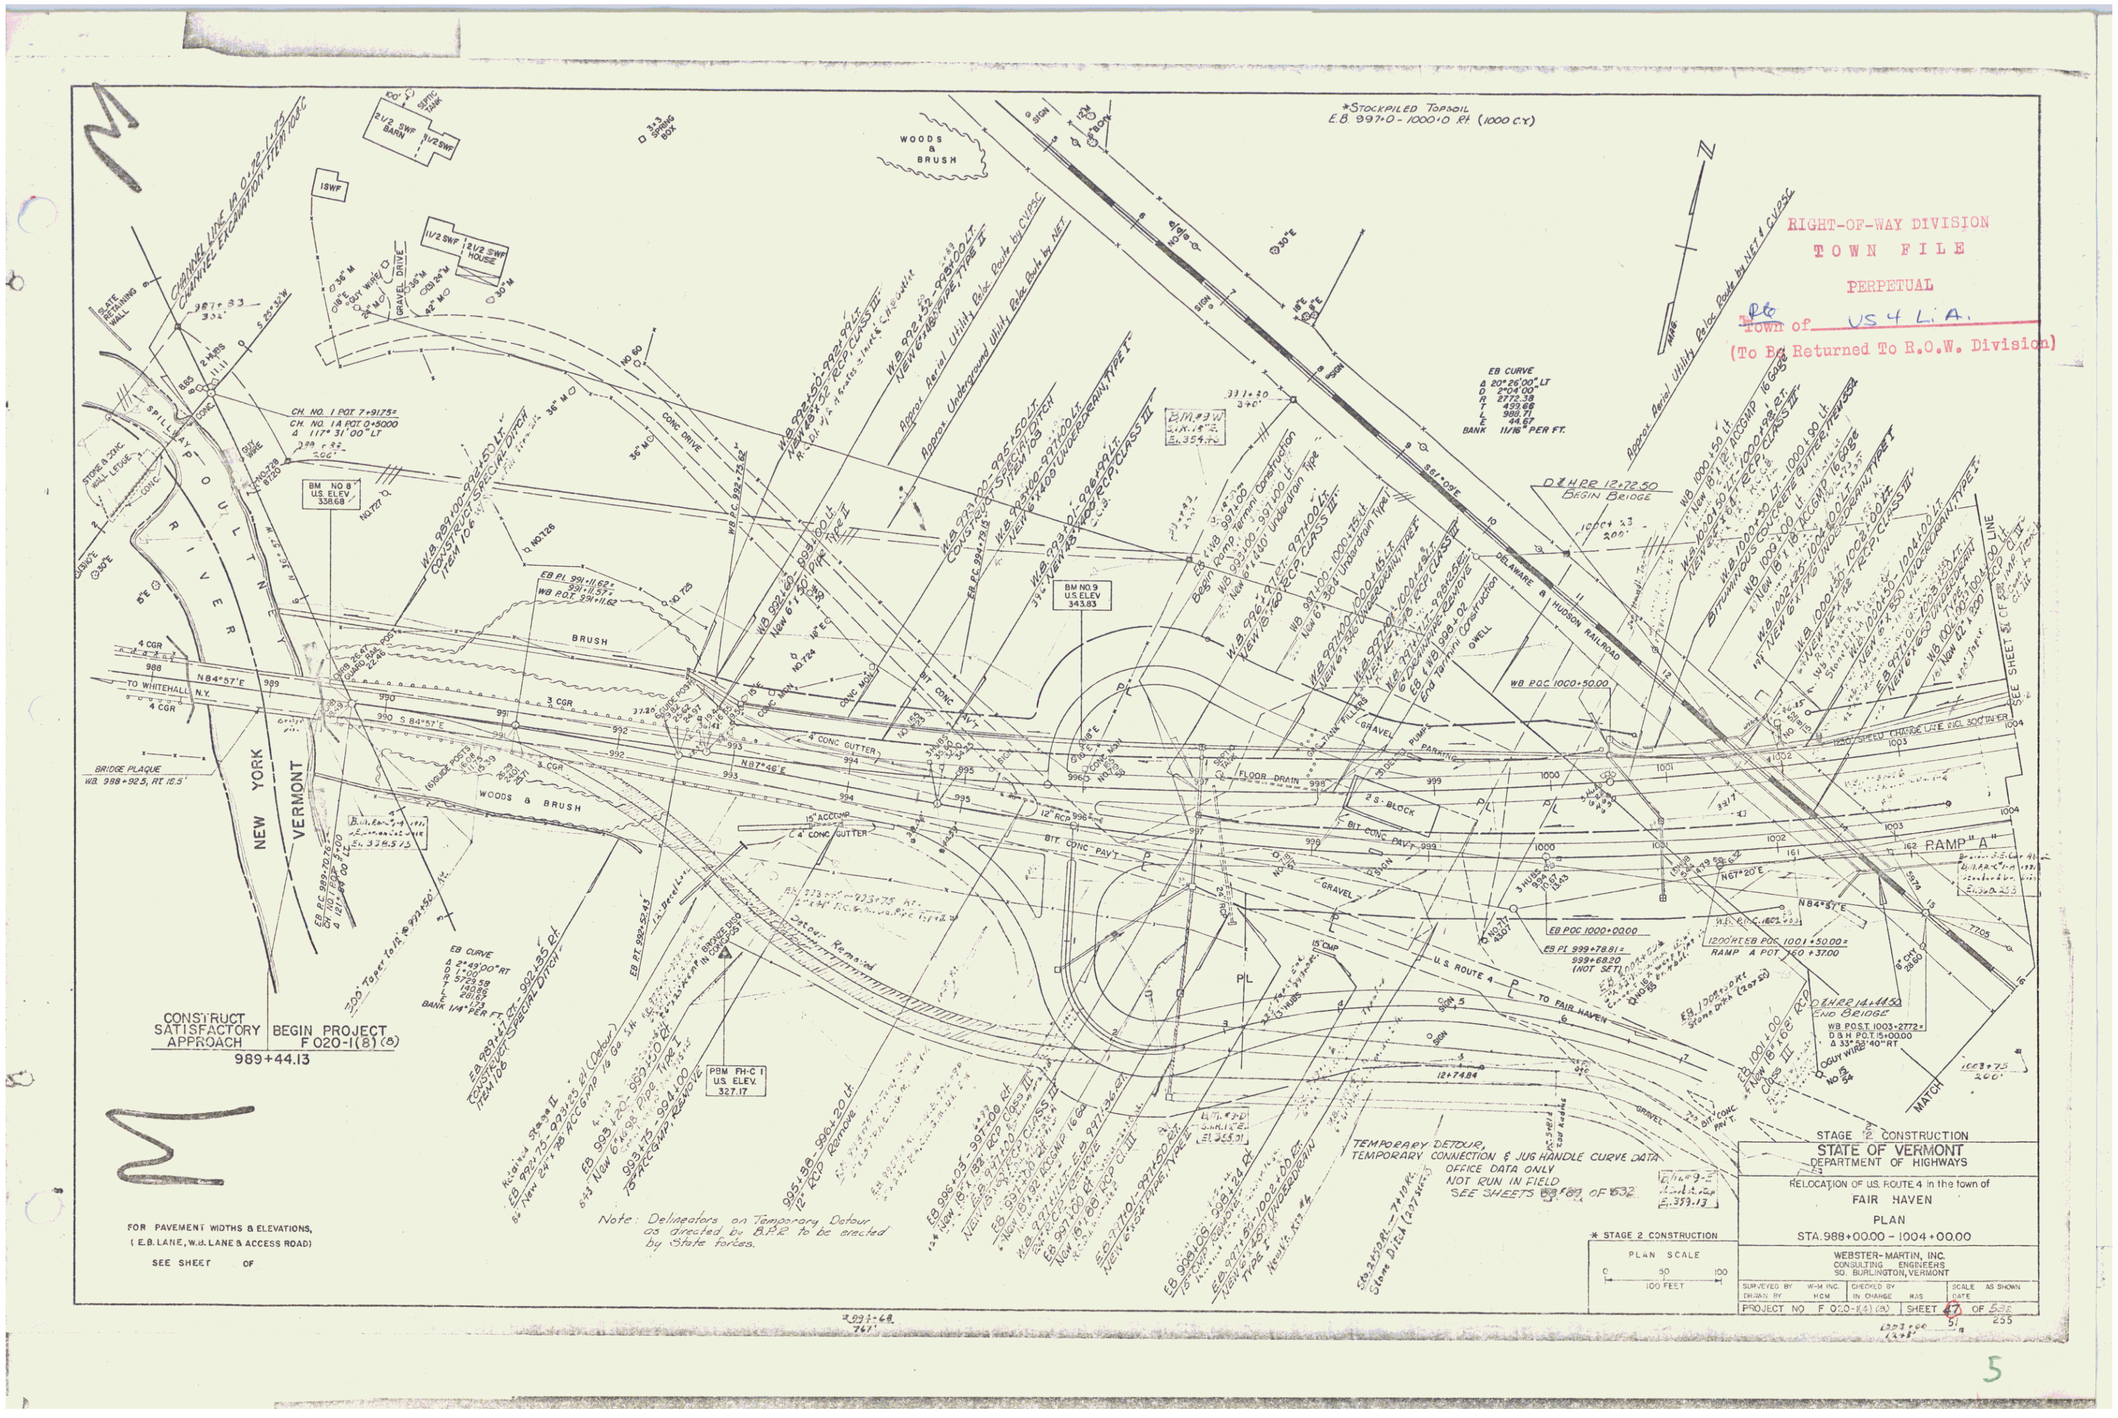
RIGHT-OF-WAY DIVISION
TOWN FILE
PERPETUAL
Town of US 4 L.A.
(To Be Returned To R.O.W. Division)
STAGE 2 CONSTRUCTION
STATE OF VERMONT
DEPARTMENT OF HIGHWAYS
RELOCATION OF US. ROUTE 4 in the town of
FAIR HAVEN
PLAN
STA. 988+00.00 - 1004+00.00
WEBSTER-MARTIN, INC.
CONSULTING ENGINEERS
SO. BURLINGTON, VERMONT
PROJECT NO F 020-1(8)(8)
SHEET 47 OF 532
CONSTRUCT SATISFACTORY APPROACH
BEGIN PROJECT F 020-1(8)(8)
989+44.13
FOR PAVEMENT WIDTHS & ELEVATIONS, (E.B. LANE, W.d. LANE & ACCESS ROAD) SEE SHEET OF
NEW YORK
VERMONT
POULTNEY RIVER
TO WHITEHALL N.Y.
TO FAIR HAVEN
U.S. ROUTE 4
DELAWARE & HUDSON RAILROAD
RAMP "A"
TEMPORARY DETOUR, TEMPORARY CONNECTION & JUG HANDLE CURVE DATA OFFICE DATA ONLY NOT RUN IN FIELD SEE SHEETS 68 & 69 OF 532
Note: Delineators on Temporary Detour as directed by B.P.R. to be erected by State forces.
* STAGE 2 CONSTRUCTION
PLAN SCALE
100 FEET
SEE SHEET 51 OF 235
MATCH