

Ramp B 184+00 - 188+00
 Ramp A 168+00 - 171+00
 Not Part of this Project

Ramp C 153+85 - 154+00
 Ramp CD 124+00 - 127+00
 Items Above Subgrade
 Not Part of this Project

| STONE FILL FOR SLOPE PROTECTION (LIGHT TYPE) ITEM 512 | | |
|---|---------|-----|
| STATION | STATION | POS |
| 1016+00 | 1020+00 | RT |


| THREE CABLE GUARD RAIL WITH LIGHT STEEL POSTS ITEM 538 | | |
|--|---------|-----|
| STATION | STATION | POS |

| SPECIAL GRADING ITEM 201, MOD. | | |
|--------------------------------|---------|-----|
| STATION | STATION | POS |

| PROPERTY LINE FENCE WITH STEEL POSTS ITEM 583-II, MOD. | | |
|--|---------|-----|
| STATION | STATION | POS |
| EB 1004+00 | 1007+25 | RT |

| VERTICAL GRANITE CURB ITEM 556-B | | |
|----------------------------------|---------|-----|
| STATION | STATION | POS |
| | | |

| GRANITE SLOPE EDGING ITEM 556-A | | |
|---------------------------------|---------|-----|
| STATION | STATION | POS |
| | | |

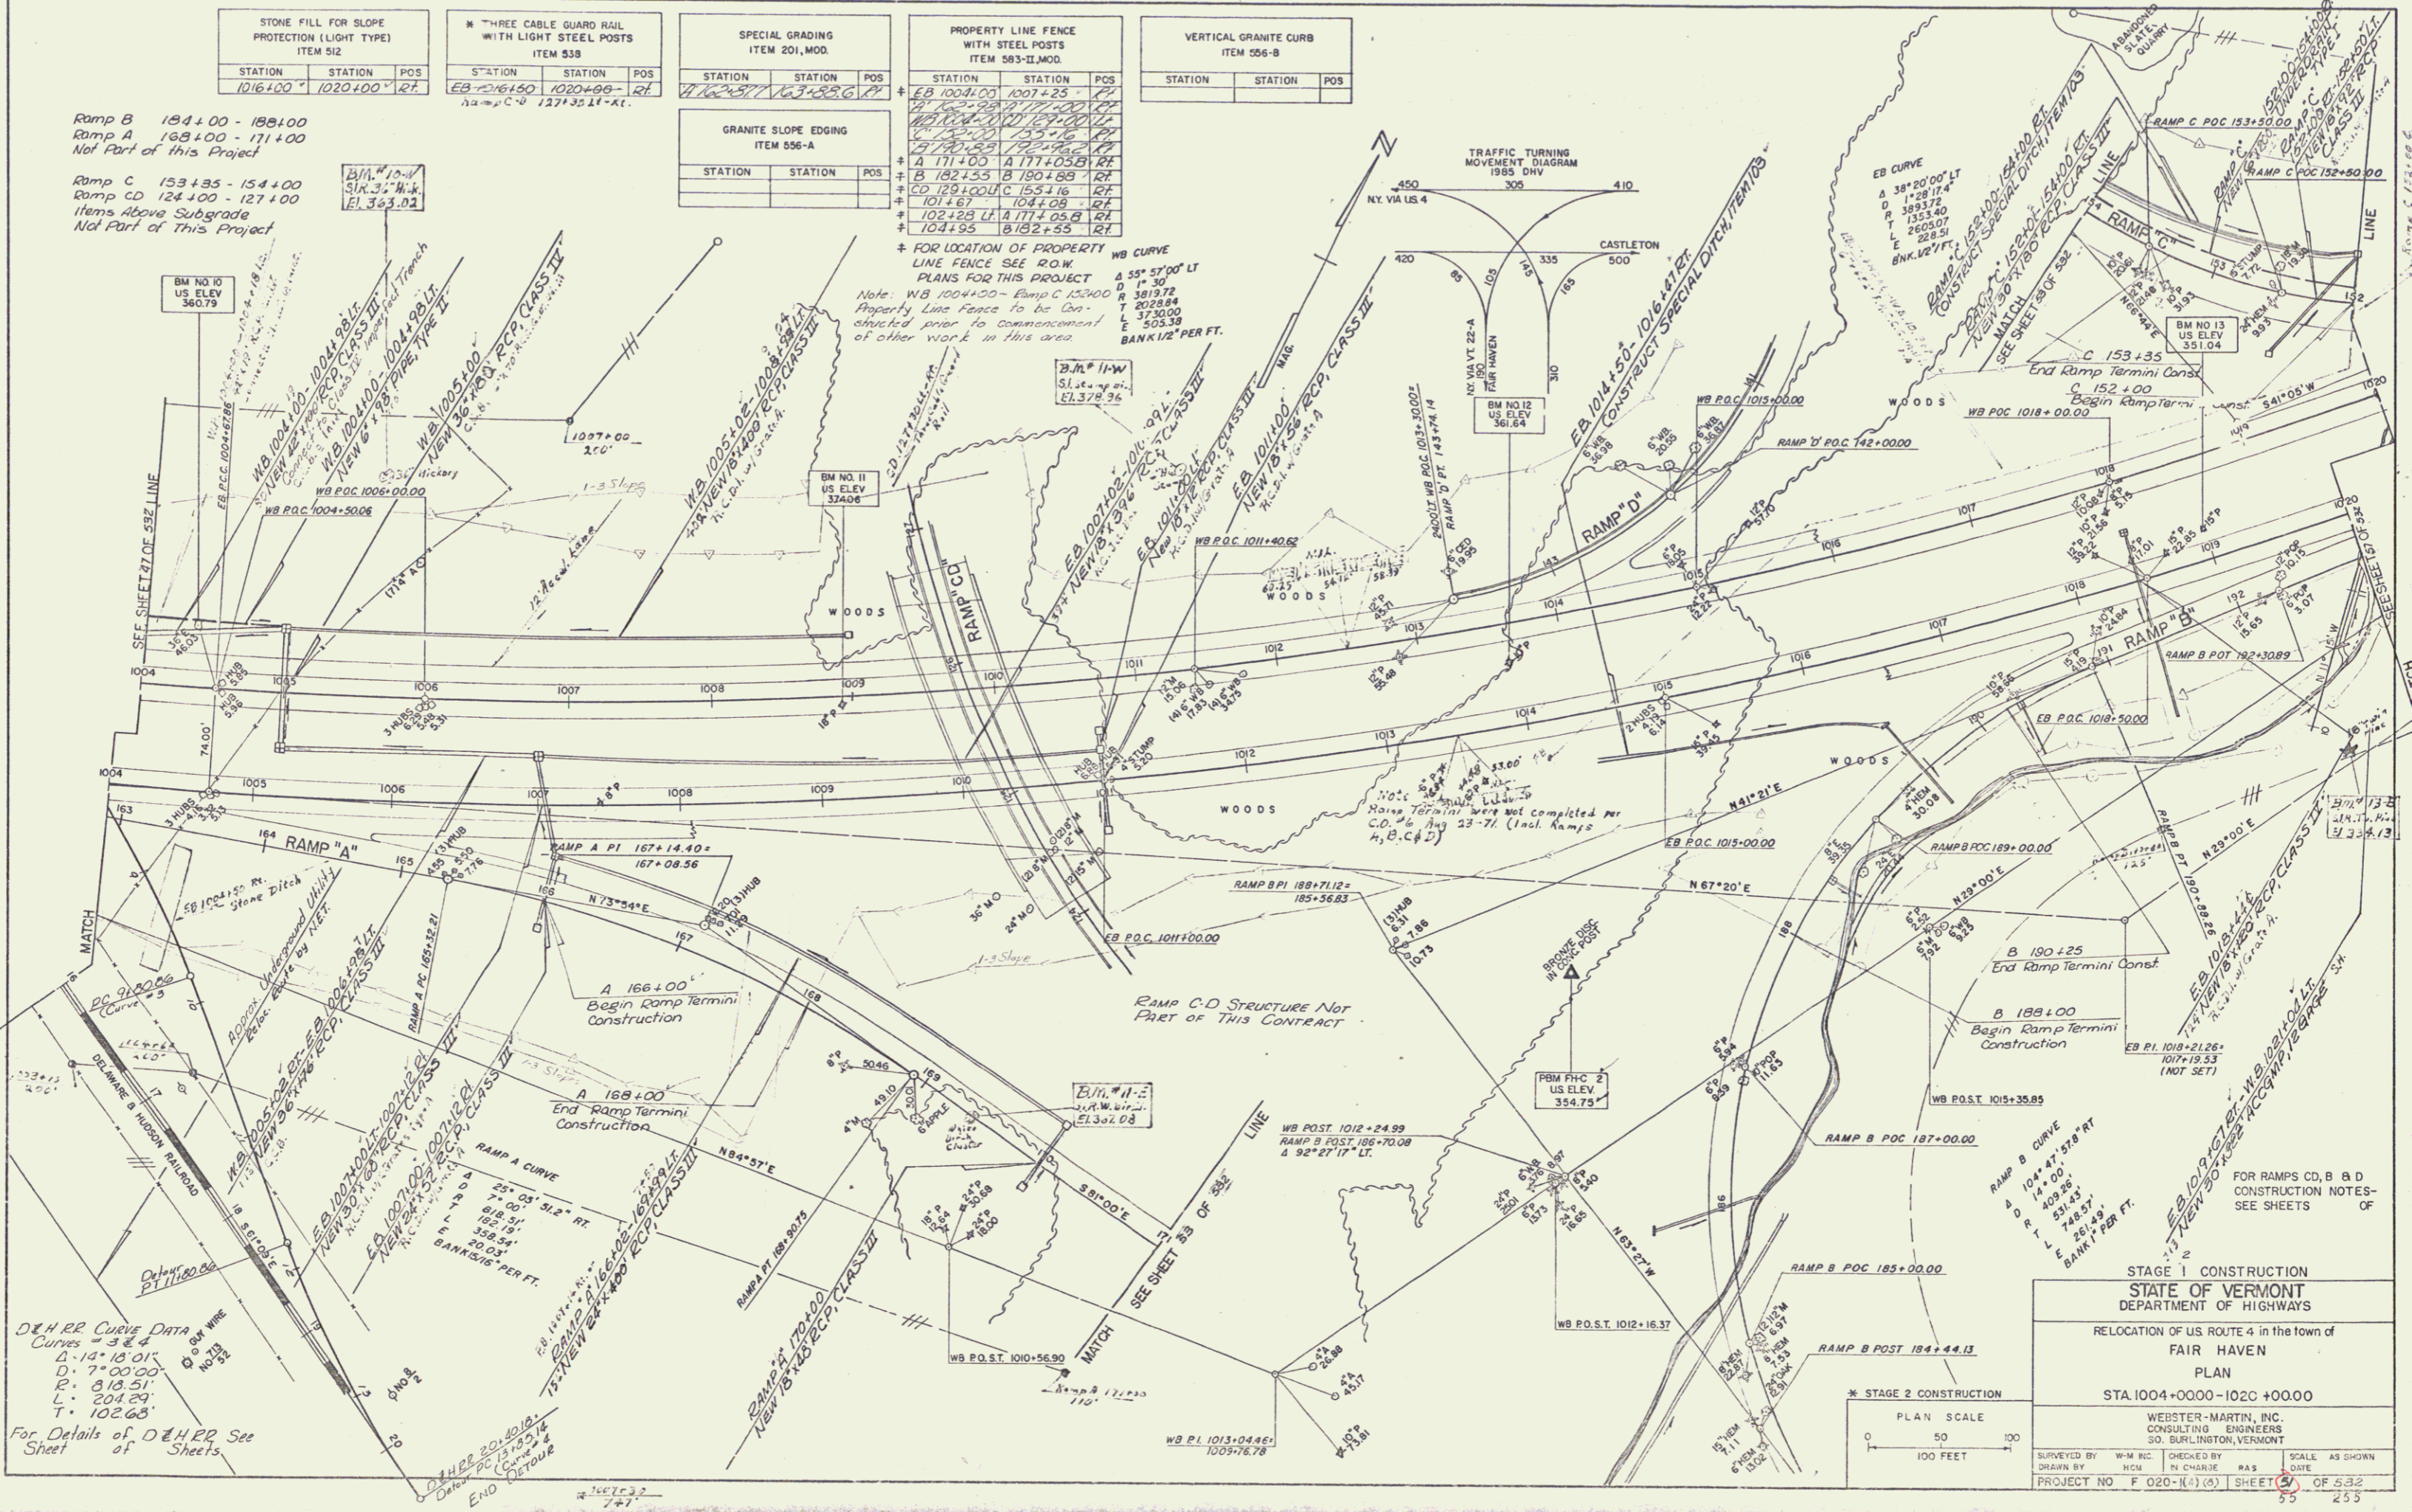

D&H RR Curve Data
 Curves = 3 & 4
 Δ = 14°10'01"
 D = 7°00'00"
 R = 918.51'
 L = 204.29'
 T = 102.63'

For Details of D&H RR See Sheet of

STAGE 1 CONSTRUCTION
 STATE OF VERMONT
 DEPARTMENT OF HIGHWAYS

RELOCATION OF US ROUTE 4 in the town of FAIR HAVEN
 PLAN
 STA. 1004+00.00 - 1020+00.00

WESTER-MARTIN, INC.
 CONSULTING ENGINEERS
 50 BURLINGTON, VERMONT

SUPERVISED BY: W.M. MC... DRAWN BY: HCU... PROJECT NO. F 020-(K4) (5) SHEET 55 OF 532

PLAN SCALE
 0 50 100 FEET