



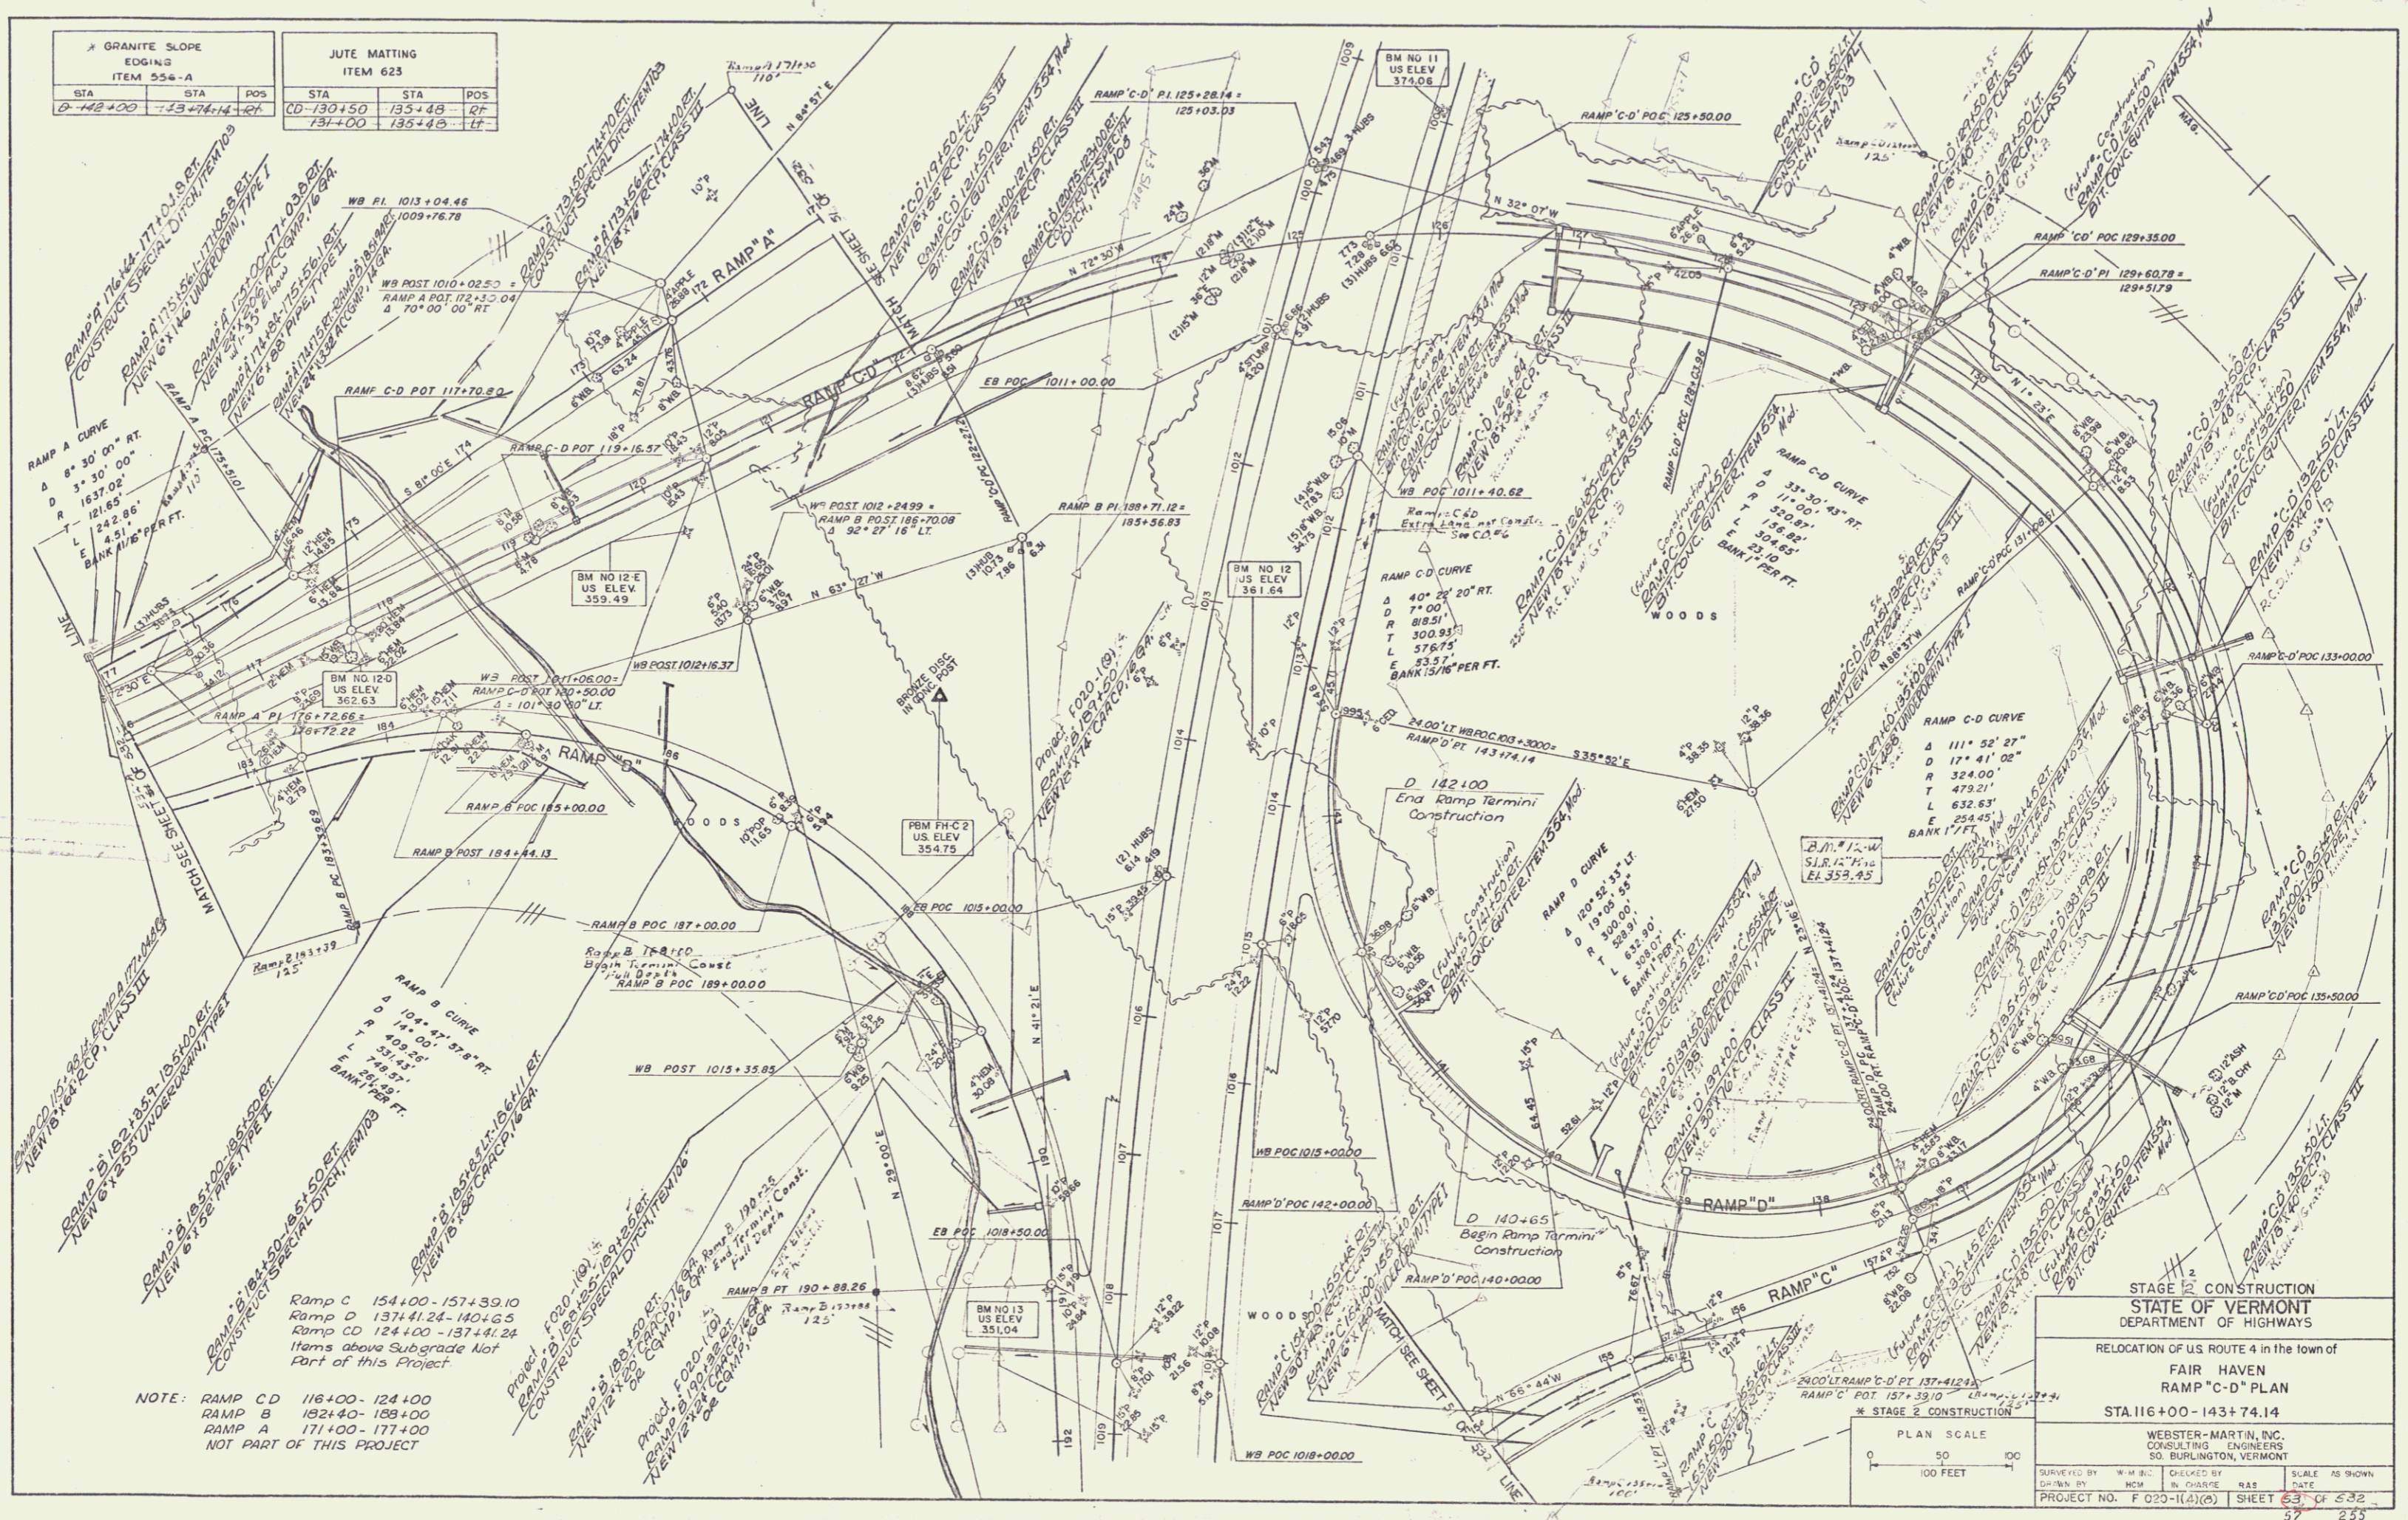

NOTE: RAMP C-D 116+00 - 124+00
 RAMP B 182+40 - 189+00
 RAMP A 171+00 - 177+00
 NOT PART OF THIS PROJECT

STAGE 2 CONSTRUCTION
 STATE OF VERMONT
 DEPARTMENT OF HIGHWAYS

RELOCATION OF U.S. ROUTE 4 in the town of
 FAIR HAVEN
 RAMP "C-D" PLAN
 STA 116+00 - 143+74.14

WEBSTER-MARTIN, INC.
 CONSULTING ENGINEERS
 50 BURLINGTON, VERMONT

PROJECT NO. F 020-1(A)(C) SHEET 63 OF 532

