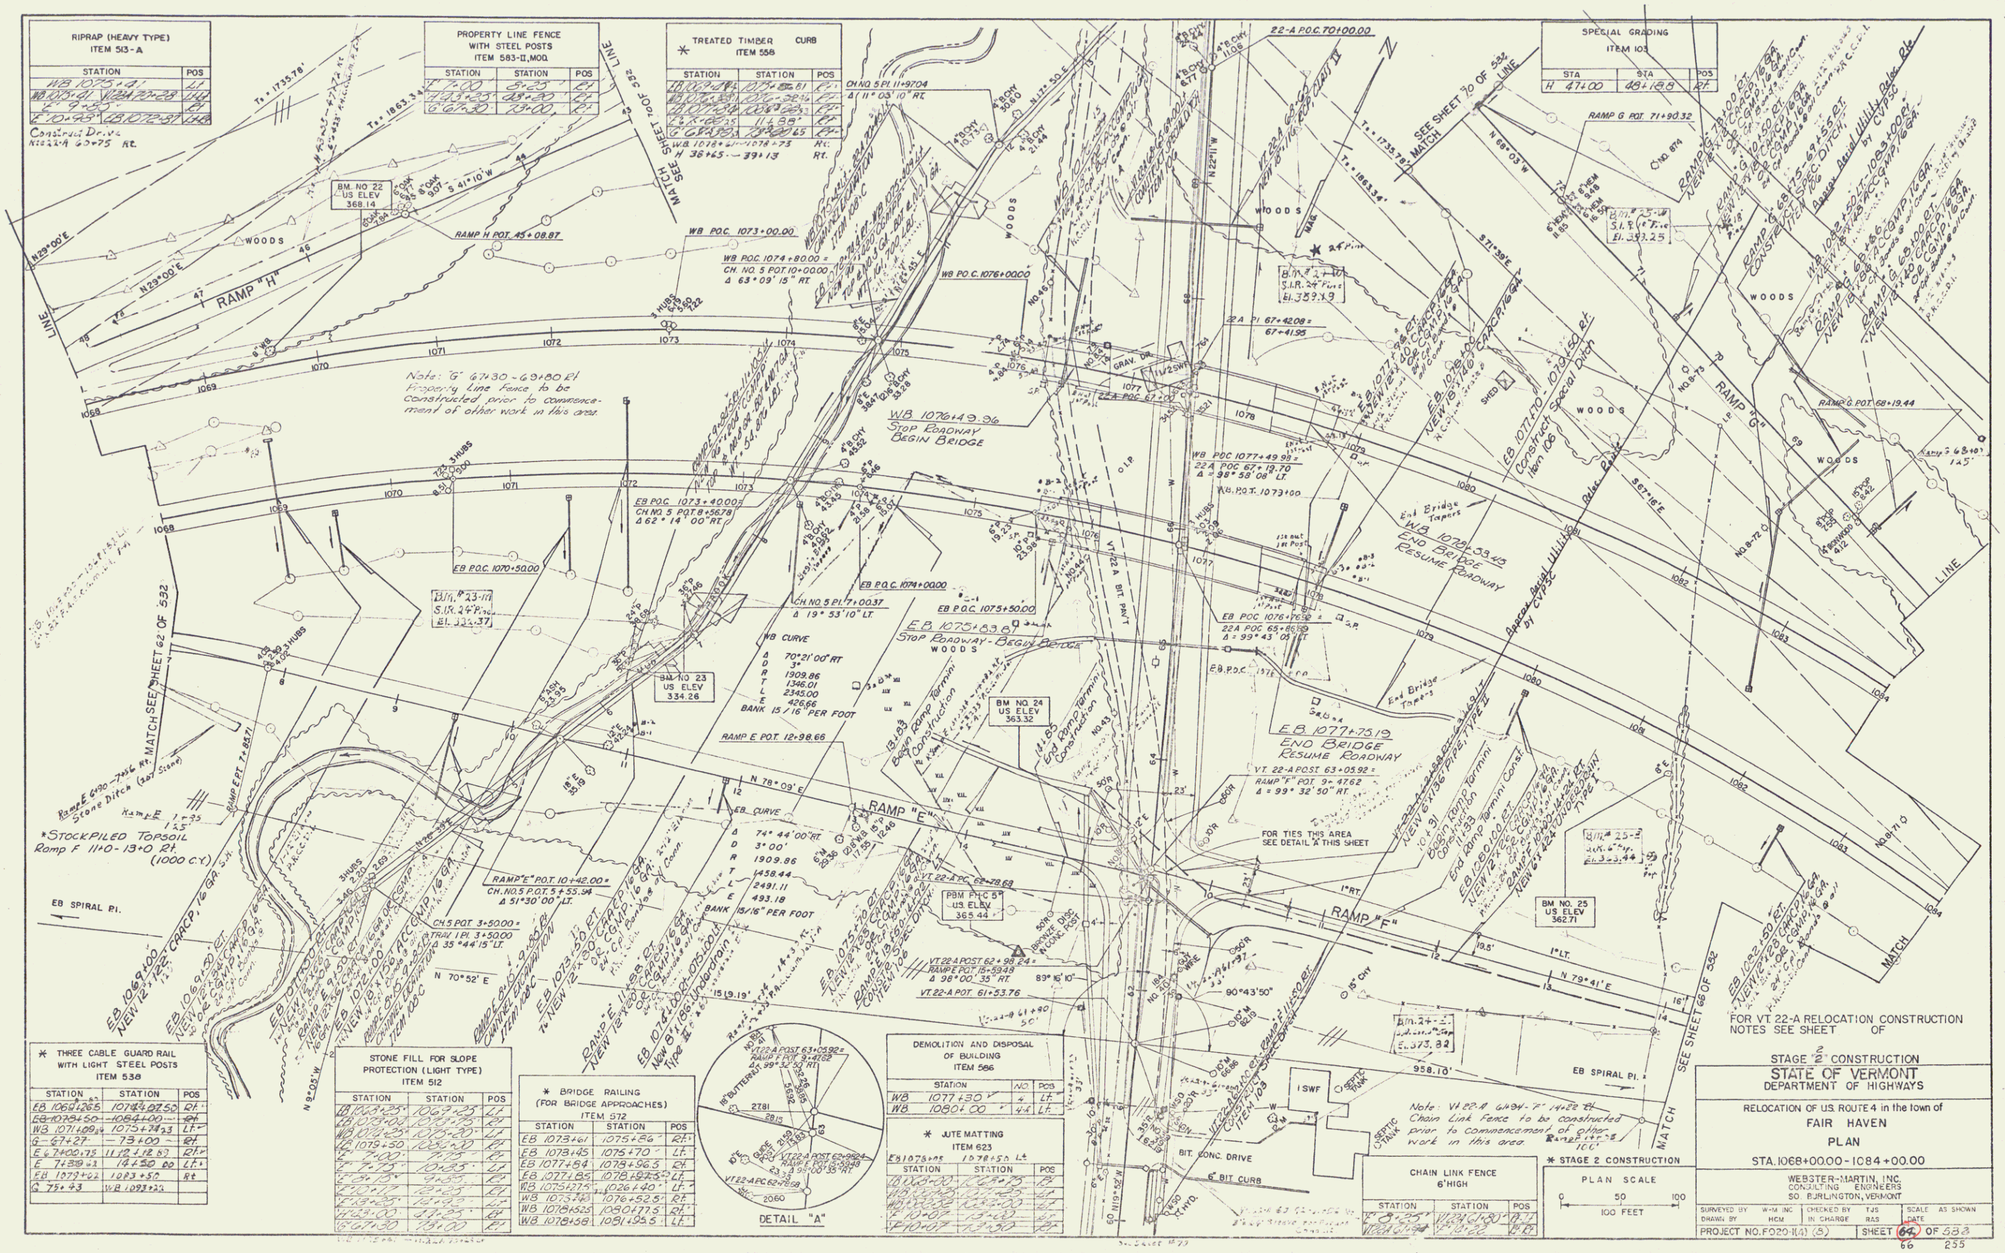
RIPRAP (HEAVY TYPE)
ITEM 503-A
PROPERTY LINE FENCE
WITH STEEL POSTS
ITEM 583-II, MOD.
TREATED TIMBER CURB
ITEM 558
SPECIAL GRADING
ITEM 103
RAMP "H"
RAMP "E"
RAMP "F"
RAMP "G"
WB 1076+49.36
Stop Roadway
Begin Bridge
EB 1075+33.61
Stop Roadway - Begin Bridge
EB 1077+75.19
End Bridge
Resume Roadway
WB 1075+33.43
End Bridge
Resume Roadway
Note: "G" 67+30 - 69+80 Rt.
Property Line Fence to be
constructed prior to commence-
ment of other work in this area.
*STOCKPILED TOPSOIL
Ramp F 11+0 - 13+0 Rt.
(1000 C.Y.)
EB SPIRAL PI.
FOR TIES THIS AREA
SEE DETAIL "A" THIS SHEET
FOR VT. 22-A RELOCATION CONSTRUCTION
NOTES SEE SHEET OF
STAGE "2" CONSTRUCTION
STATE OF VERMONT
DEPARTMENT OF HIGHWAYS
RELOCATION OF U.S. ROUTE 4 in the town of
FAIR HAVEN
PLAN
STA. 1068+00.00 - 1084+00.00
WEBSTER-MARTIN, INC.
CONSULTING ENGINEERS
SO. BURLINGTON, VERMONT
PROJECT NO. F020-1(4) (8)
SHEET 64 OF 583
66 255
* THREE CABLE GUARD RAIL
WITH LIGHT STEEL POSTS
ITEM 538
STONE FILL FOR SLOPE
PROTECTION (LIGHT TYPE)
ITEM 512
* BRIDGE RAILING
(FOR BRIDGE APPROACHES)
ITEM 572
DETAIL "A"
DEMOLITION AND DISPOSAL
OF BUILDING
ITEM 566
* JUTE MATTING
ITEM 623
CHAIN LINK FENCE
6' HIGH
* STAGE 2 CONSTRUCTION
PLAN SCALE
100 FEET
13