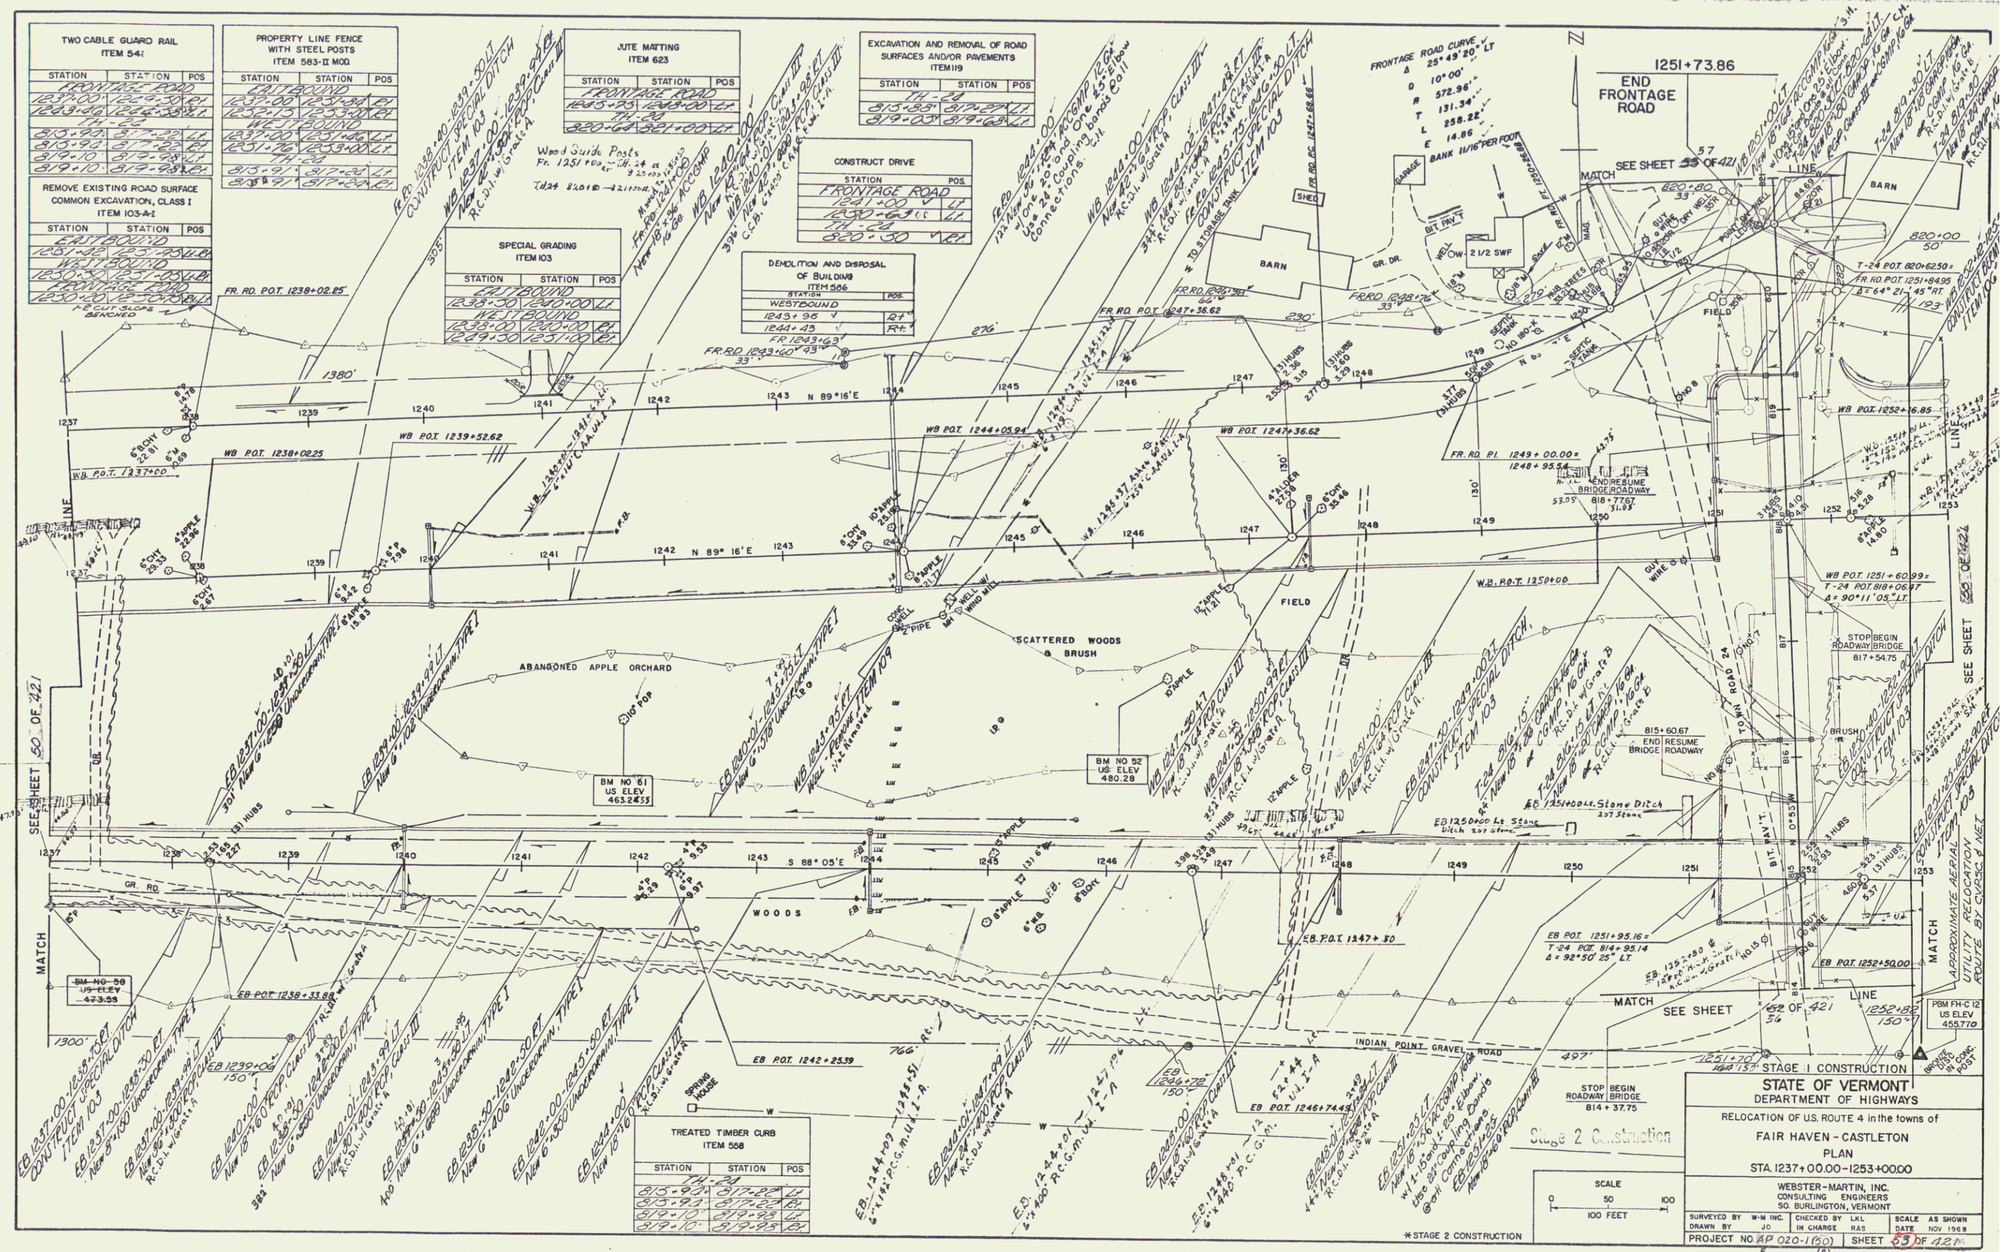
TWO CABLE GUARD RAIL ITEM 541
PROPERTY LINE FENCE WITH STEEL POSTS ITEM 583-II MOD
JUTE MATTING ITEM 623
EXCAVATION AND REMOVAL OF ROAD SURFACES AND/OR PAVEMENTS ITEM 119
REMOVE EXISTING ROAD SURFACE COMMON EXCAVATION, CLASS I ITEM 103-A-1
CONSTRUCT DRIVE
SPECIAL GRADING ITEM 103
DEMOLITION AND DISPOSAL OF BUILDING ITEM 506
TREATED TIMBER CURB ITEM 568
1251+73.86
END FRONTAGE ROAD
SEE SHEET 57 OF 421
BARN
FIELD
WOODS
SCATTERED WOODS & BRUSH
ABANDONED APPLE ORCHARD
INDIAN POINT GRAVEL ROAD
STAGE I CONSTRUCTION
Stage 2 Construction
*STAGE 2 CONSTRUCTION
STATE OF VERMONT
DEPARTMENT OF HIGHWAYS
RELOCATION OF U.S. ROUTE 4 in the towns of
FAIR HAVEN - CASTLETON
PLAN
STA. 1237+00.00 - 1253+00.00
WEBSTER-MARTIN, INC.
CONSULTING ENGINEERS
SO. BURLINGTON, VERMONT
SCALE 0 50 100 100 FEET
PROJECT NO. AP 020-1(30)
SHEET 63 OF 421

34