
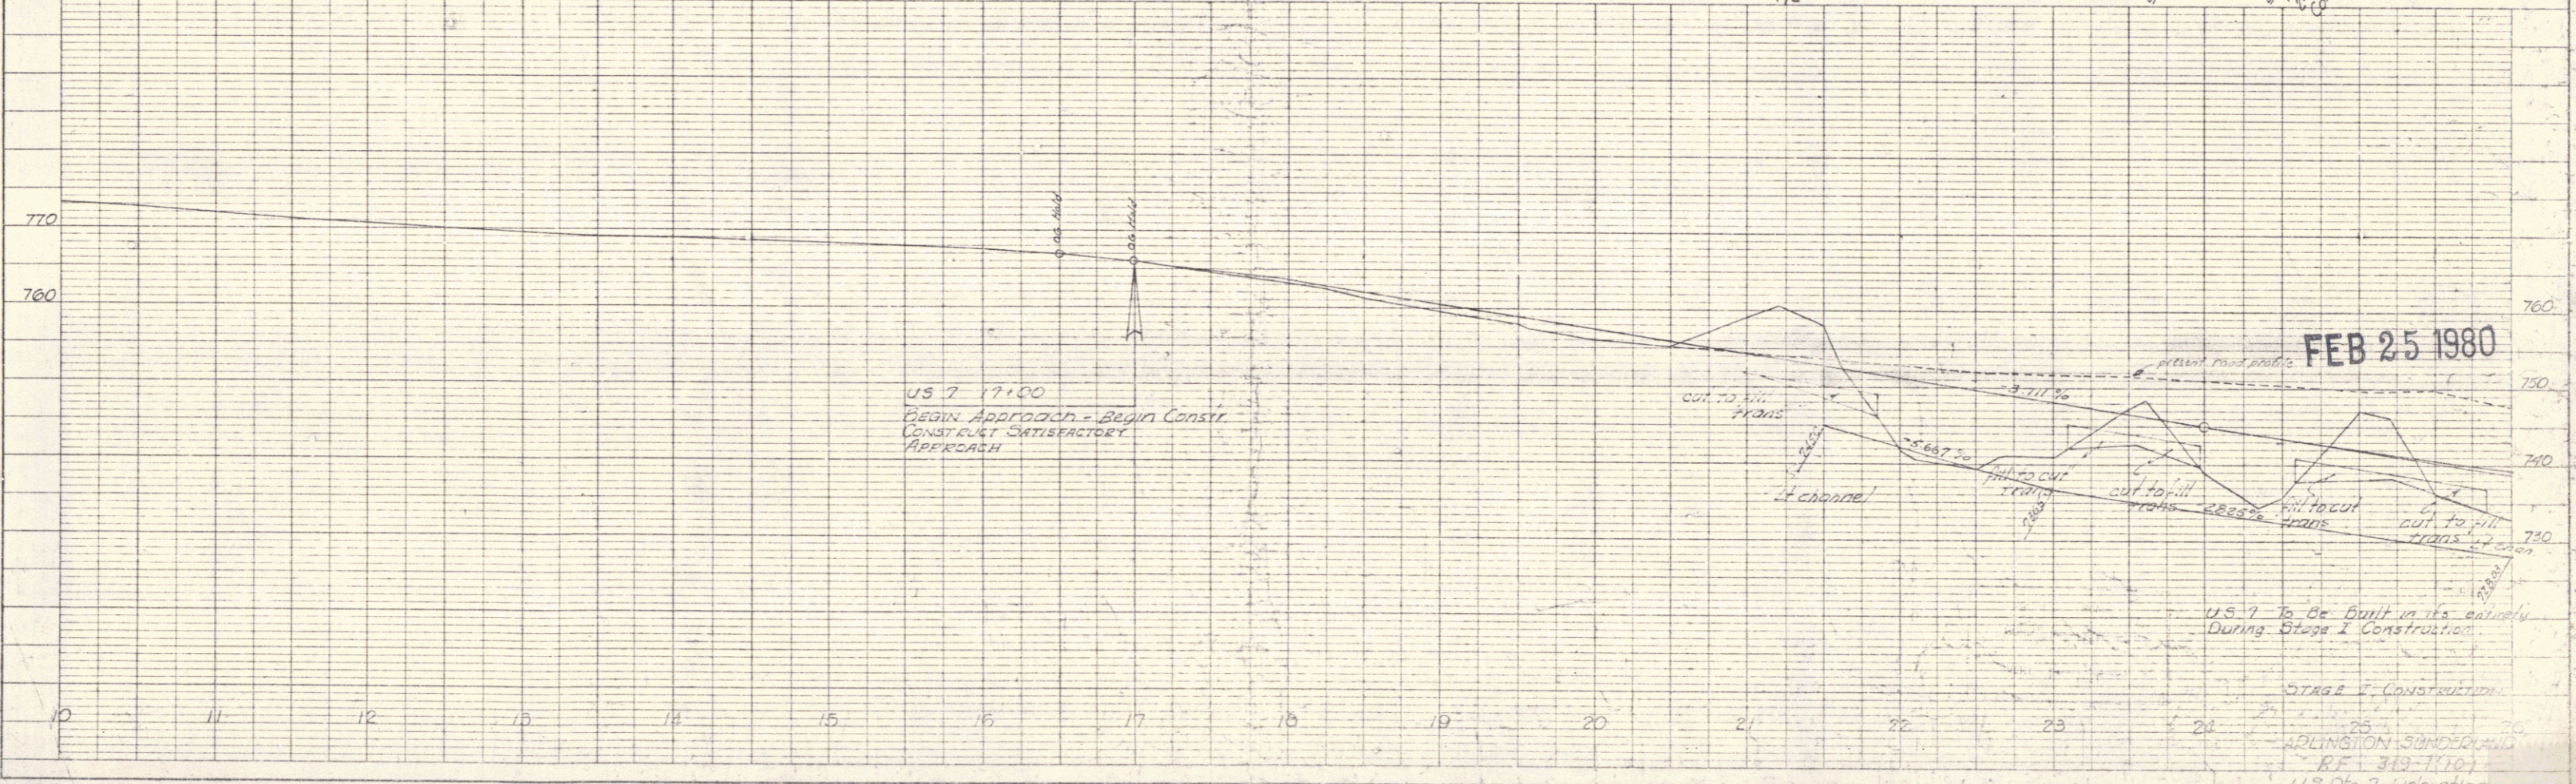


DATE: 1/67
 DRAWN BY: JEF
 CHECKED BY: PW
 NO. 667

DATE: 1-67
 DRAWN BY: JEF
 CHECKED BY: PW
 NO. 667

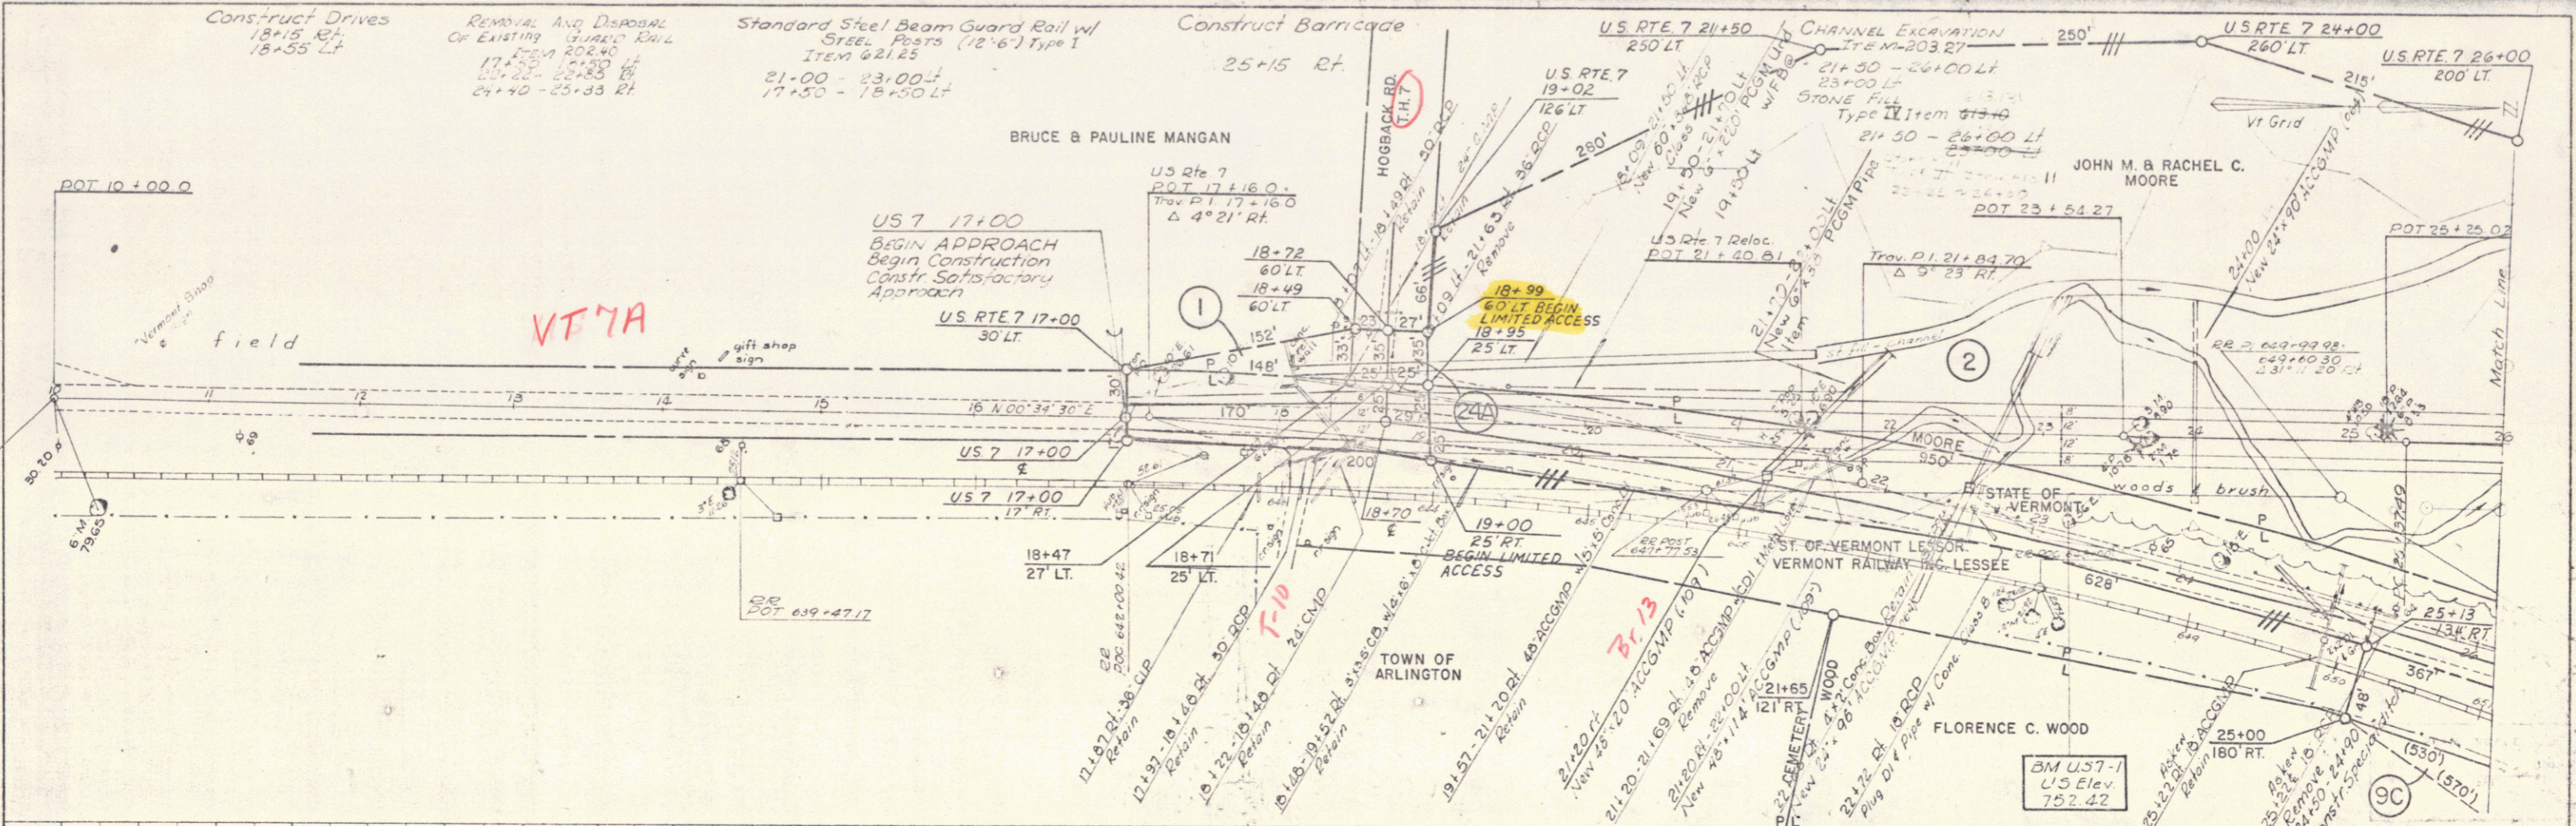

FEB 25 1980

STAGE I CONSTRUCTION
 U.S. Rte 7 Auxiliary
 Sheet 12 of 27