POOR ORIGINAL COPY

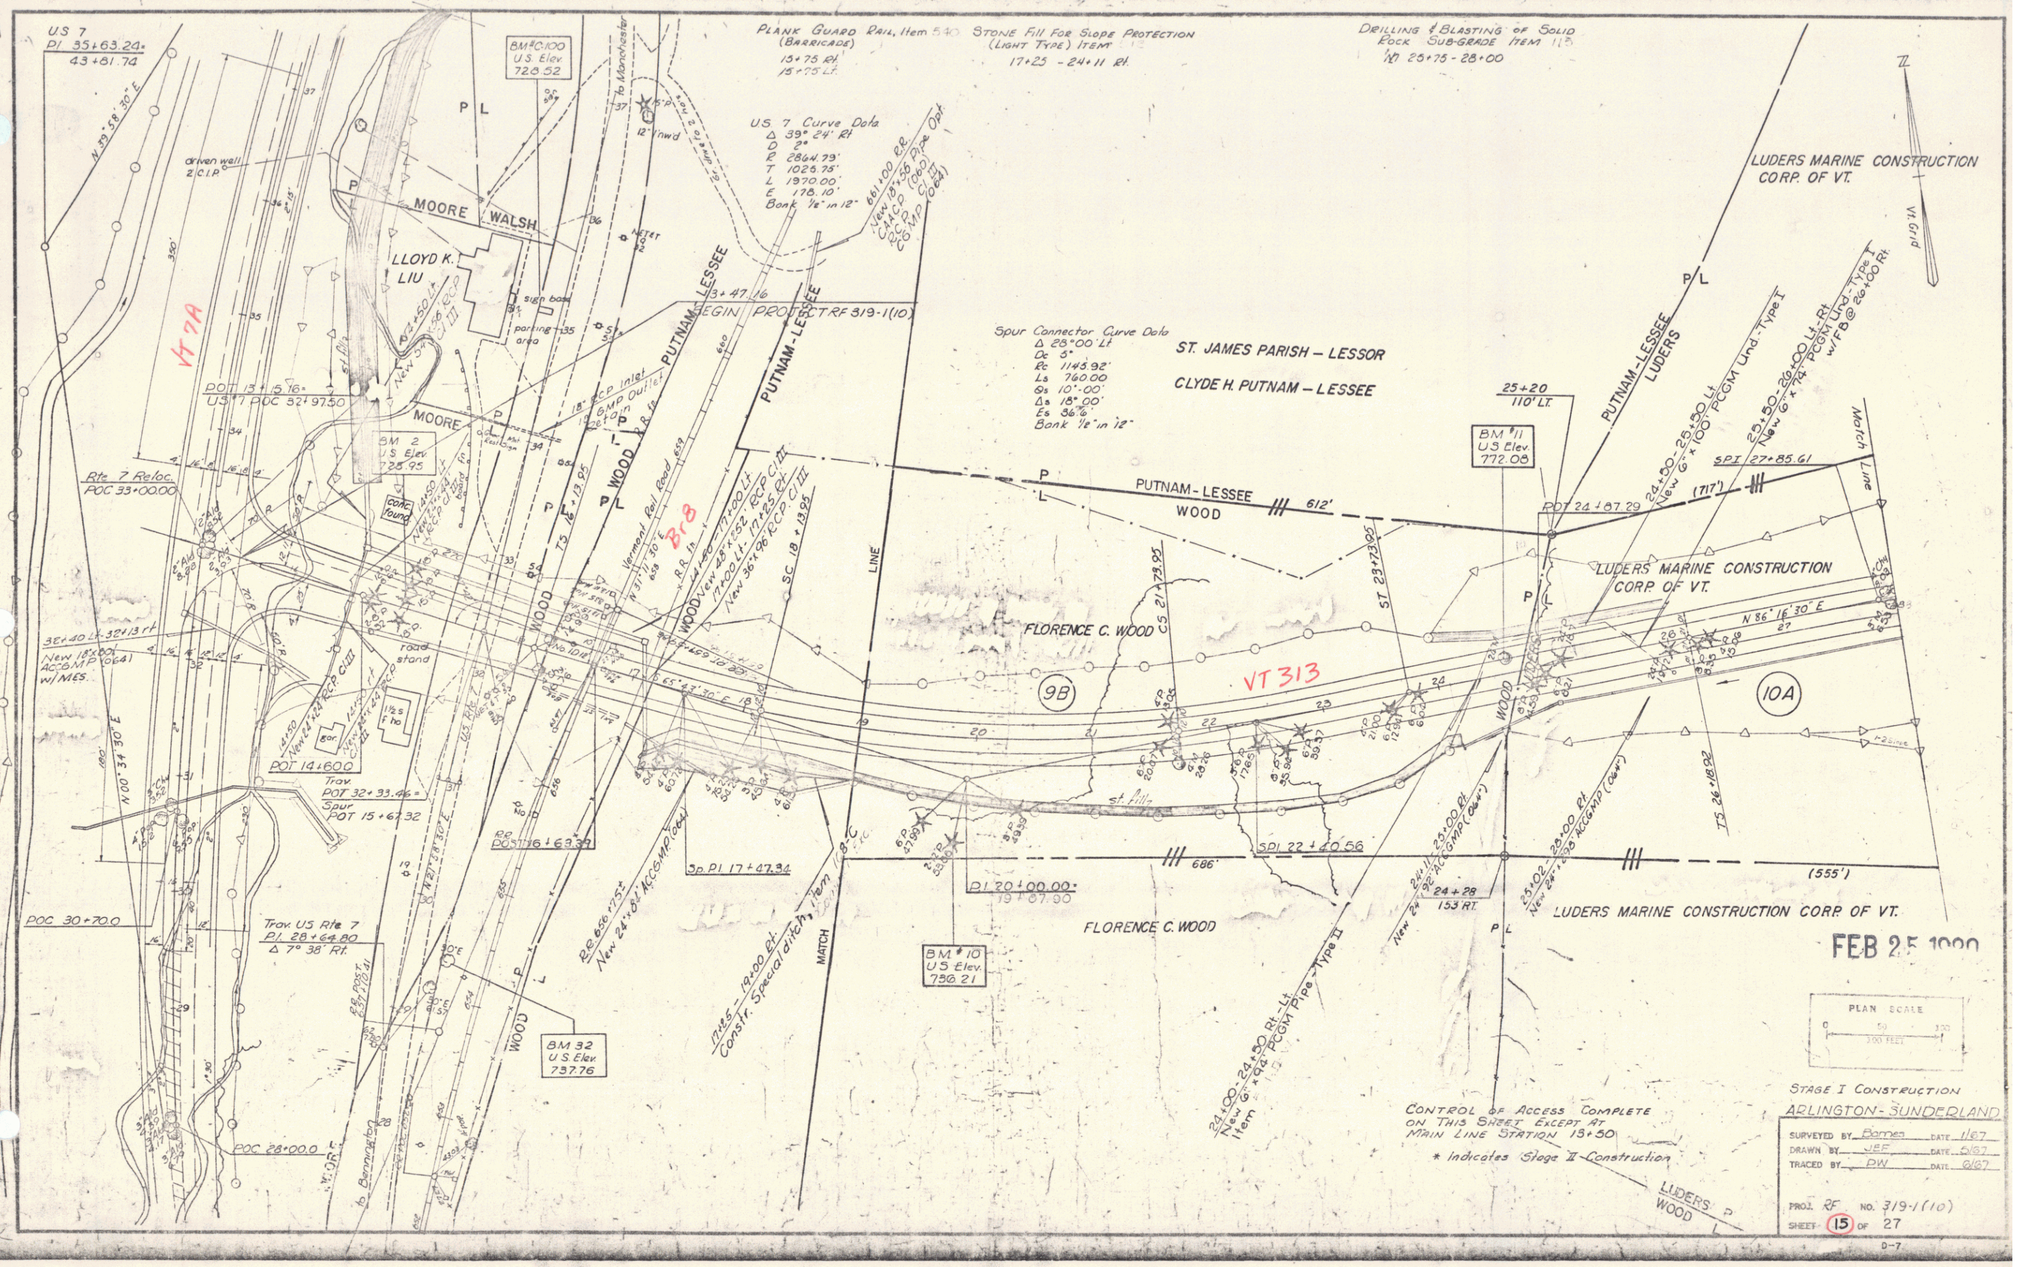

FEB 25 1969