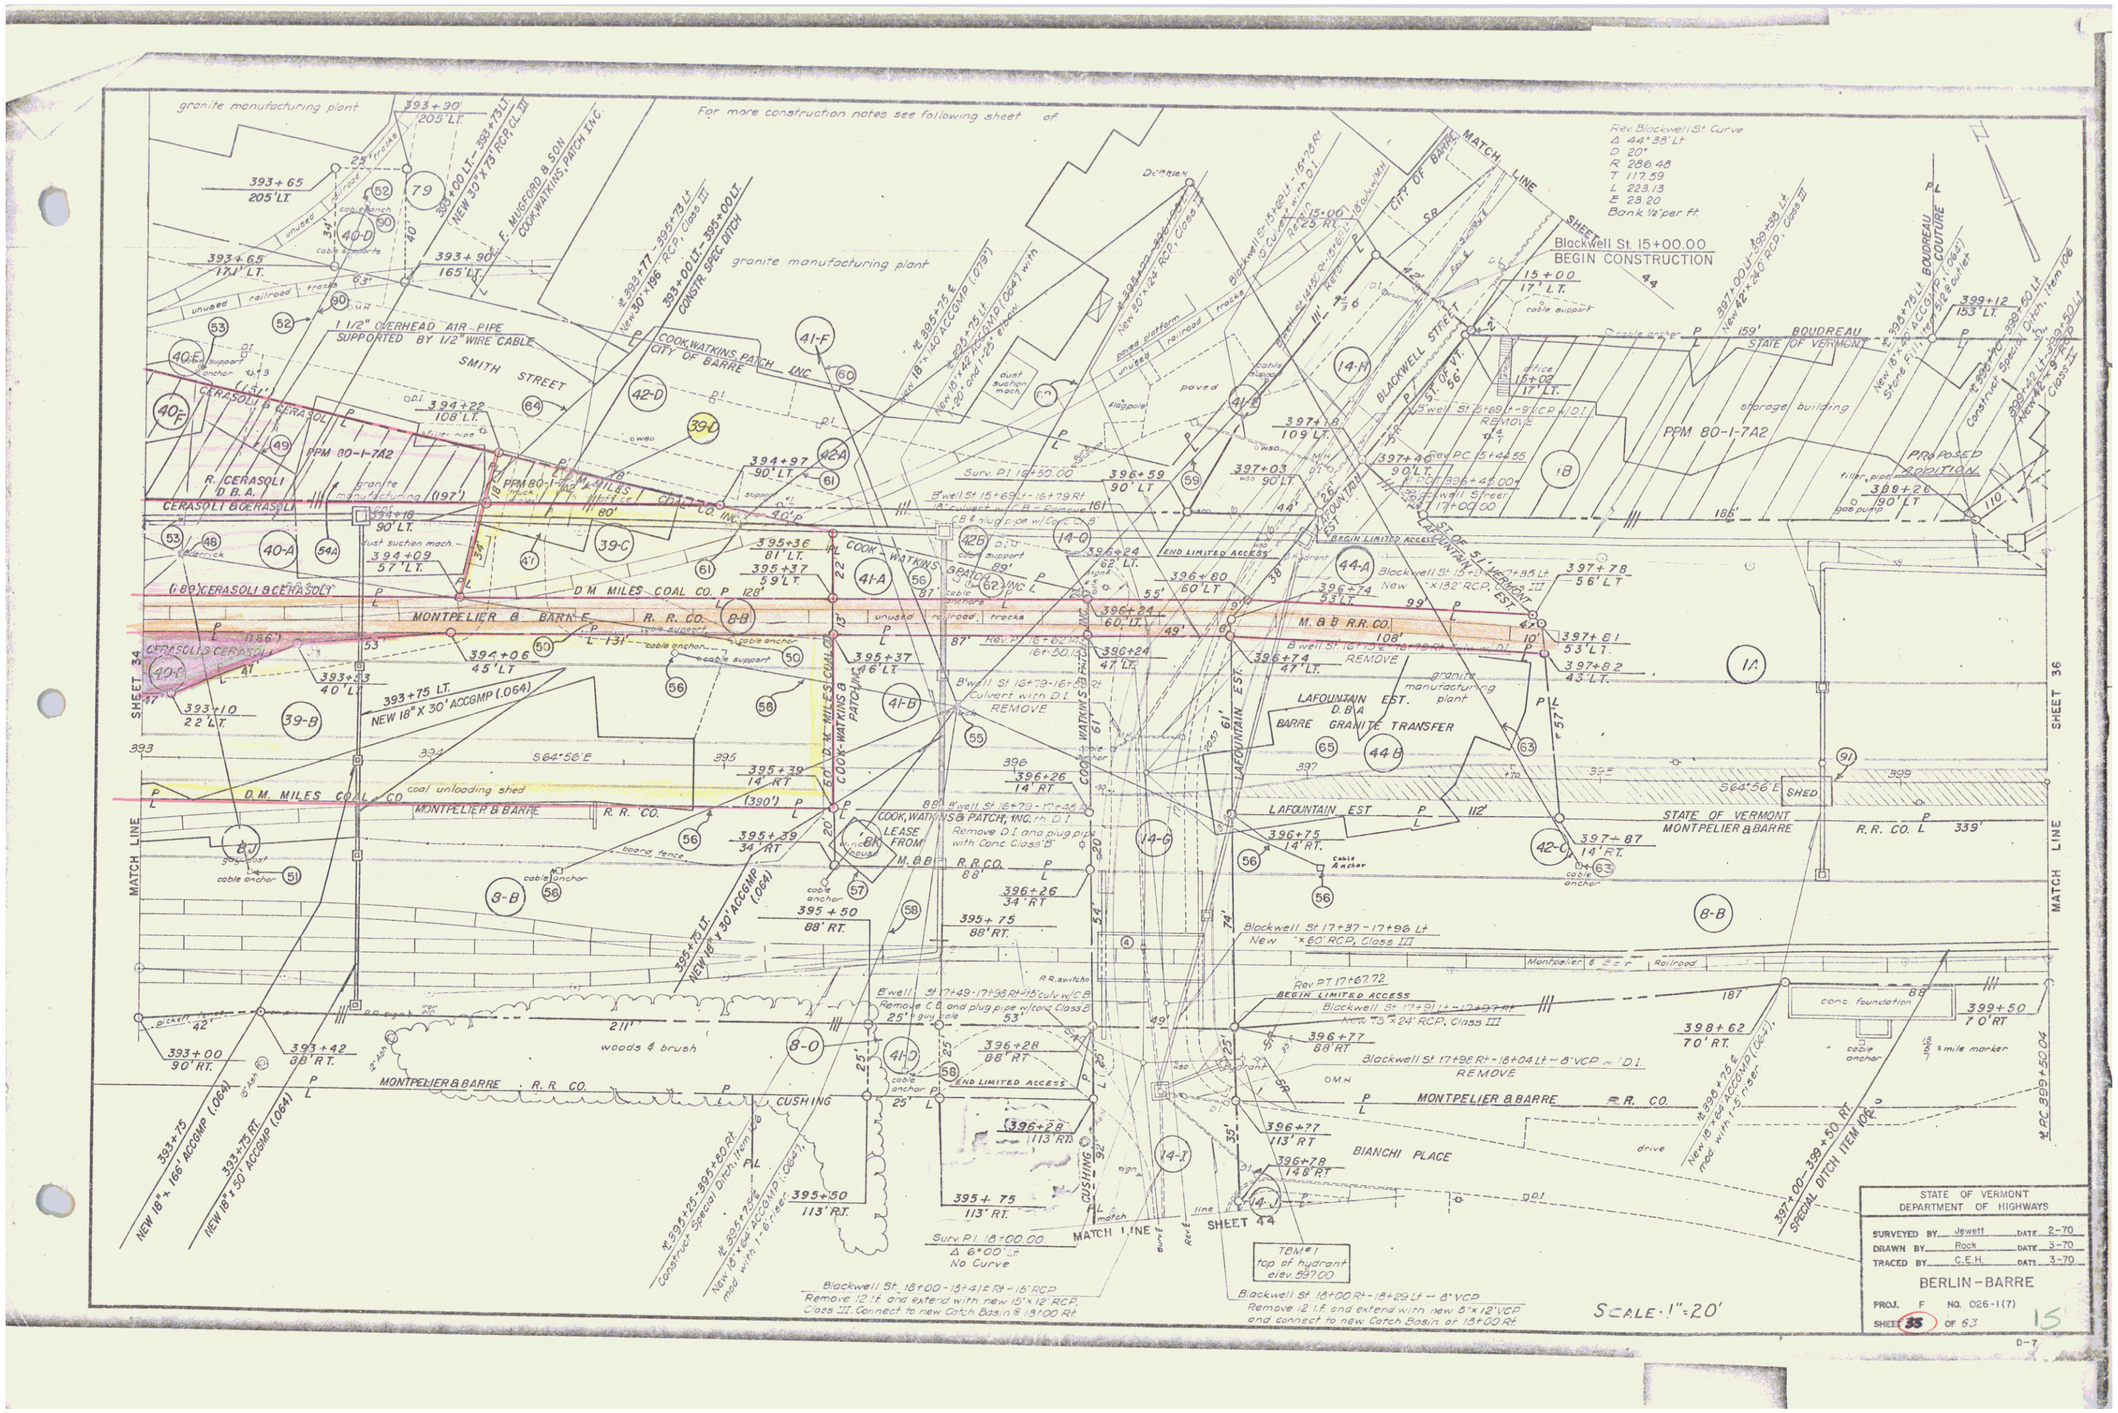
For more construction notes see following sheet of
granite manufacturing plant
SMITH STREET
BLACKWELL STREET
MONTPELIER & BARRE R.R. CO.
D.M. MILES COAL CO.
COOK, WATKINS & PATCH, INC.
CITY OF BARRE
STATE OF VERMONT
BOUDREAU
LAFOUNTAIN EST.
BARRE GRANITE TRANSFER
BIANCHI PLACE
CUSHING
PPM 80-1-7A2
PROPOSED ADDITION
storage building
coal unloading shed
woods & brush
MATCH LINE
SHEET 34
SHEET 36
SHEET 44
Blackwell St. 15+00.00
BEGIN CONSTRUCTION
BEGIN LIMITED ACCESS
END LIMITED ACCESS
Rev. Blackwell St Curve
Δ 44°38' Lt
D 20°
R 286.48
T 117.59
L 223.13
E 23.20
Bank 1/2" per ft
Blackwell St 17+67.72
BEGIN LIMITED ACCESS
Blackwell St 17+98 Rt - 18+04 Lt - 8" VCP - D.I.
REMOVE
Blackwell St 18+00 Rt - 18+29 Lt - 8" VCP
Remove 12 l.f. and extend with new 8" x 12" VCP
and connect to new Catch Basin at 18+00 Rt
Blackwell St. 18+00 - 18+41 Rt - 15" RCP
Remove 12 l.f. and extend with new 15" x 12" RCP,
Class III. Connect to new Catch Basin @ 18+00 Rt
Surv. P.I. 18+00.00
Δ 6°00' Lt
No Curve
TBM #1
top of hydrant
elev. 597.00
SCALE: 1" = 20'
STATE OF VERMONT
DEPARTMENT OF HIGHWAYS
SURVEYED BY Jewett DATE 2-70
DRAWN BY Rock DATE 3-70
TRACED BY C.E.H. DATE 3-70
BERLIN - BARRE
PROJ. F NO. 026-1(7)
SHEET 35 OF 53
15
D-7