




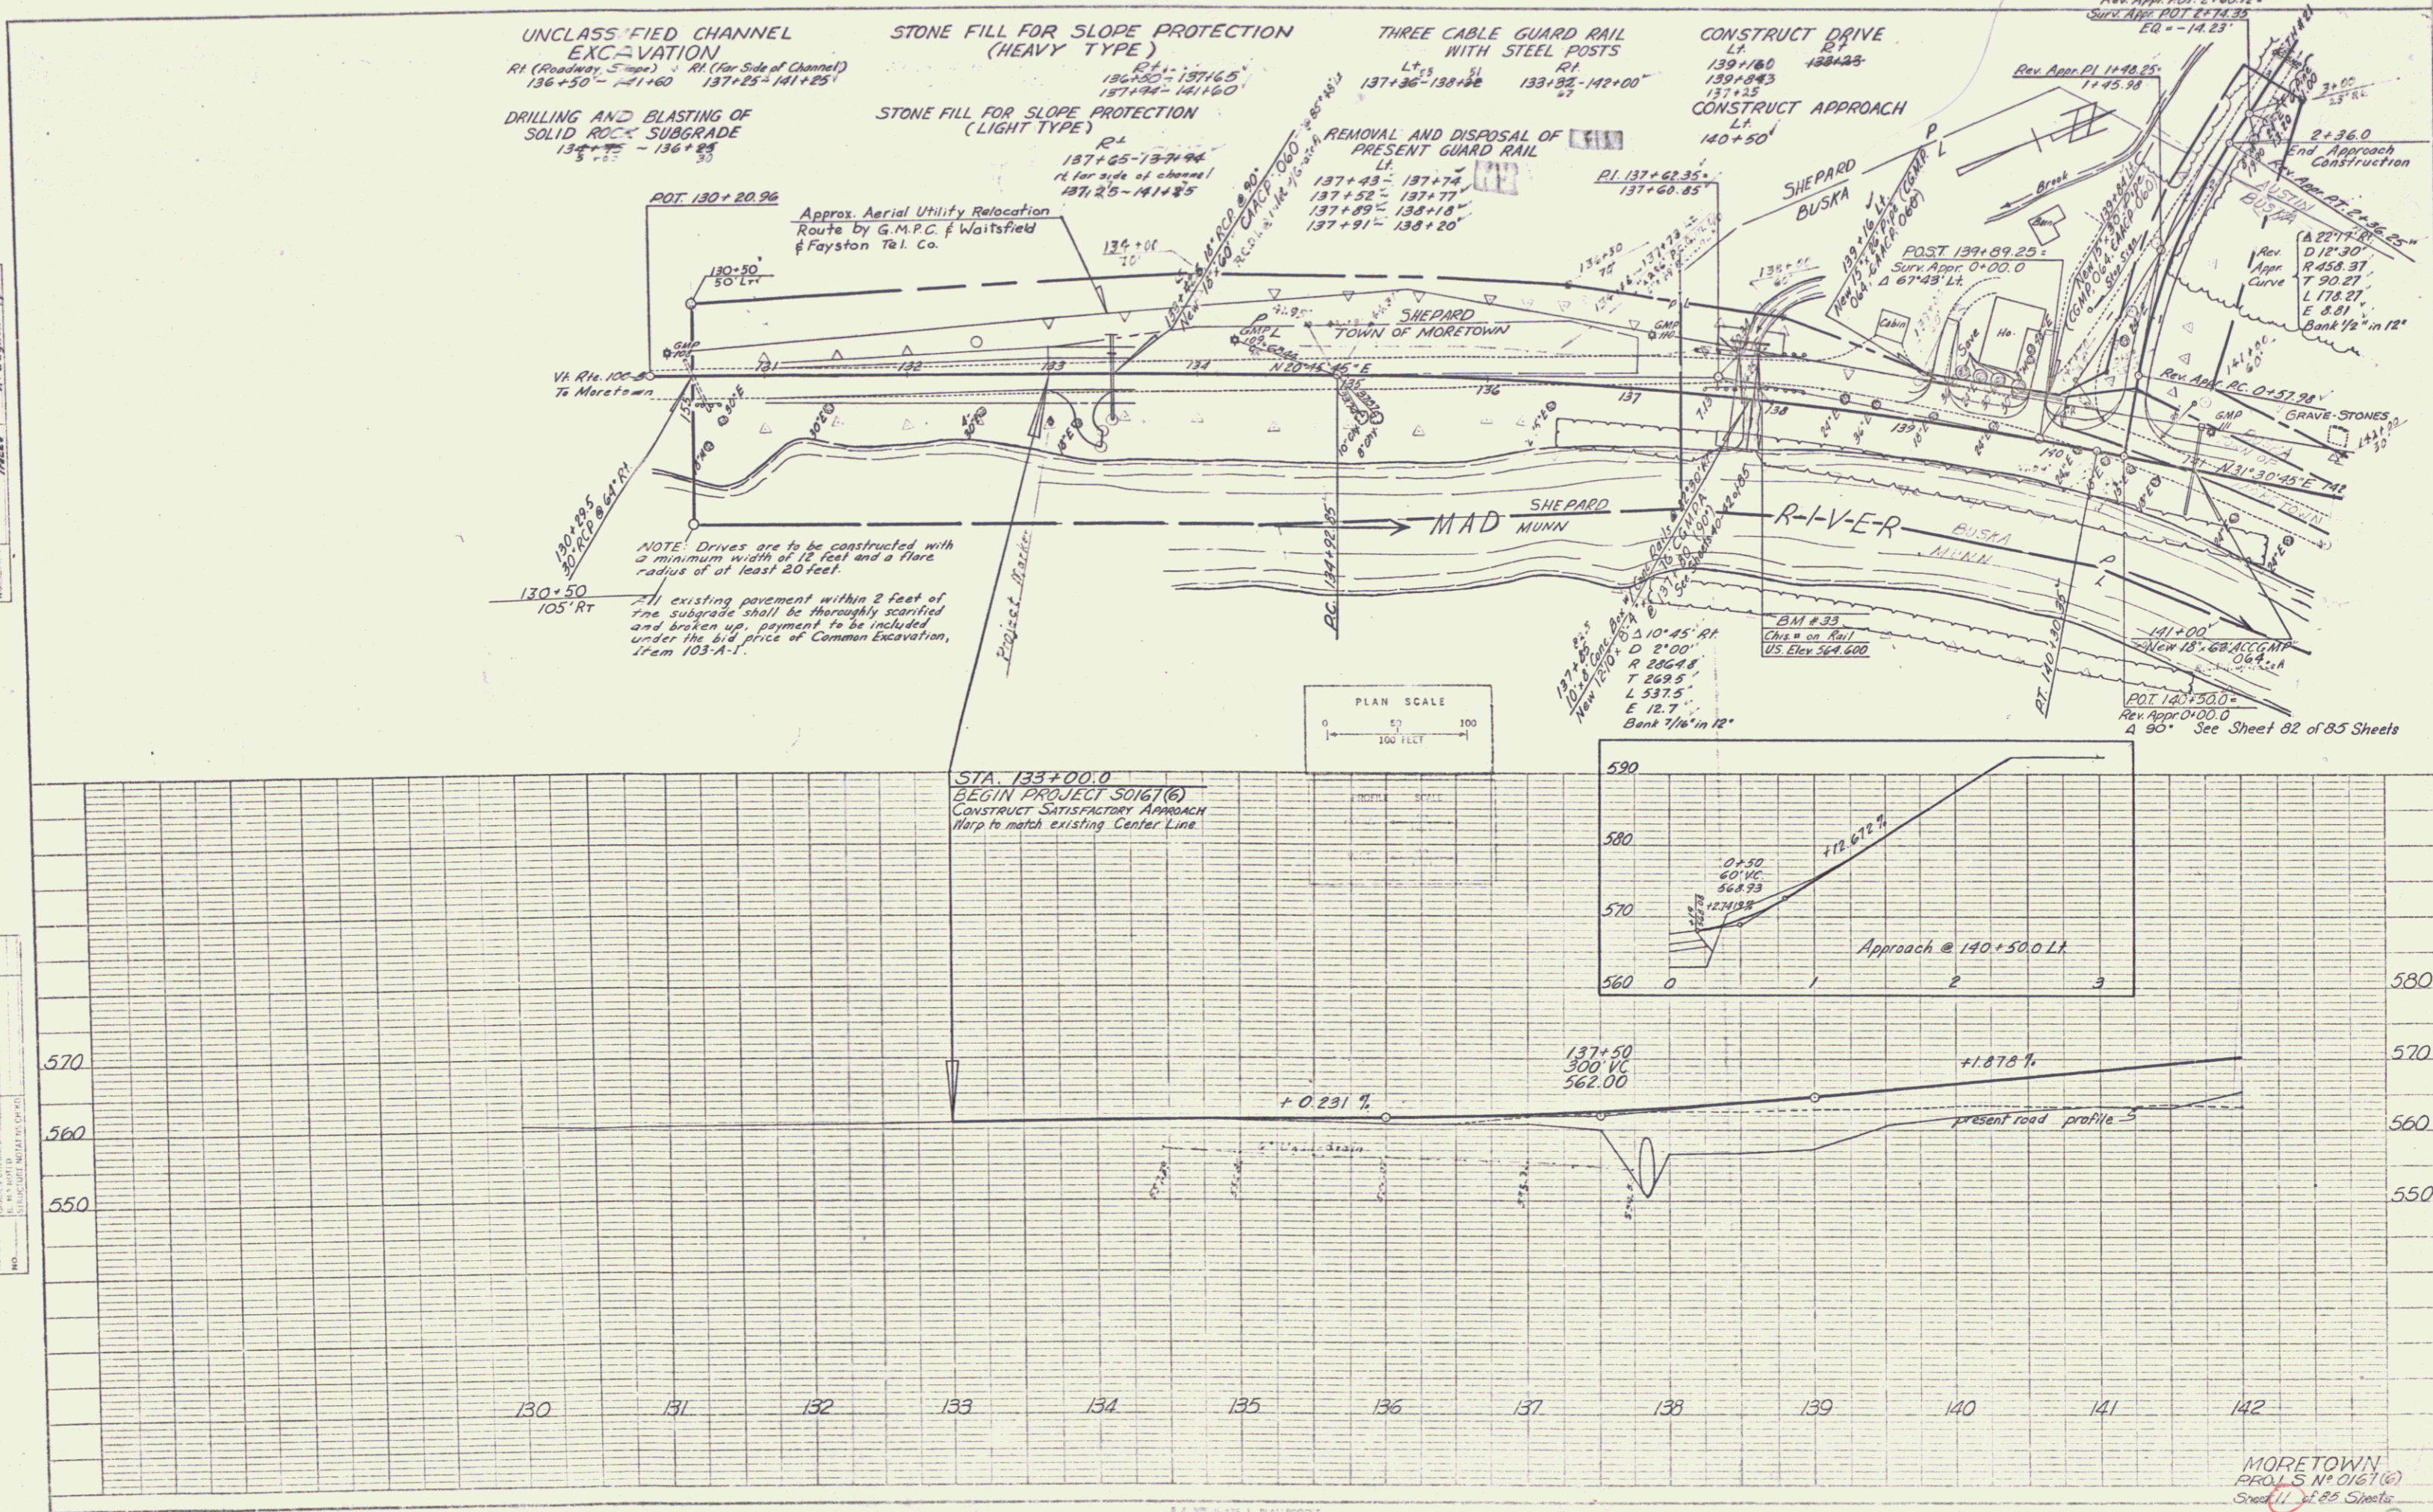

MORETOWN  
 PROJ. S No 0167(6)  
 Sheet 11 of 85 Sheets  
 3