


POOR ORIGINAL COPY

- DEMOLITION & DISPOSAL OF BUILDING
- #1 11+20 LT. Rte. 14 GAR.
 - #2 13+70 RT. " " AUTO SERV.
 - #3 16+30 RT. " " STORE
 - #4 17+00 RT. " " GAS STA.

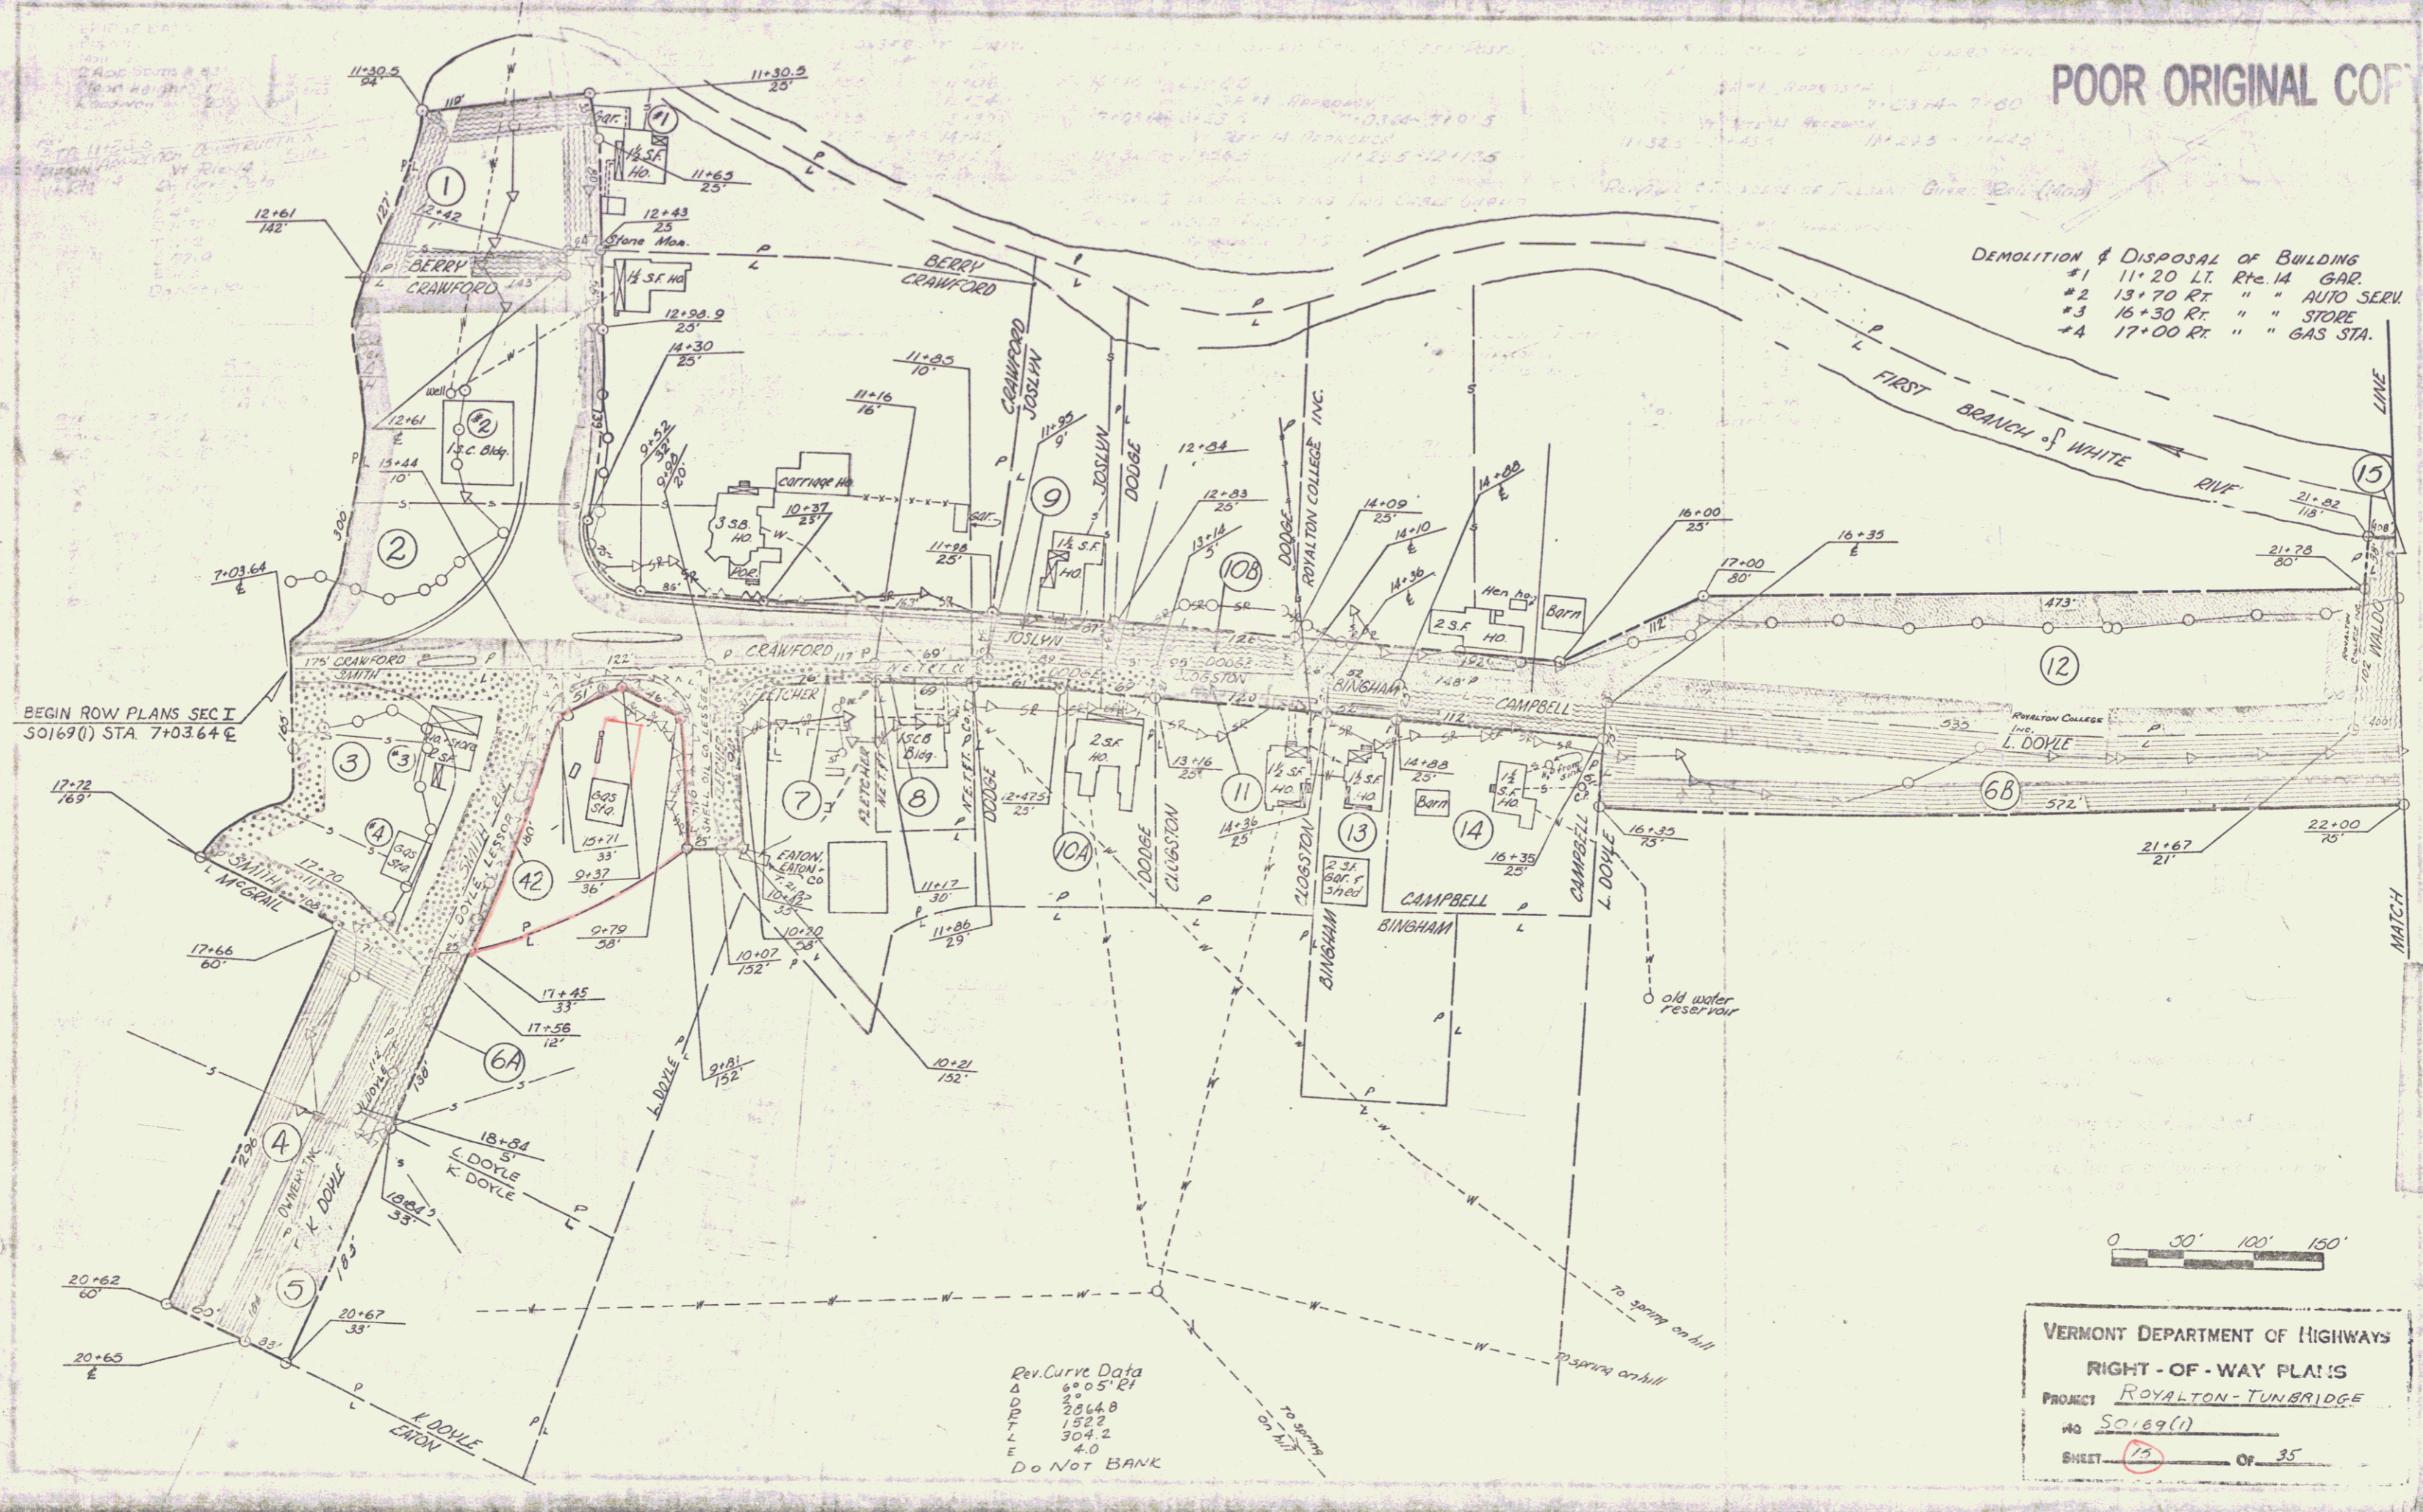

BEGIN ROW PLANS SECT
50169(1) STA 7+03.64 E

Rev. Curve Data
 6° 05' R
 286.8
 152.2
 304.2
 4.0
 Do NOT BANK

VERMONT DEPARTMENT OF HIGHWAYS
 RIGHT-OF-WAY PLANS
 PROJECT ROYALTON-TUNBRIDGE
 NO 50169(1)
 SHEET 15 OF 35

4