THREE CABLE GUARD RAIL
w/ STEEL POSTS
Lt.
22+00~~30+00~~
~~31+10~~ ~32+~~00~~
App @ 31+00 Lt
Lt.
~~29+02~~ ~~32+50~~
28+06 ~30+00

DRILLING & BLASTING OF
SOLID ROCK SUBGRADE
~~31+25~~ ~36+00'
6+00

CONSTRUCT APPROACH
Lt
~~31+00~~
28+50

CONSTRUCT DRIVE
Lt
29+00~30+90
32+60

DEMOLITION AND DISPOSAL
OF BUILDING
#4 25+00 Lt #4a 24+00 Lt
#6 31+12 ℄ #4b 30+80 Rt

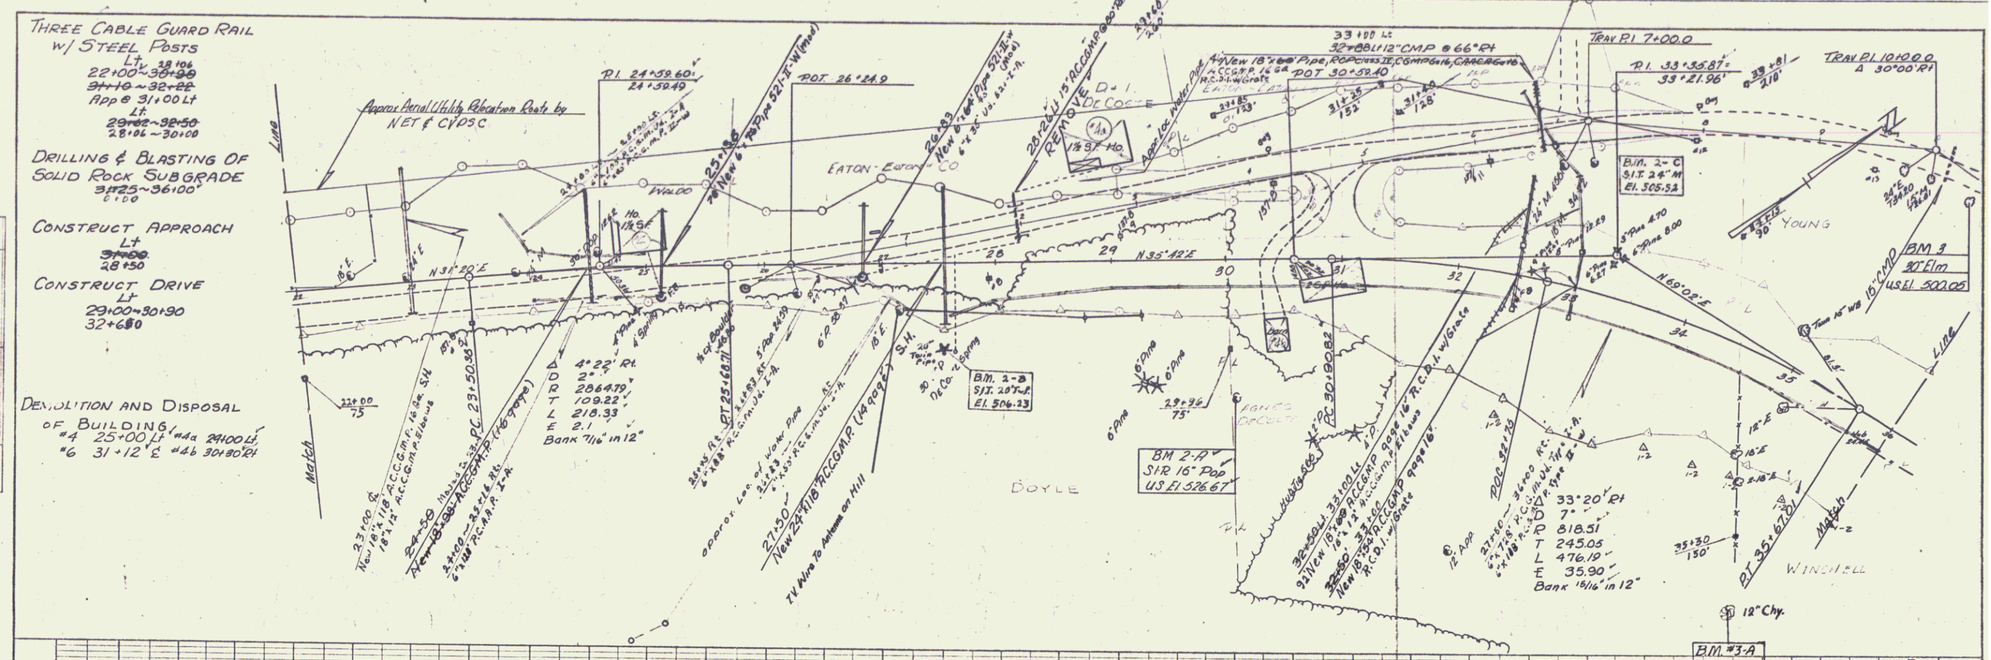

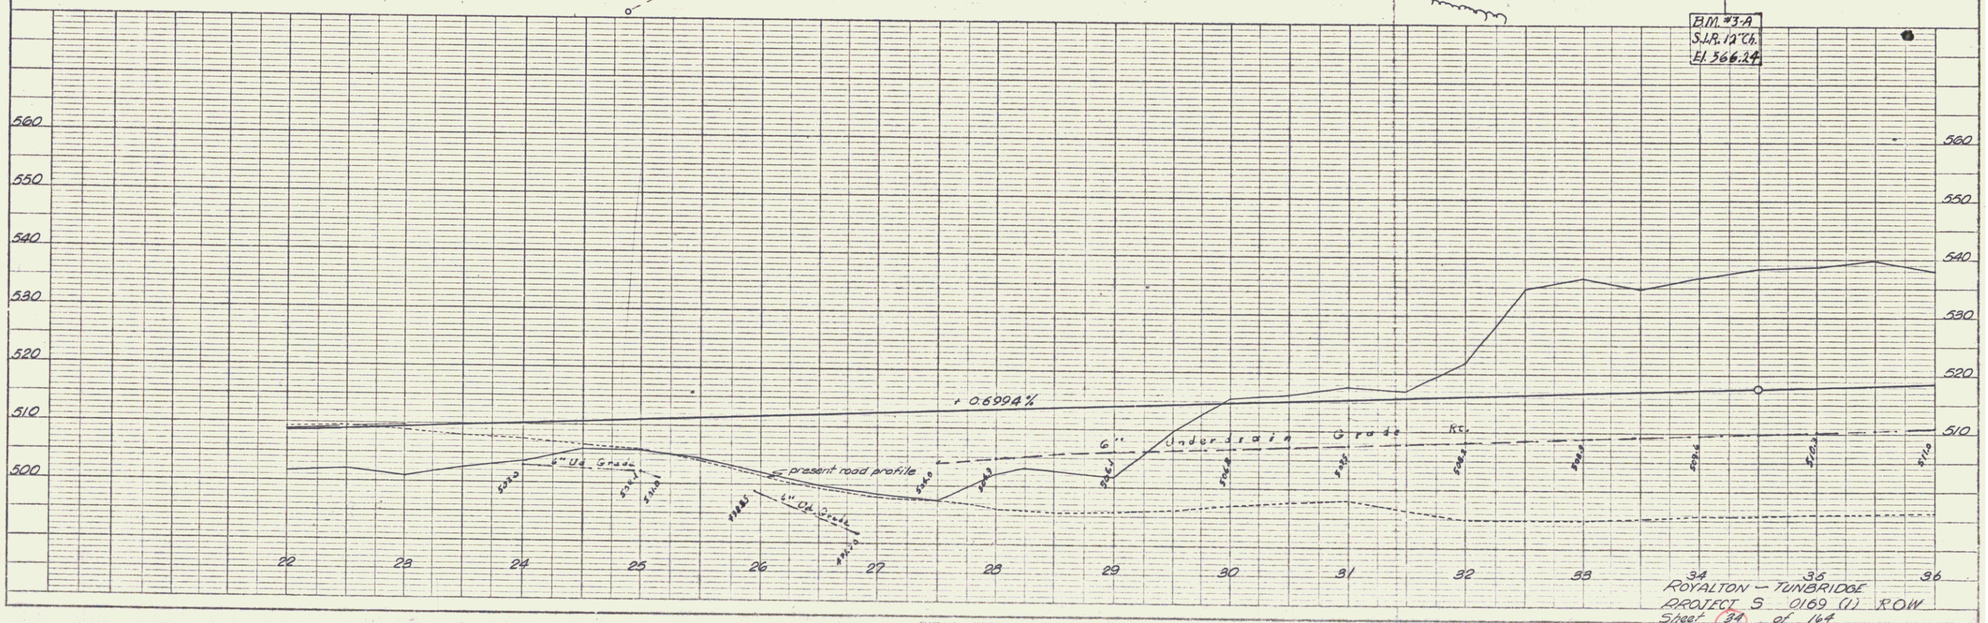

ROYALTON – TUNBRIDGE
PROJECT S 0169 (1) ROW
Sheet 34 of 164

PLAN
Designed: Harrington
Checked:
Checked:
Checked:
Note Book:
No.:

PROFILE
Designed: Mitchell
Checked: C.E.H.
Checked:
Checked:
Note Book:
No.:

FLATE 1 - PLAN - PROFILE - A.P.W.A. & A.R.E.A. STANDARD