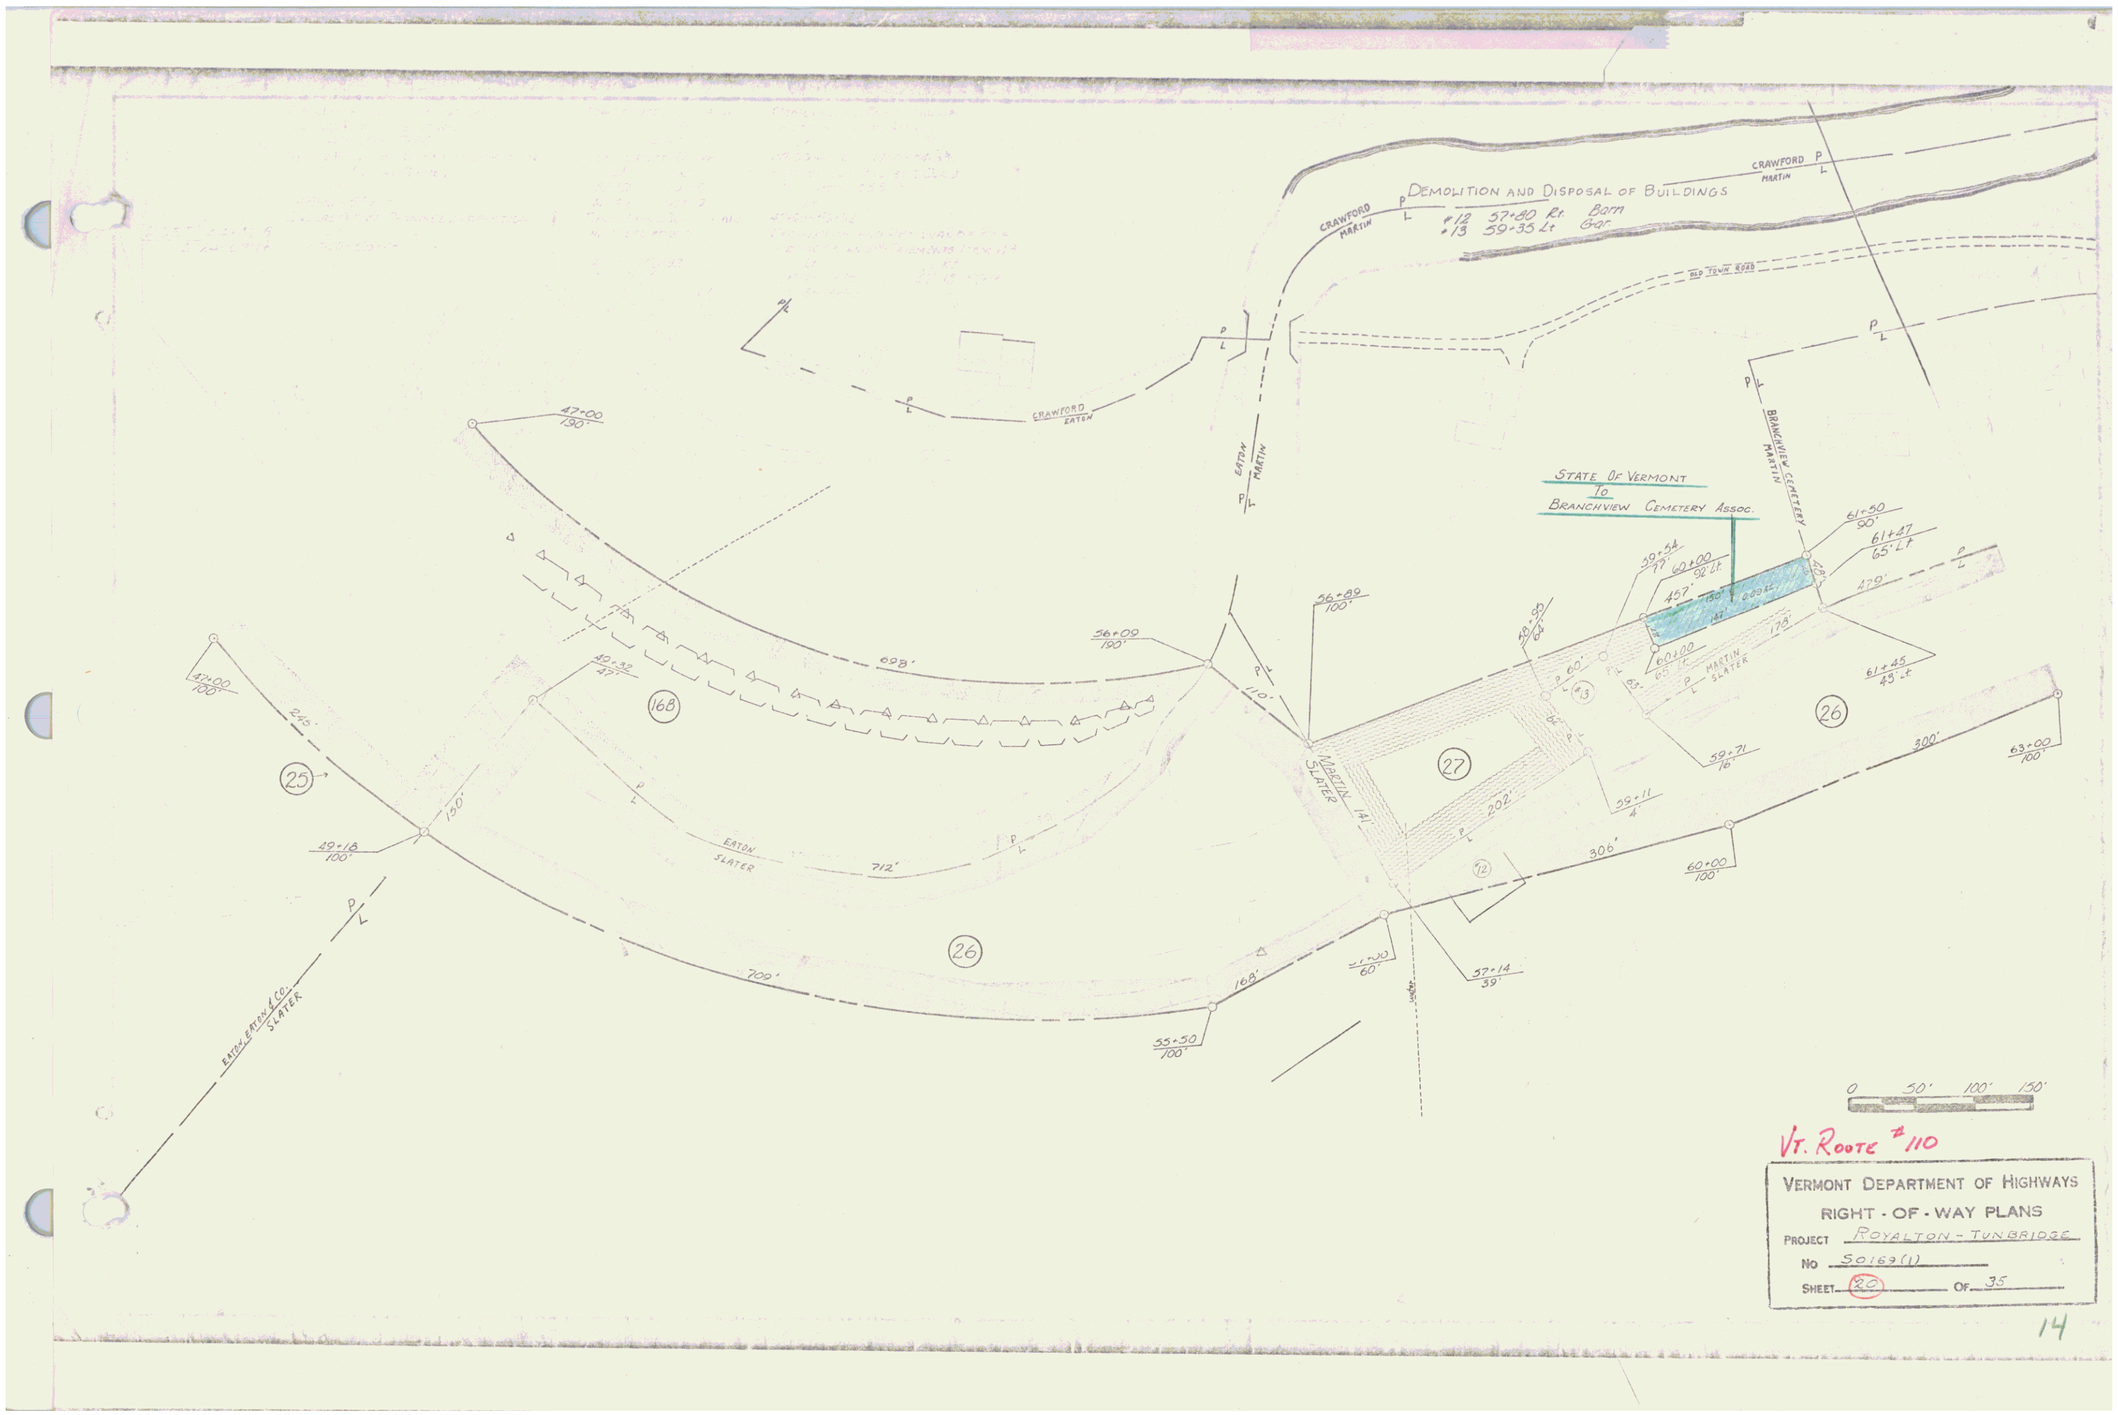
DEMOLITION AND DISPOSAL OF BUILDINGS
#12 57+80 Rt Barn
#13 59+35 Lt Gar.
CRAWFORD
MARTIN
OLD TOWN ROAD
CRAWFORD
EATON
EATON
MARTIN
BRANCHVIEW CEMETERY
MARTIN
STATE OF VERMONT
TO
BRANCHVIEW CEMETERY ASSOC.
MARTIN
SLATER
EATON
SLATER
EATON & EATON & CO.
SLATER
47+00
190'
47+00
100'
49+32
47'
49+18
100'
56+09
190'
56+89
100'
55+50
100'
57+14
59'
59+11
4'
59+71
16'
60+00
100'
61+50
50'
61+47
65' Lt
61+45
49' Lt
63+00
100'
59+54
77'
60+00
92' Lt
60+00
65' Lt
698'
712'
700'
306'
300'
479'
457'
202'
168'
110'
168
25
26
27
72
43
0 50' 100' 150'
Vt. Route #110
VERMONT DEPARTMENT OF HIGHWAYS
RIGHT - OF - WAY PLANS
PROJECT ROYALTON - TUNBRIDGE
NO S0169(1)
SHEET 20 OF 35