

PLAN
 DATE: 1/16/68
 DRAWN BY: [Signature]
 CHECKED BY: [Signature]
 IN CHARGE: [Signature]
 NO. 1
 NOTE: BOUNDARY ADJACENT CHECKED.
 RT. OF WAY CHECKED.

PROFILE
 DATE: 1/16/68
 DRAWN BY: [Signature]
 CHECKED BY: [Signature]
 IN CHARGE: [Signature]
 NO. 1
 NOTE: BOUNDARY ADJACENT CHECKED.
 RT. OF WAY CHECKED.

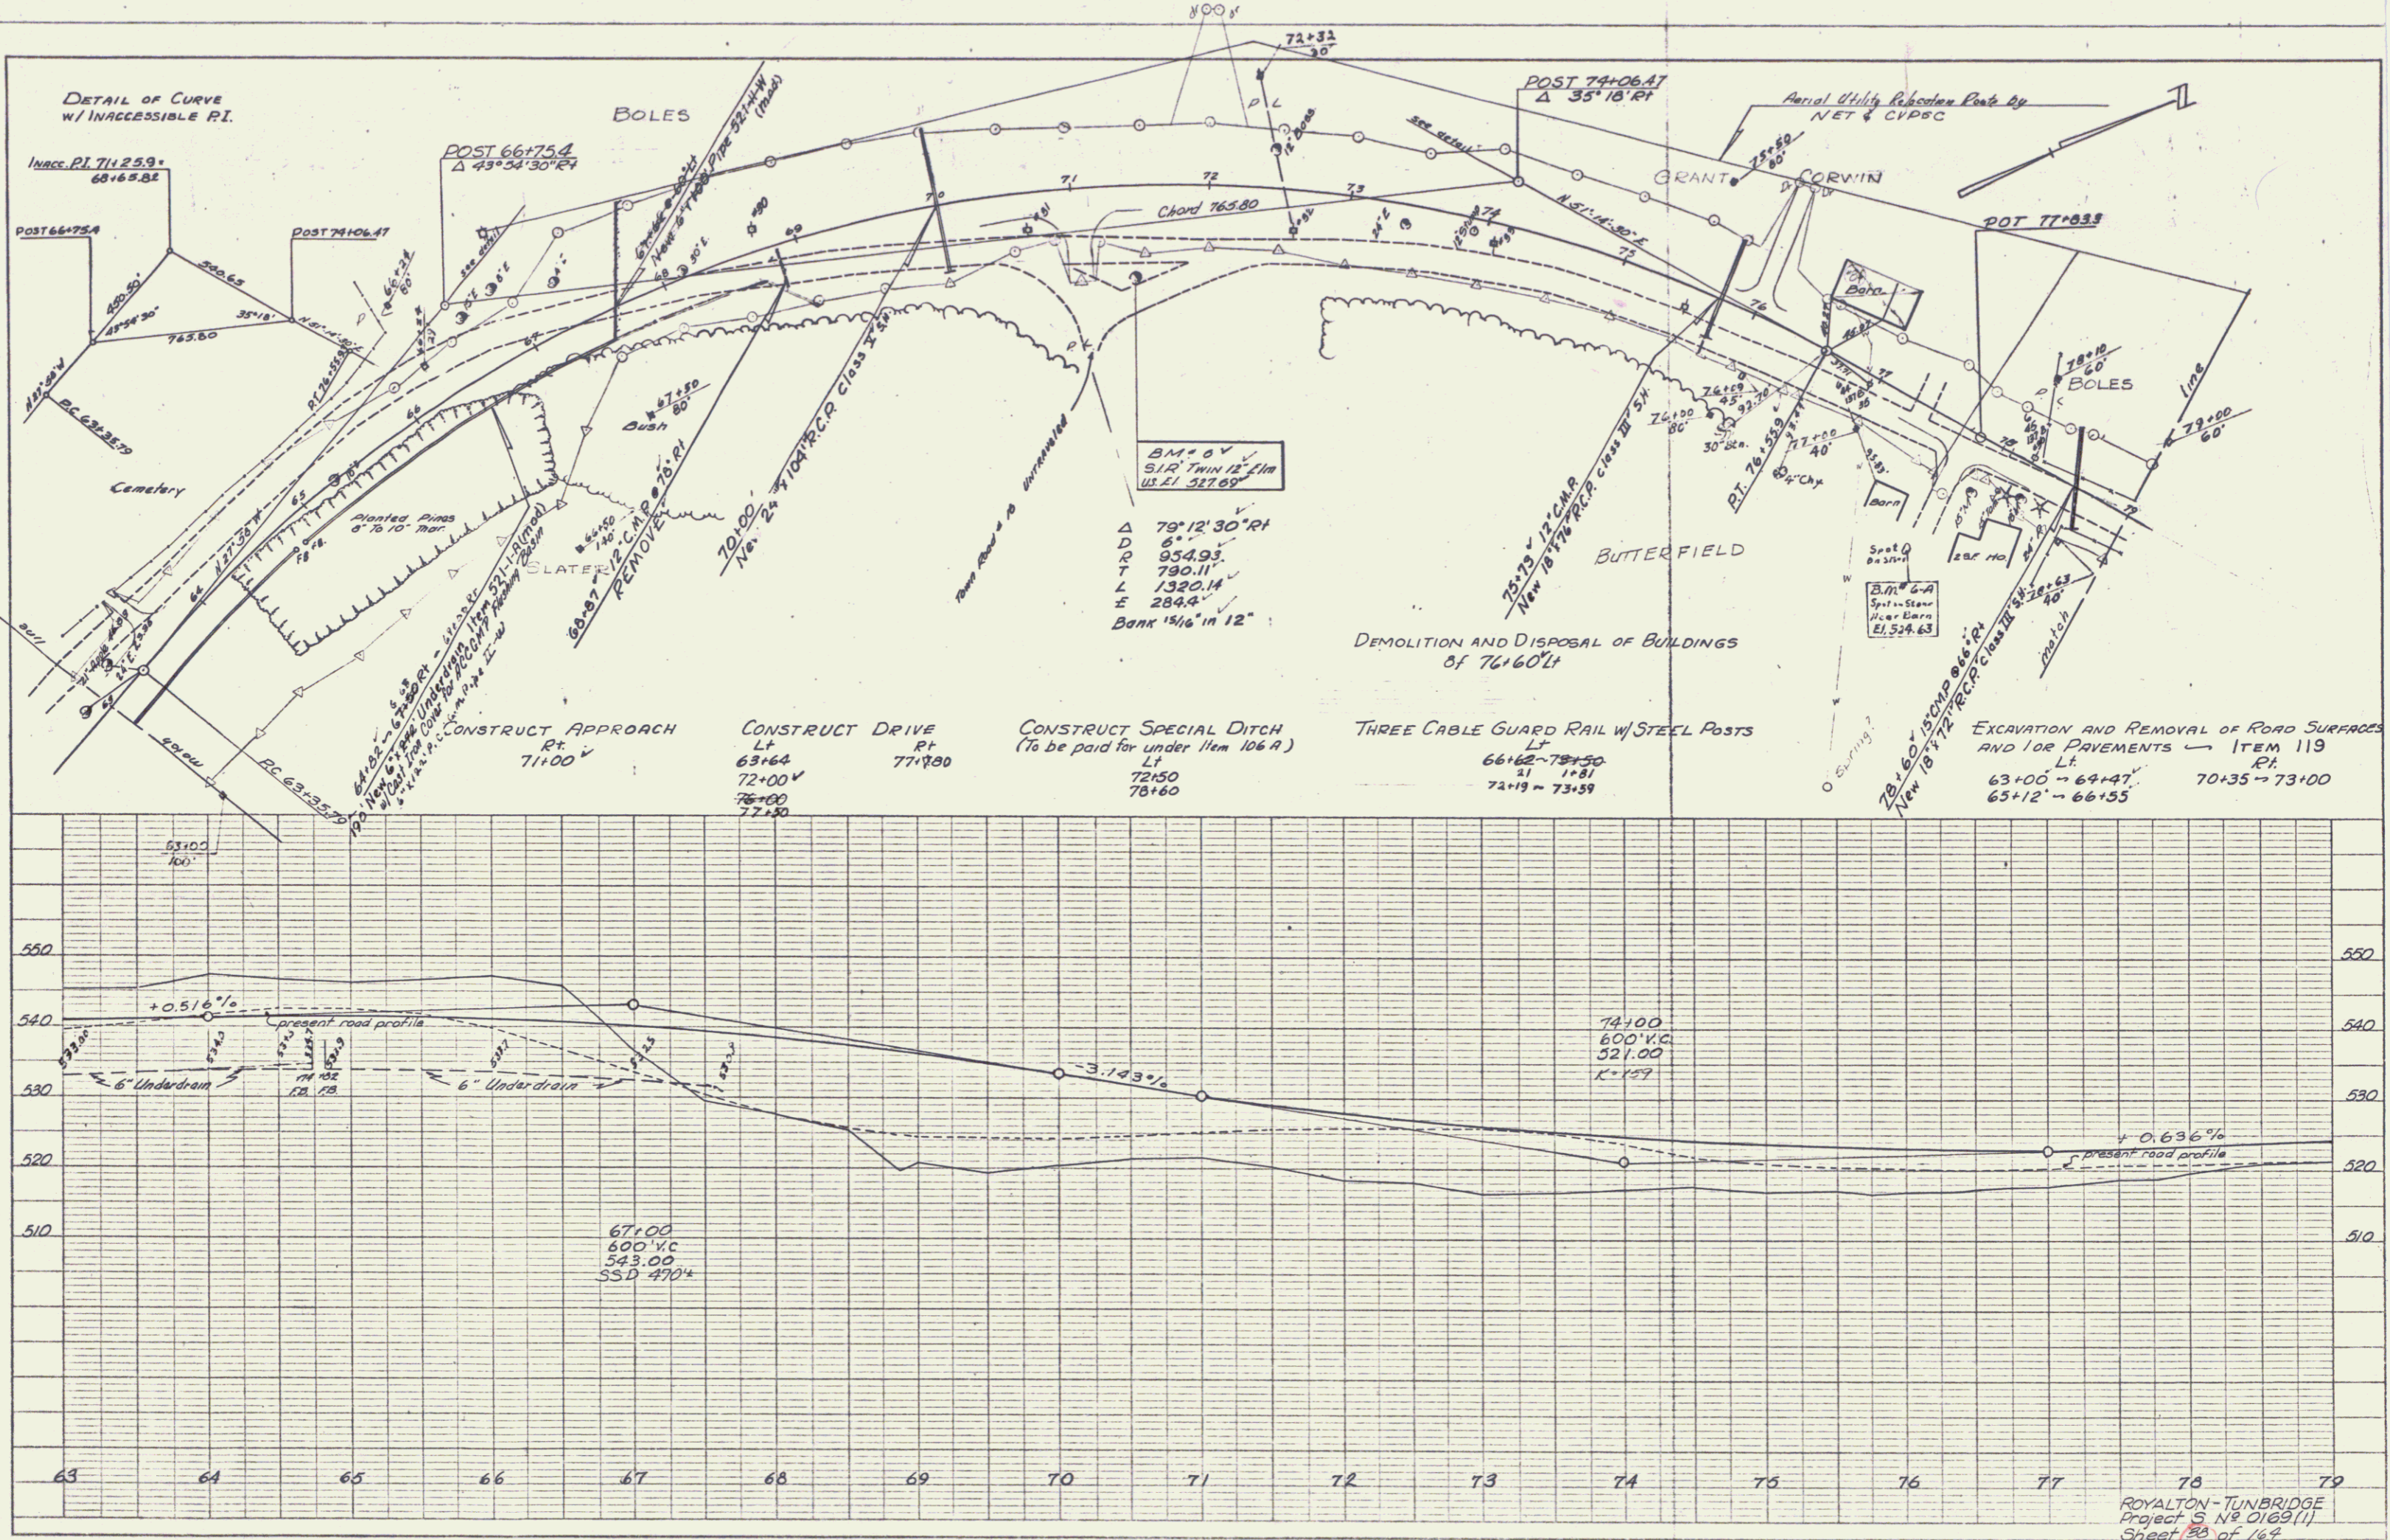



ROYALTON-TUNBRIDGE
 Project S No 0169(1)
 Sheet 28 of 164