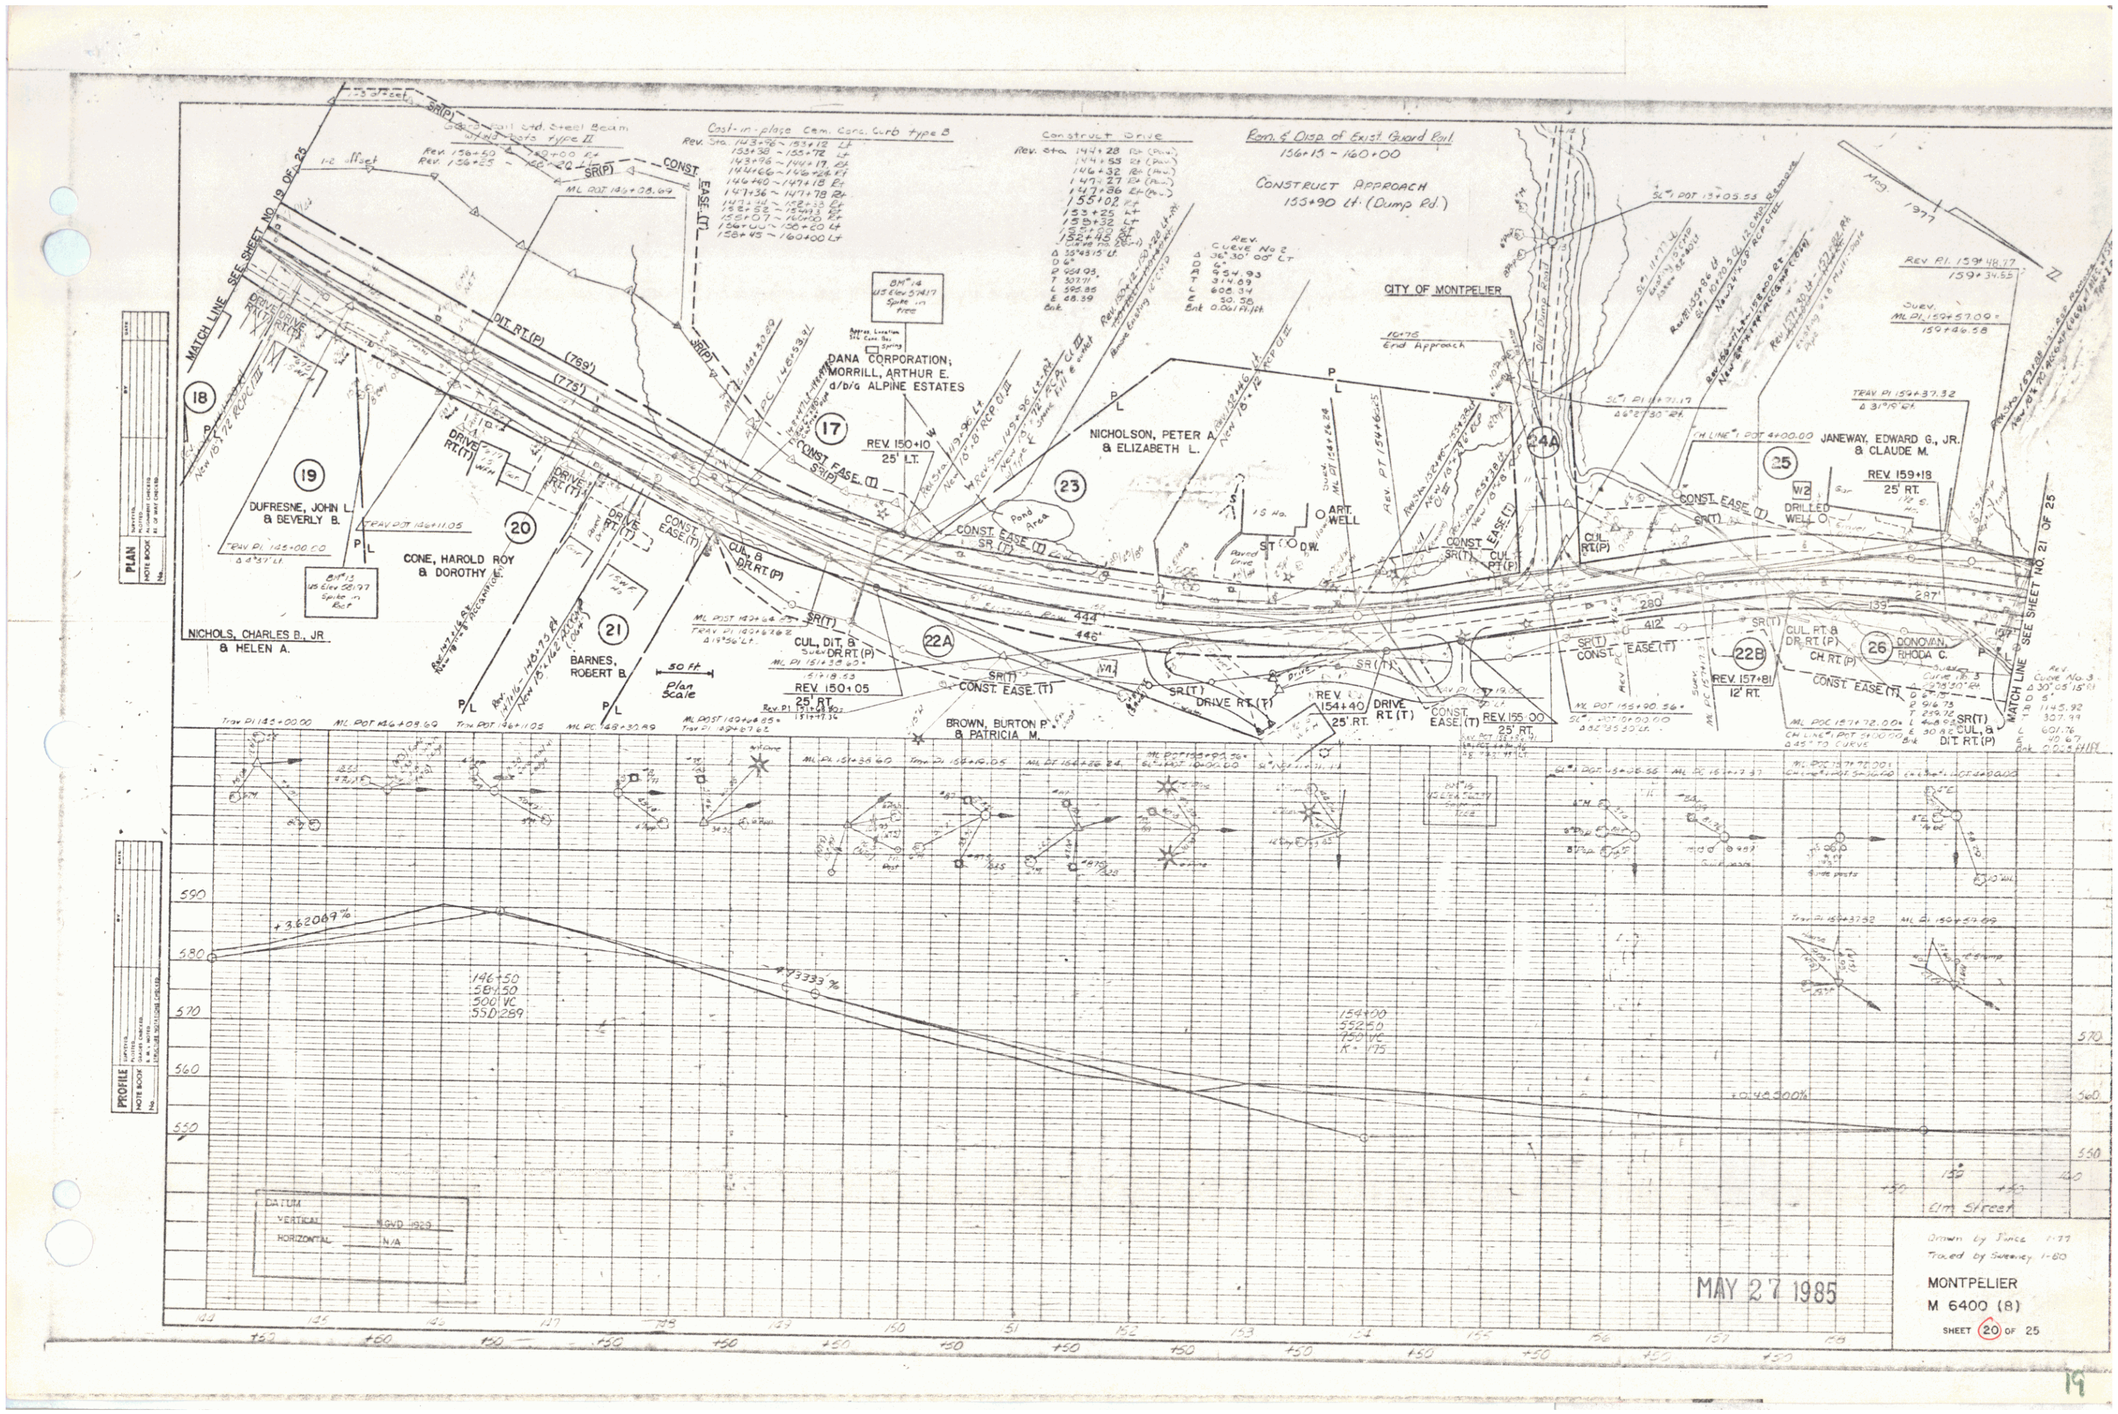
MATCH LINE SEE SHEET NO. 19 OF 25
MATCH LINE SEE SHEET NO. 21 OF 25
Cast-in-place Cem. Conc. Curb type B
Construct Drive
Rem. & Disp of Exist Guard Rail
156+13 ~ 160+00
CONSTRUCT APPROACH
153+90 Lt. (Dump Rd.)
CITY OF MONTPELIER
DANA CORPORATION; MORRILL, ARTHUR E. d/b/a ALPINE ESTATES
NICHOLSON, PETER A. & ELIZABETH L.
JANEWAY, EDWARD G., JR. & CLAUDE M.
DUFRESNE, JOHN L. & BEVERLY B.
CONE, HAROLD ROY & DOROTHY C.
NICHOLS, CHARLES B., JR. & HELEN A.
BARNES, ROBERT B.
BROWN, BURTON P. & PATRICIA M.
DONOVAN, RHODA C.
REV. 150+10 25' LT.
REV. 150+05 25' RT.
REV. 154+40 25' RT.
REV. 155.00 25' RT.
REV. 157+81 12' RT.
REV. 159+18 25' RT.
Plan Scale 50 ft
Elm Street
DATUM
VERTICAL NGVD 1929
HORIZONTAL N/A
MAY 27 1985
Drawn by Tince 1-77
Traced by Sweeney 1-80
MONTPELIER
M 6400 (8)
SHEET 20 OF 25
PLAN
PROFILE

19