

PLAN




PROFILE



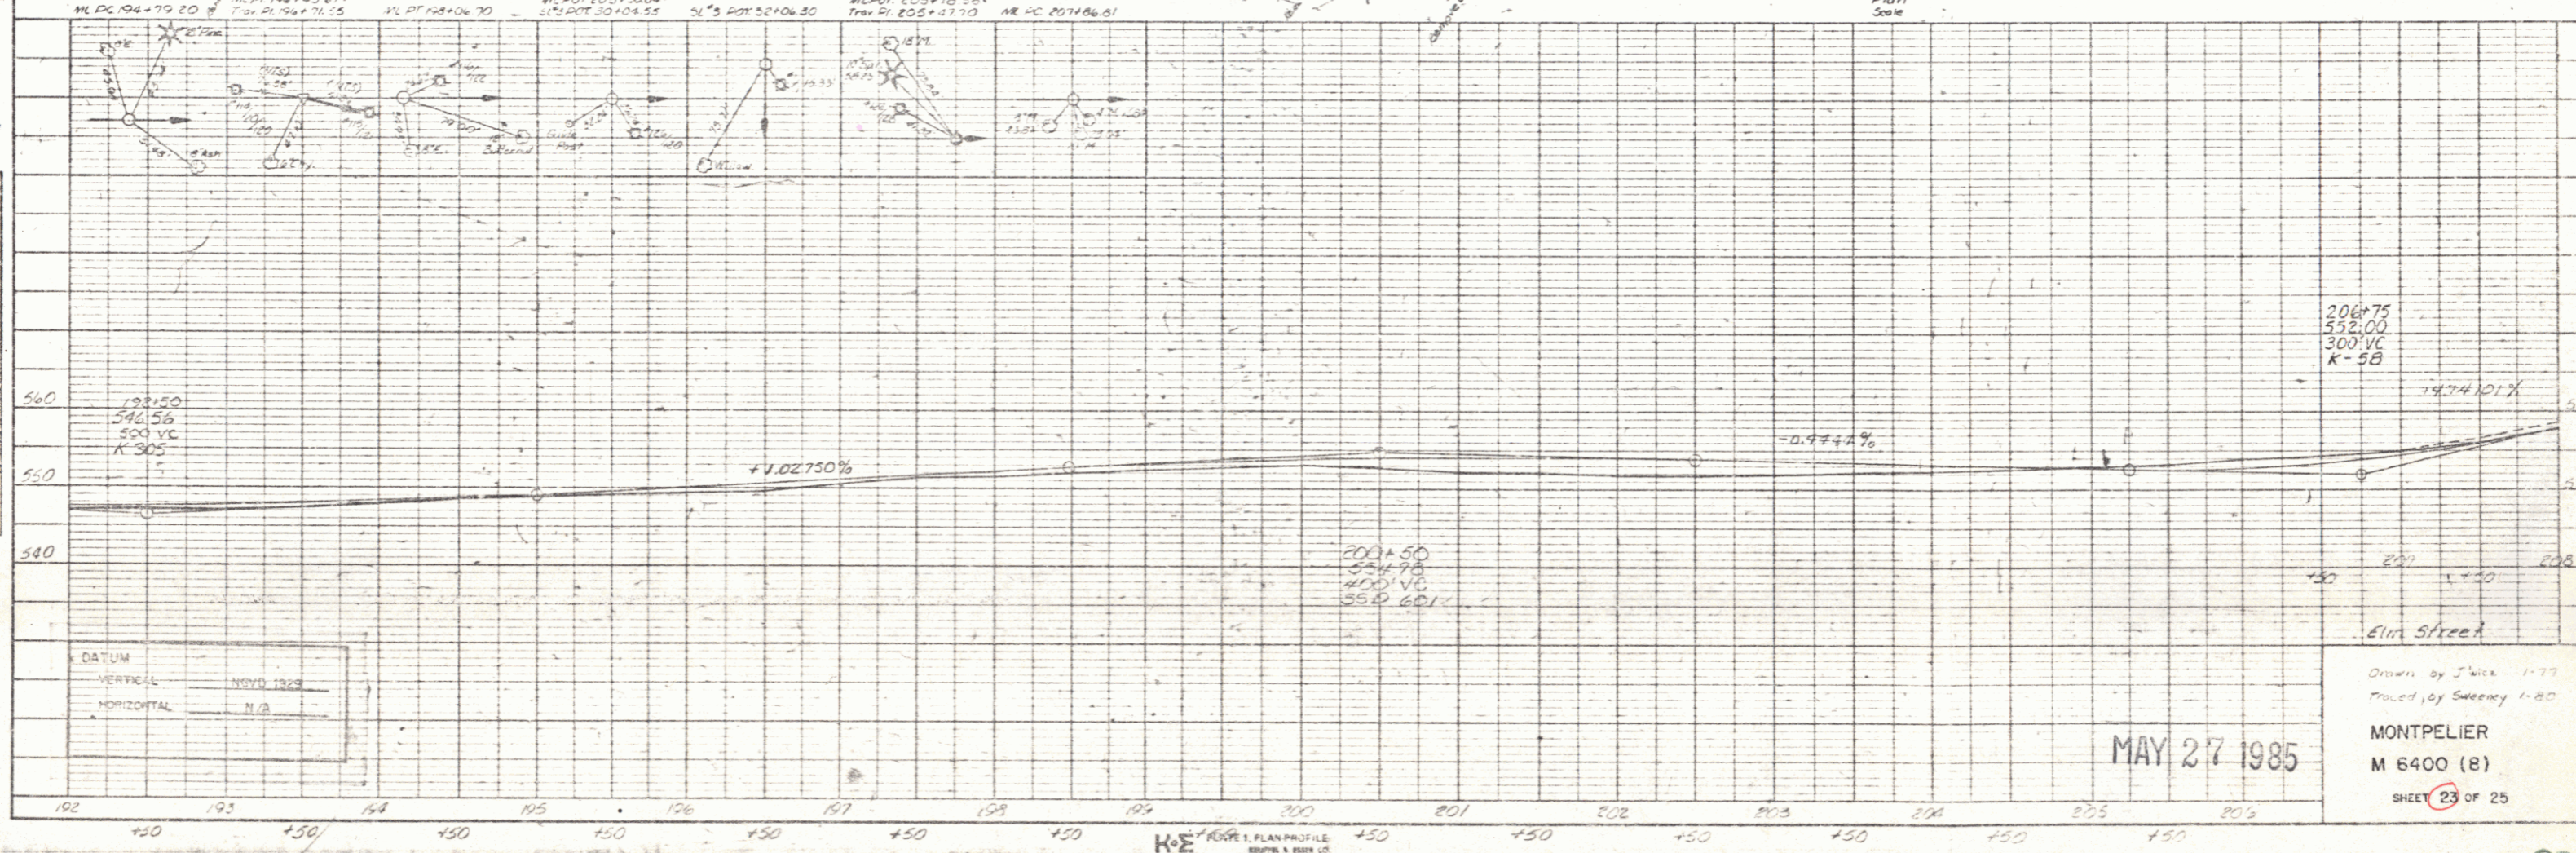

ML PC 196+79.20
 MPT 196+43.67
 MPT 196+06.70
 MPT 195+20.04
 MPT 195+04.55
 MPT 195+00.30
 MPT 195+18.58
 MPT 195+37.70

206+75
 552.00
 300' VC
 K=58

DATUM



MAY 27 1985

Drawn by J. Wick 1-77
 Placed by Sweeney 1-80
 MONTPELIER
 M 6400 (B)
 SHEET 23 OF 25