STONE FILL, Type II
Lt Rt
401+00 ~ 408+40

CONSTRUCT DRIVE
Lt Rt
416+90

ALL DRIVES AS INDICATED ON PLANS ARE SUBJECT TO PERMITS PURSUANT TO TITLE 19, SECTION 43, V.S.A.

UNCLASSIFIED CHANNEL EXCAVATION
Lt Rt
407+00 ~ 408+40

POT 4.4 & 35.2

GUARD RAIL, THREE CABLE w/ LIGHT WOOD POSTS
Lt Rt
407+00 ~ 411+58

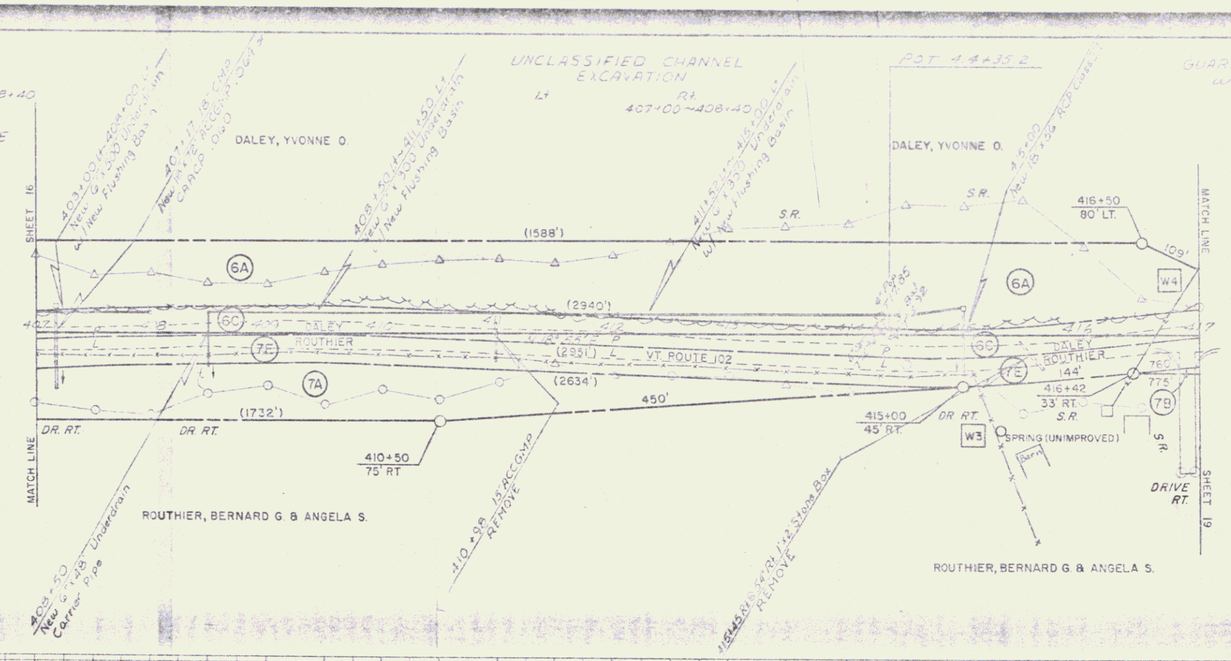

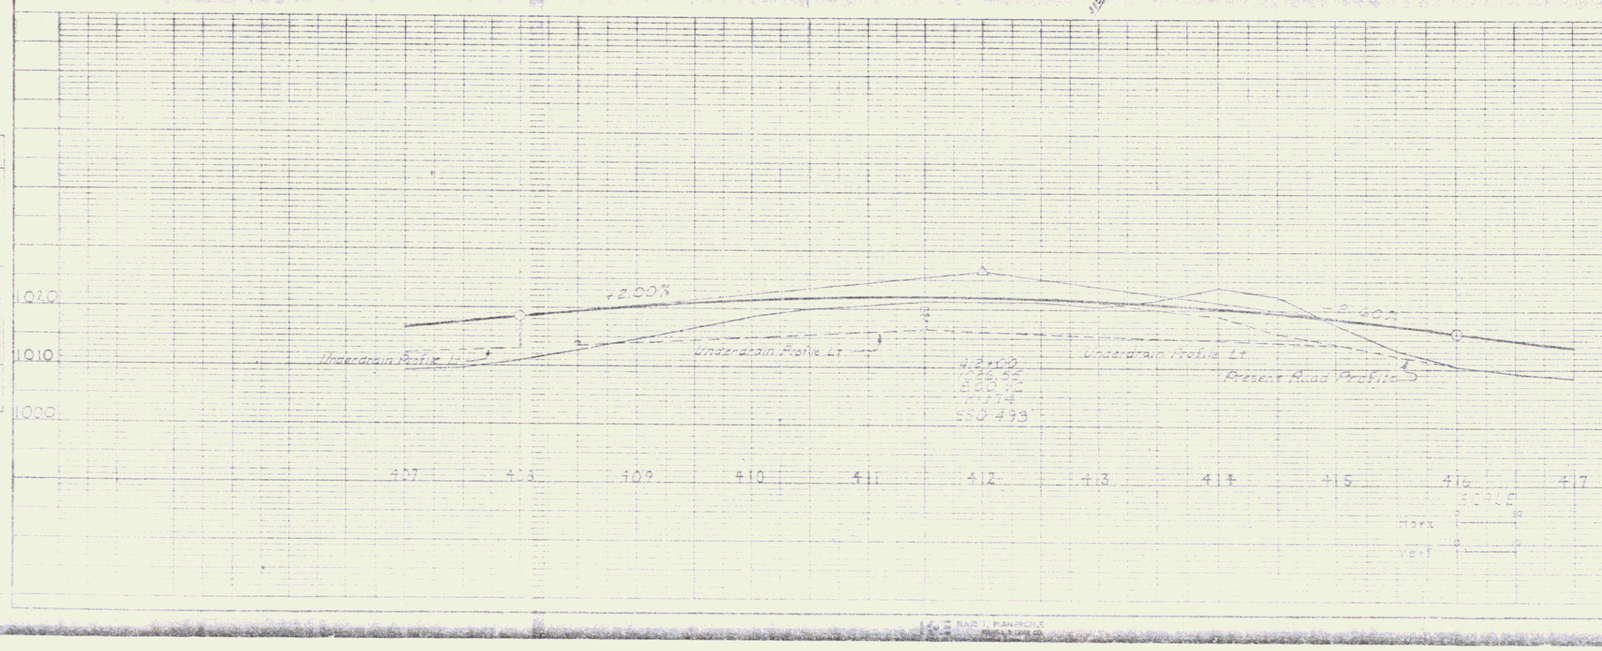

APR 04 1986

18 27

13