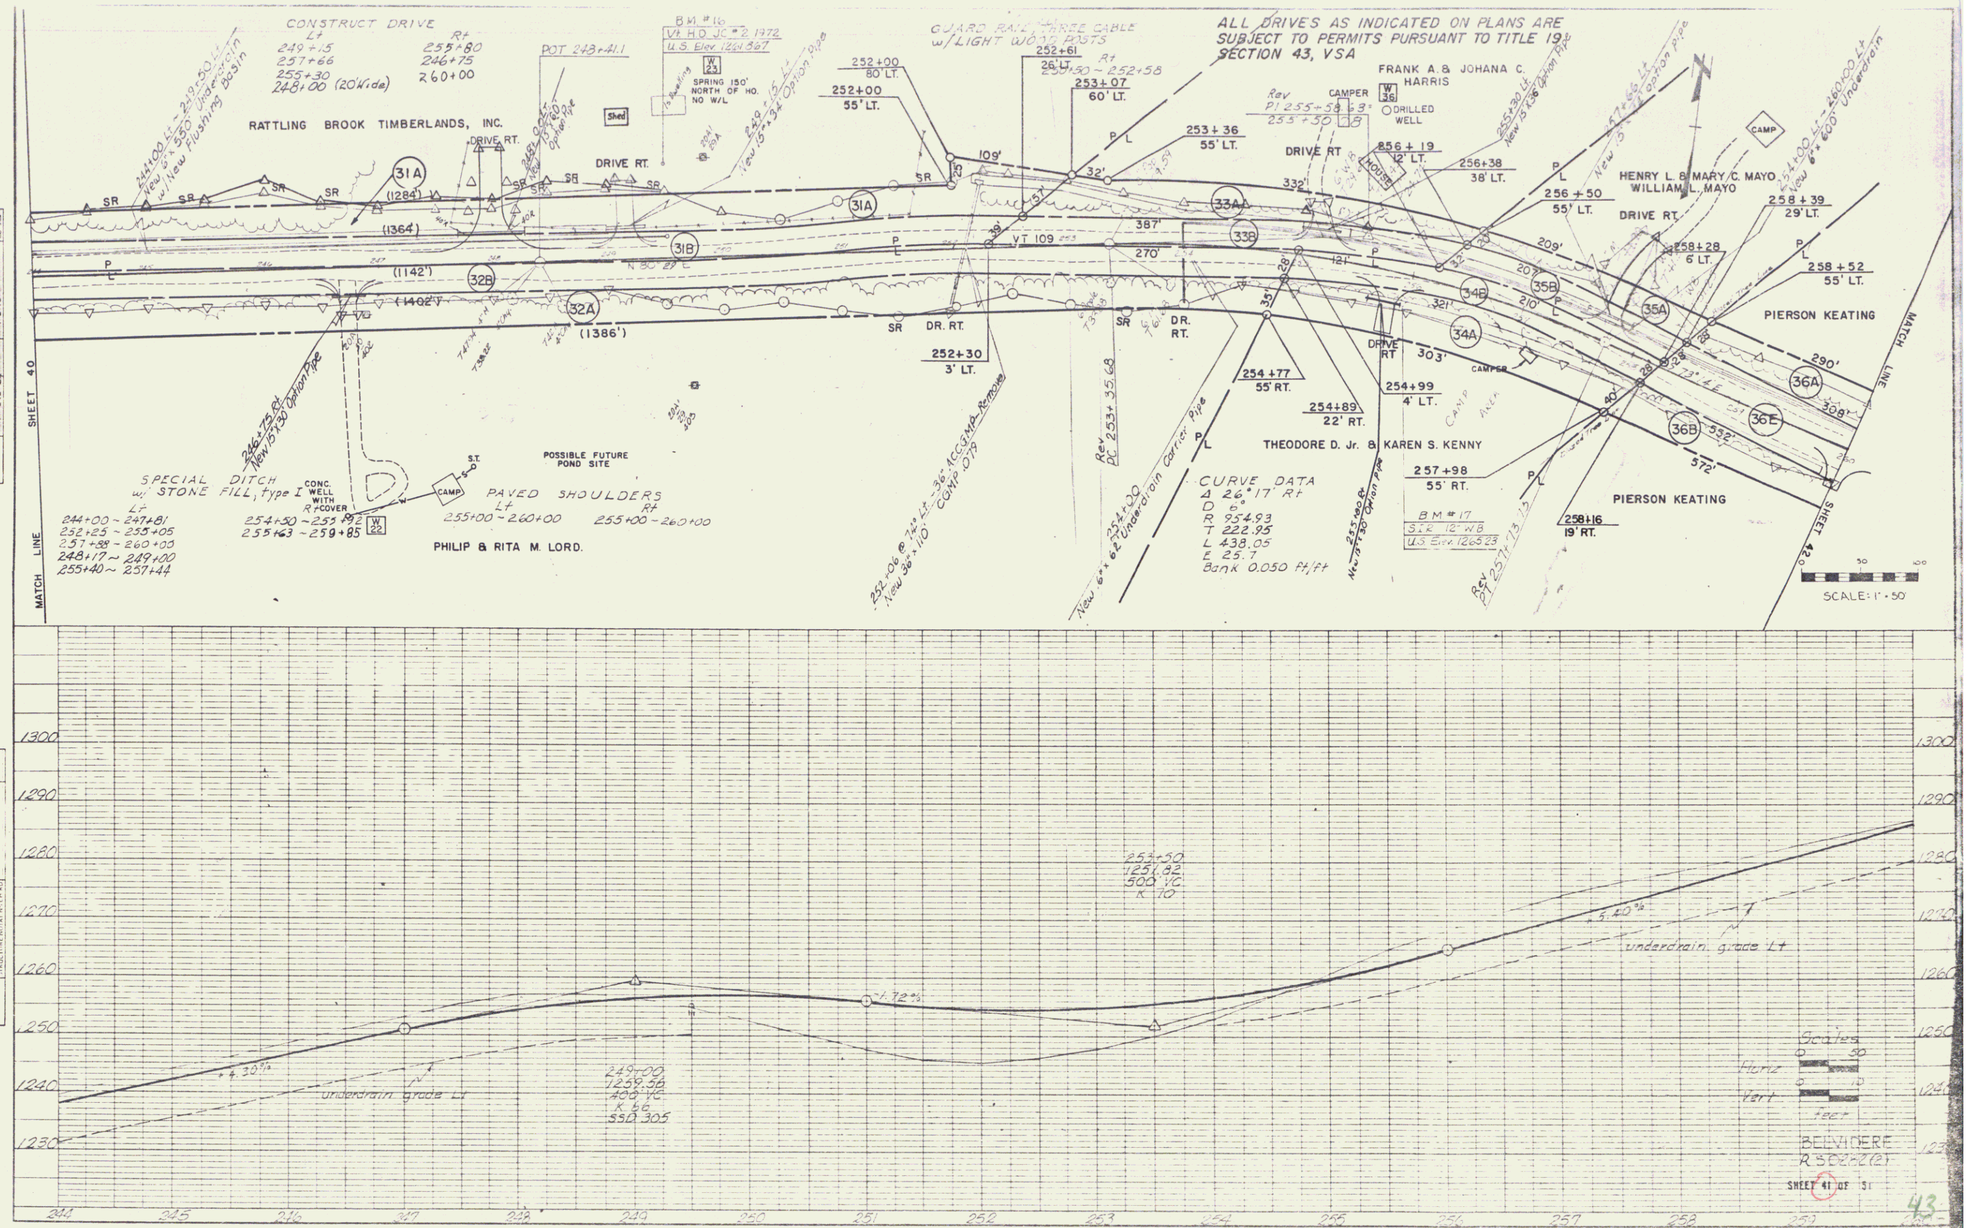
CONSTRUCT DRIVE
Lt
249+15
257+66
255+30
248+00 (20' Wide)
Rt
255+80
246+75
260+00
RATTLING BROOK TIMBERLANDS, INC.
DRIVE RT.
POT 248+41.1
B.M. #16
VT HO JC #2 1972
U.S. Elev. 1260.367
SPRING 150' NORTH OF HO. NO W/L
Shed
GUARD RAIL THREE CABLE w/LIGHT WOOD POSTS
ALL DRIVES AS INDICATED ON PLANS ARE SUBJECT TO PERMITS PURSUANT TO TITLE 19 SECTION 43, VSA
FRANK A. & JOHANA C. HARRIS
CAMPER
DRILLED WELL
HOUSE
HENRY L. & MARY C. MAYO
WILLIAM L. MAYO
PIERSON KEATING
THEODORE D. Jr. & KAREN S. KENNY
PIERSON KEATING
MATCH LINE
SHEET 40
SHEET 42
SPECIAL DITCH w/ STONE FILL, Type I
CONC. WELL WITH R' COVER
POSSIBLE FUTURE POND SITE
PAVED SHOULDERS
PHILIP & RITA M. LORD.
CURVE DATA
Δ 26°17' Rt
D 6°
R 954.93
T 222.95
L 438.05
E 25.7
Bank 0.050 ft/ft
BM #17
U.S. Elev. 1265.23
SCALE: 1" = 50'
PLAN
PROFILE
underdrain grade Lt
underdrain grade Rt
Grades
Horiz
Vert
BELVIDERE
R 5002(2)
SHEET 41 OF 51
K+E PLATE 1, PLAN-PROFILE
KEUFFEL & ESSER CO.