

1/2" SAND GRAIN  
1/32" + 1/16" 23

CONSTRUCT DRIVE  
LT. 202+40  
RT. 193+43  
197+00

STONE FILL TYPE II  
177+70 198+0

END MAINT. AGREE. AREA NO. 3  
STA. 198+70 11' RT.

ALL DRIVES AS INDICATED ON  
PLANS ARE SUBJECT TO PER-  
MITS PURSUANT TO TITLE 19,  
SECTION 43, V.S.A.

MERRITT, WILLIAM H.


HILL, AULIS A. & LILLIAN M.

POOR ORIGINAL COPY

KARPOVICH, SERGE & MARGARET

BEGIN MAINT. AGREE. AREA NO. 3  
STA. 198+70 129' RT. LENGTH (118')

PLAN SCALE  
50  
100 FEET

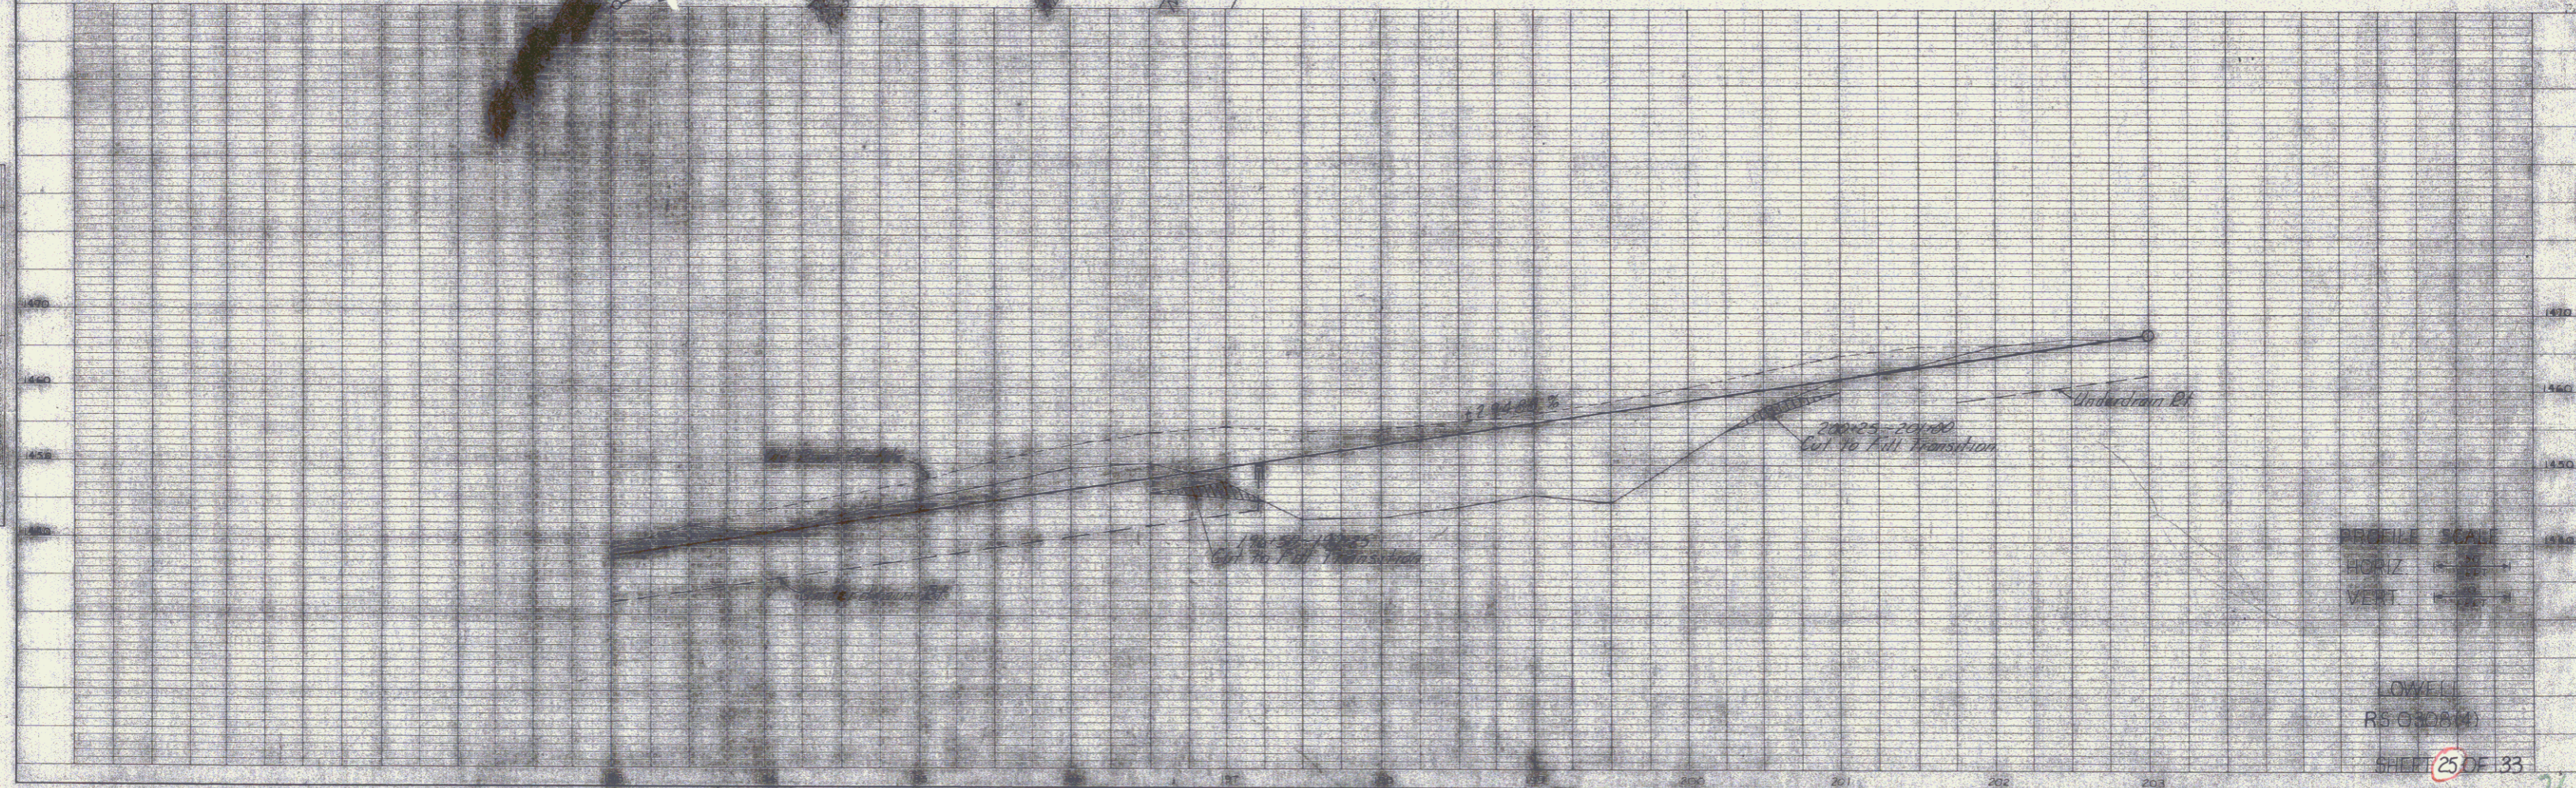

PROFILE SCALE  
HORIZ. 1"=100'  
VERT. 1"=10'


SHEET 25 OF 33

26