


POOR ORIGINAL COPY

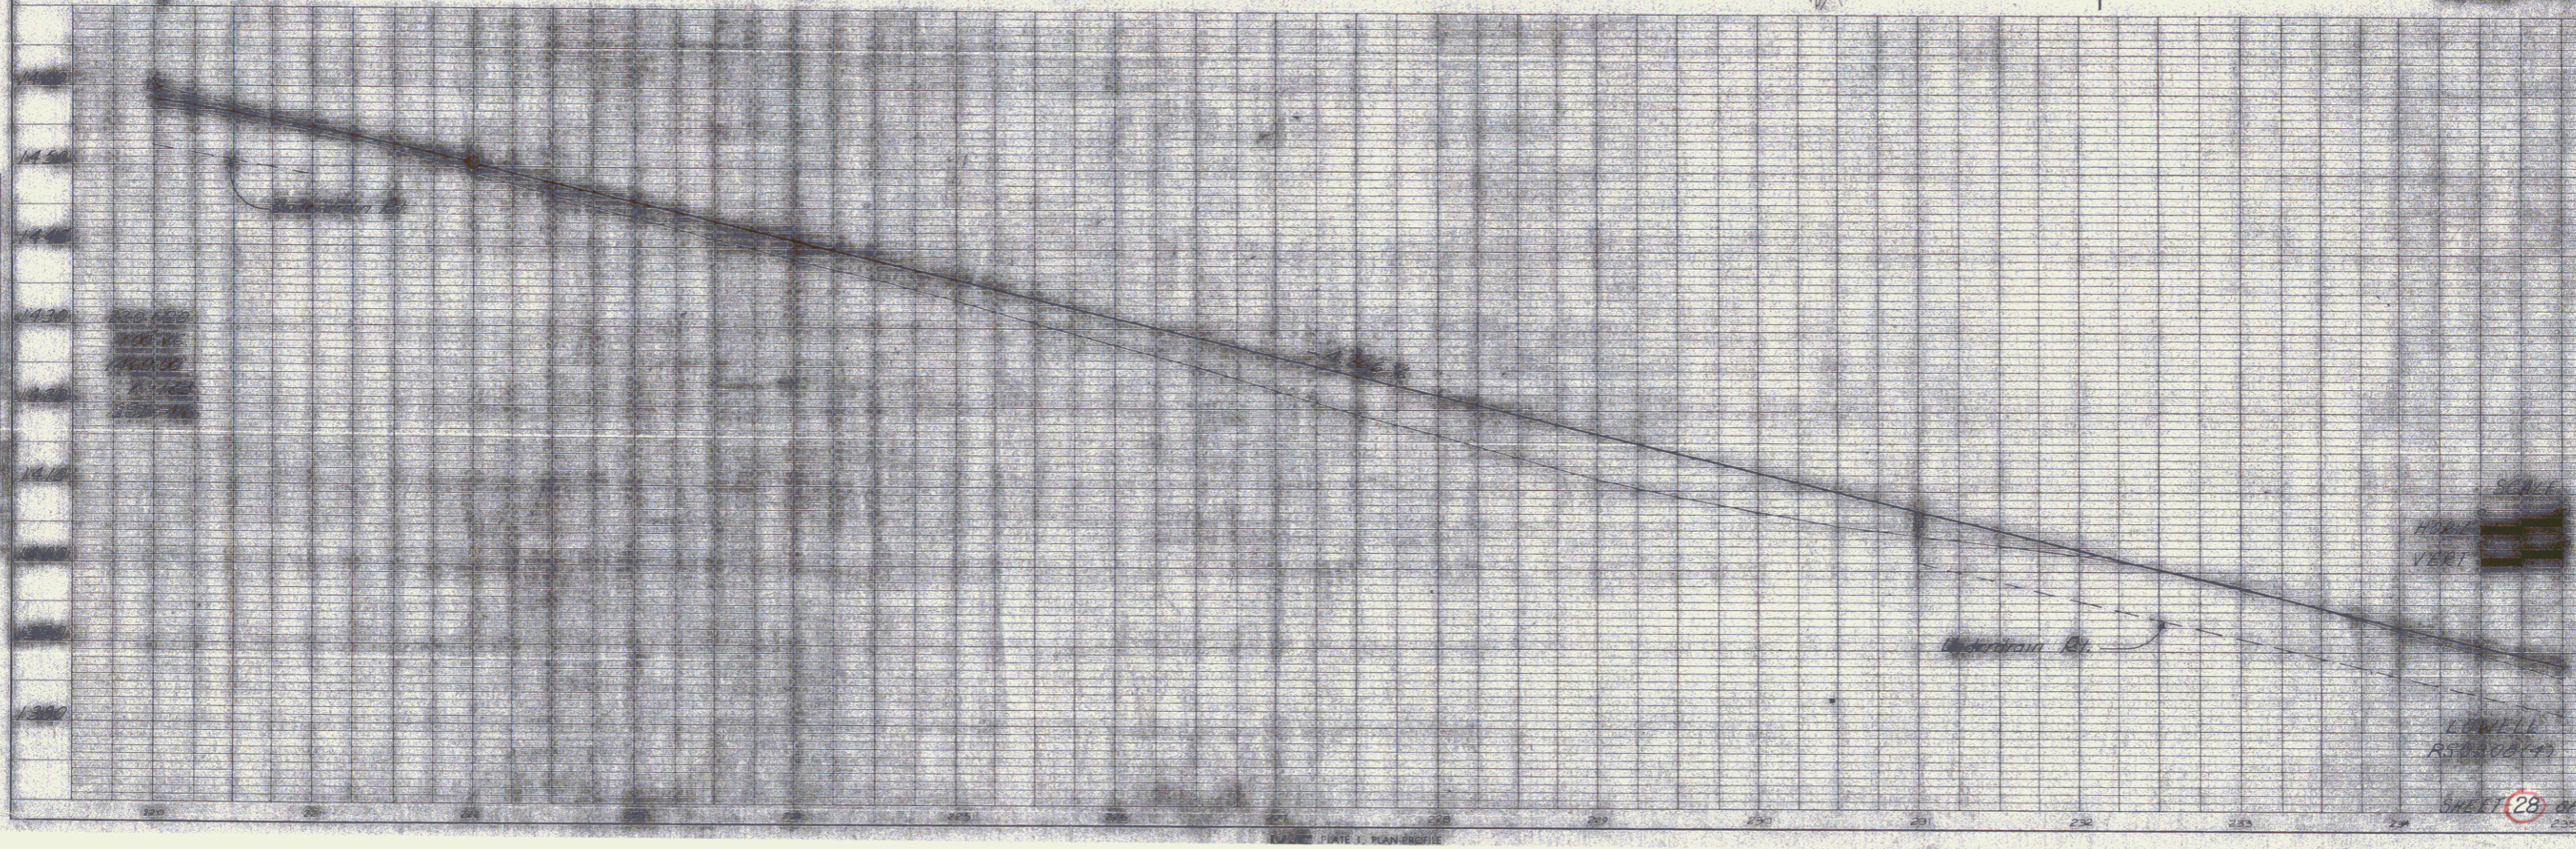

29