

CONSTRUCT DRIVE
LT.
246+55
242+50

STONE FILL TYPE I
LT.
245+00-246+00
242+70-244+75
246+75-249+00

ALL DRIVES AS INDICATED ON
PLANS ARE SUBJECT TO PER-
MITS PURSUANT TO TITLE 19,
SECTION 43, V.S.A.

GUARD RAIL, 3 CABLE W/ LIGHT WOOD POST
LT.
242+75-244+00

STA. 244+00.0
Δ 42°-30' RT. Tang. to Curve
New 12' x 6' x 8' RT. Box
BR 200 Series
See Sheets of

STONE FILL TYPE II
LT.
246+40
246+77

PIECHOTA, EDITH P.

DRIVE DATA
Δ 42° 43' LT.
D 4'
R 1000.35
2 T L 50.4
Bank 1041.1171

GRECO, FRANK & NICHOLAS


LAMPHERE

TRIMBLE, THEODORE R.

LAMPHERE, GEORGE A & PEARL H.

POOR ORIGINAL COPY

SCALE

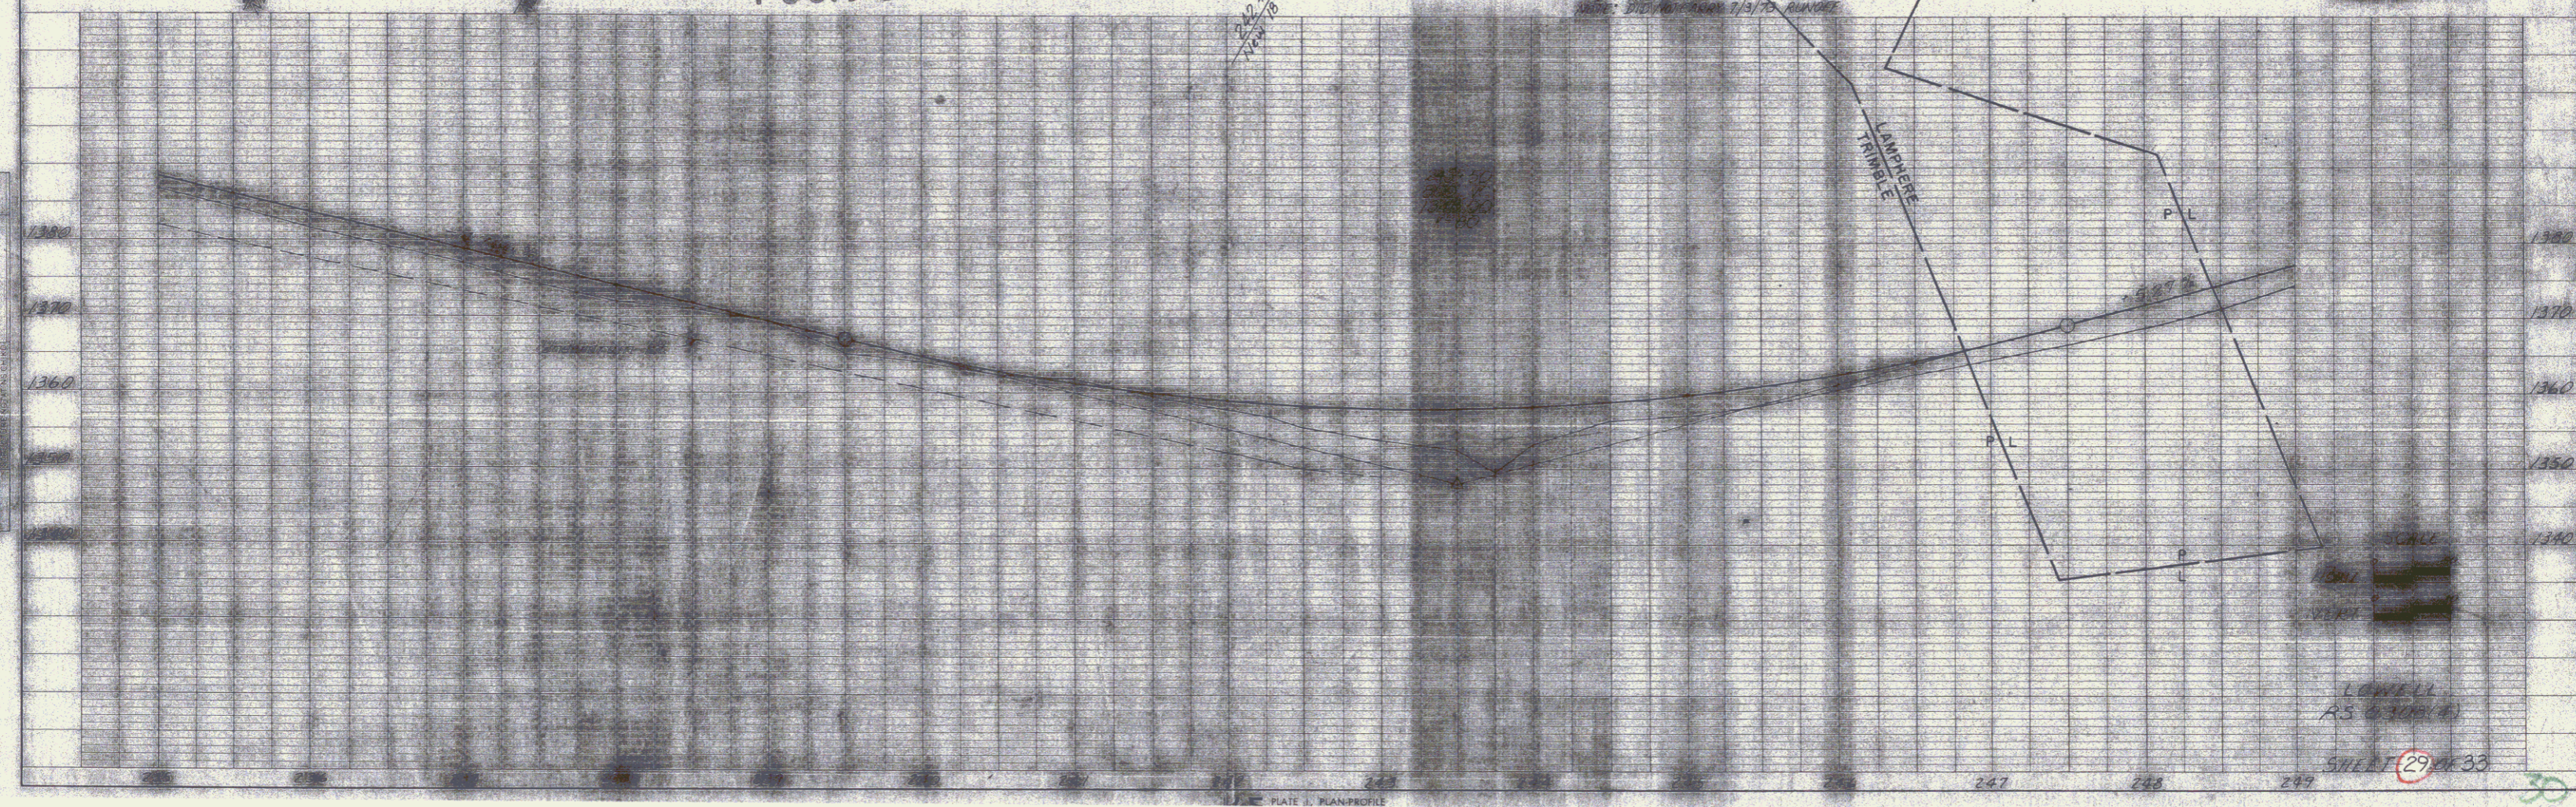

LOWELL
SHEET 29 OF 33

30