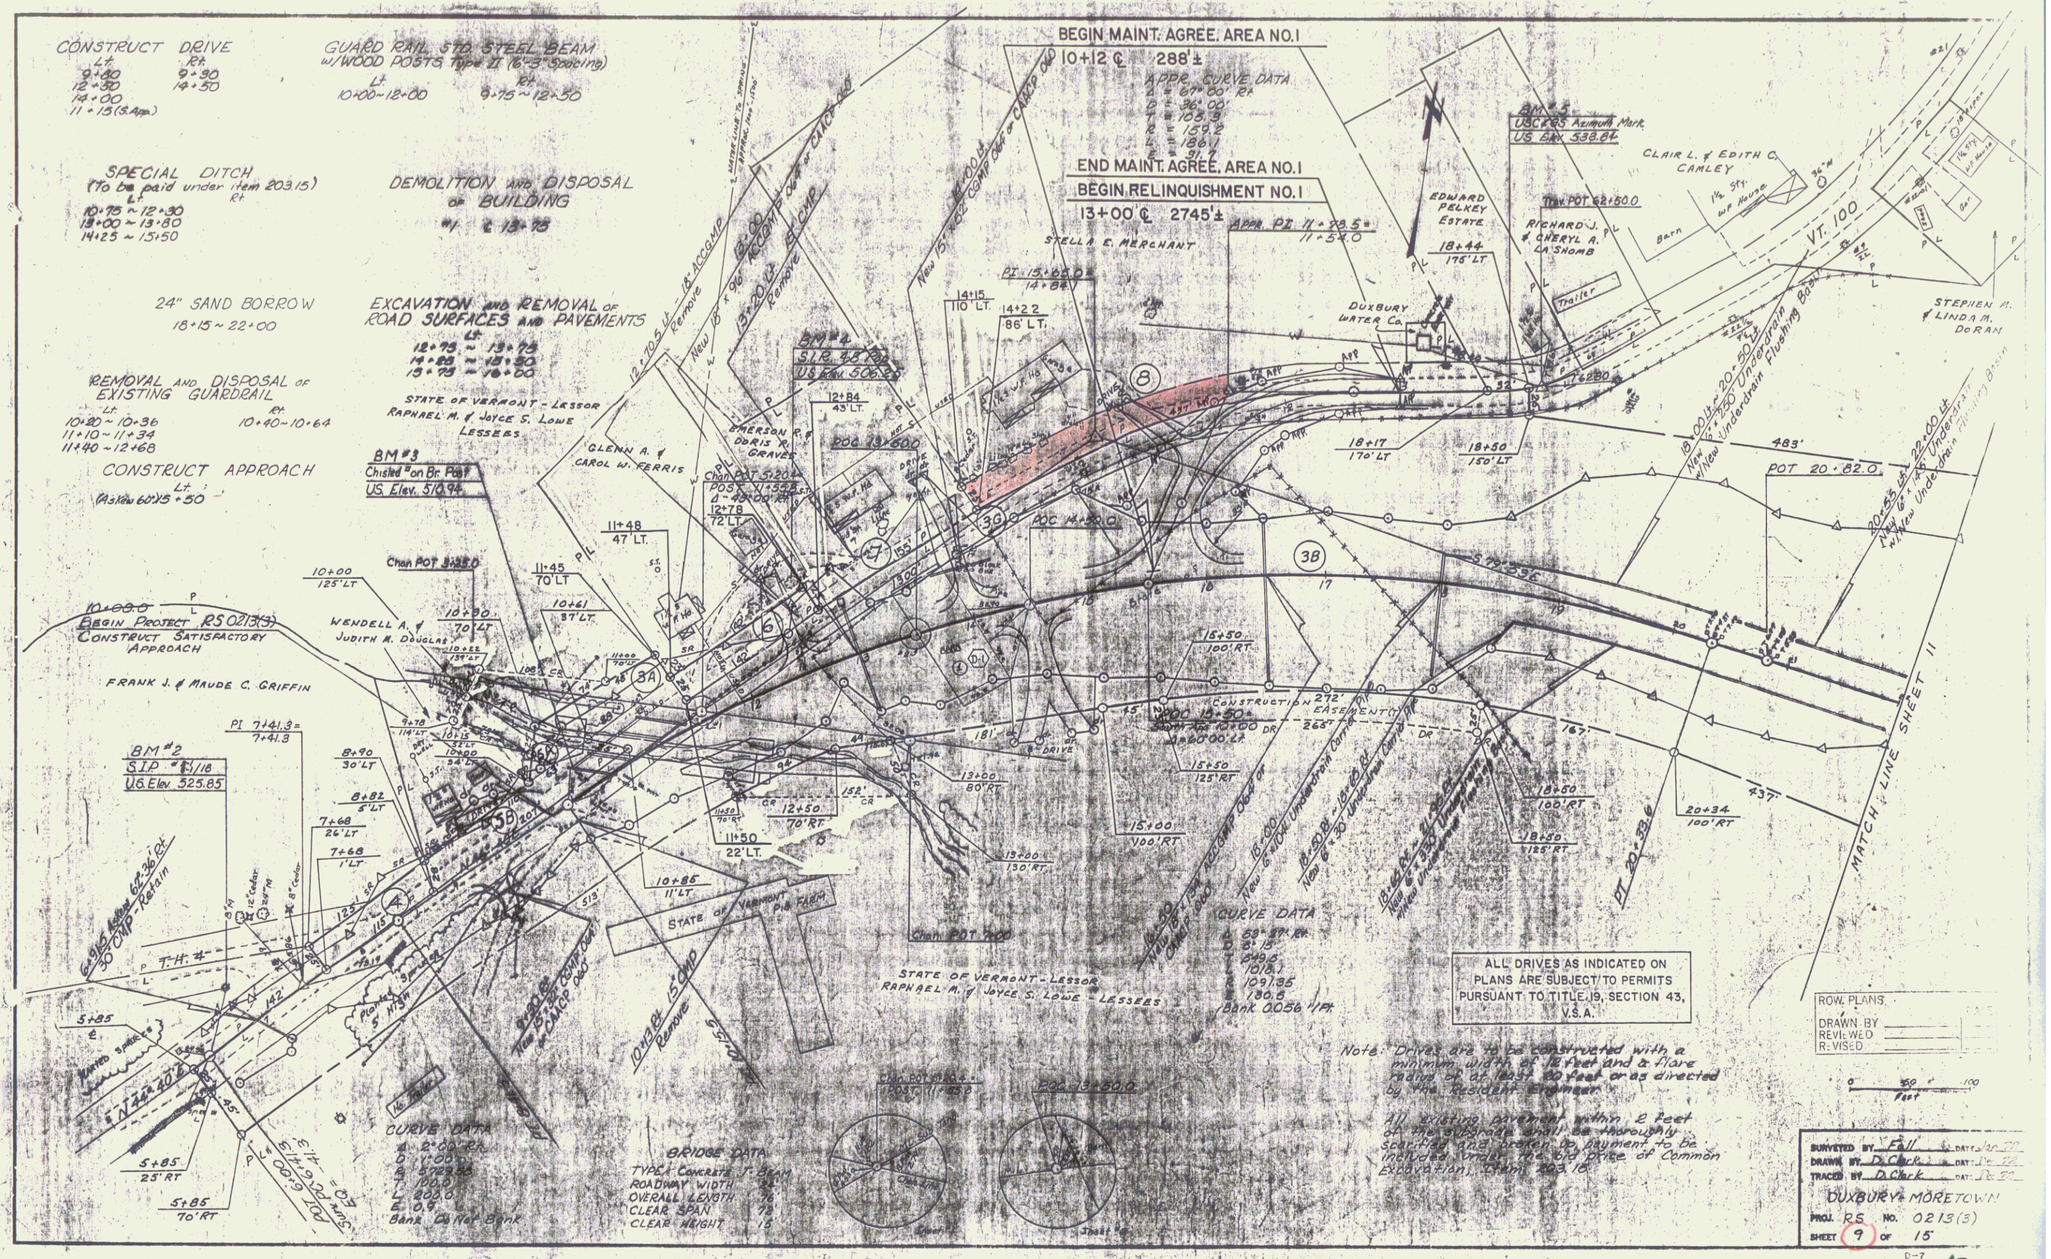POOR ORIGINAL COPY