POOR ORIGINAL COPY

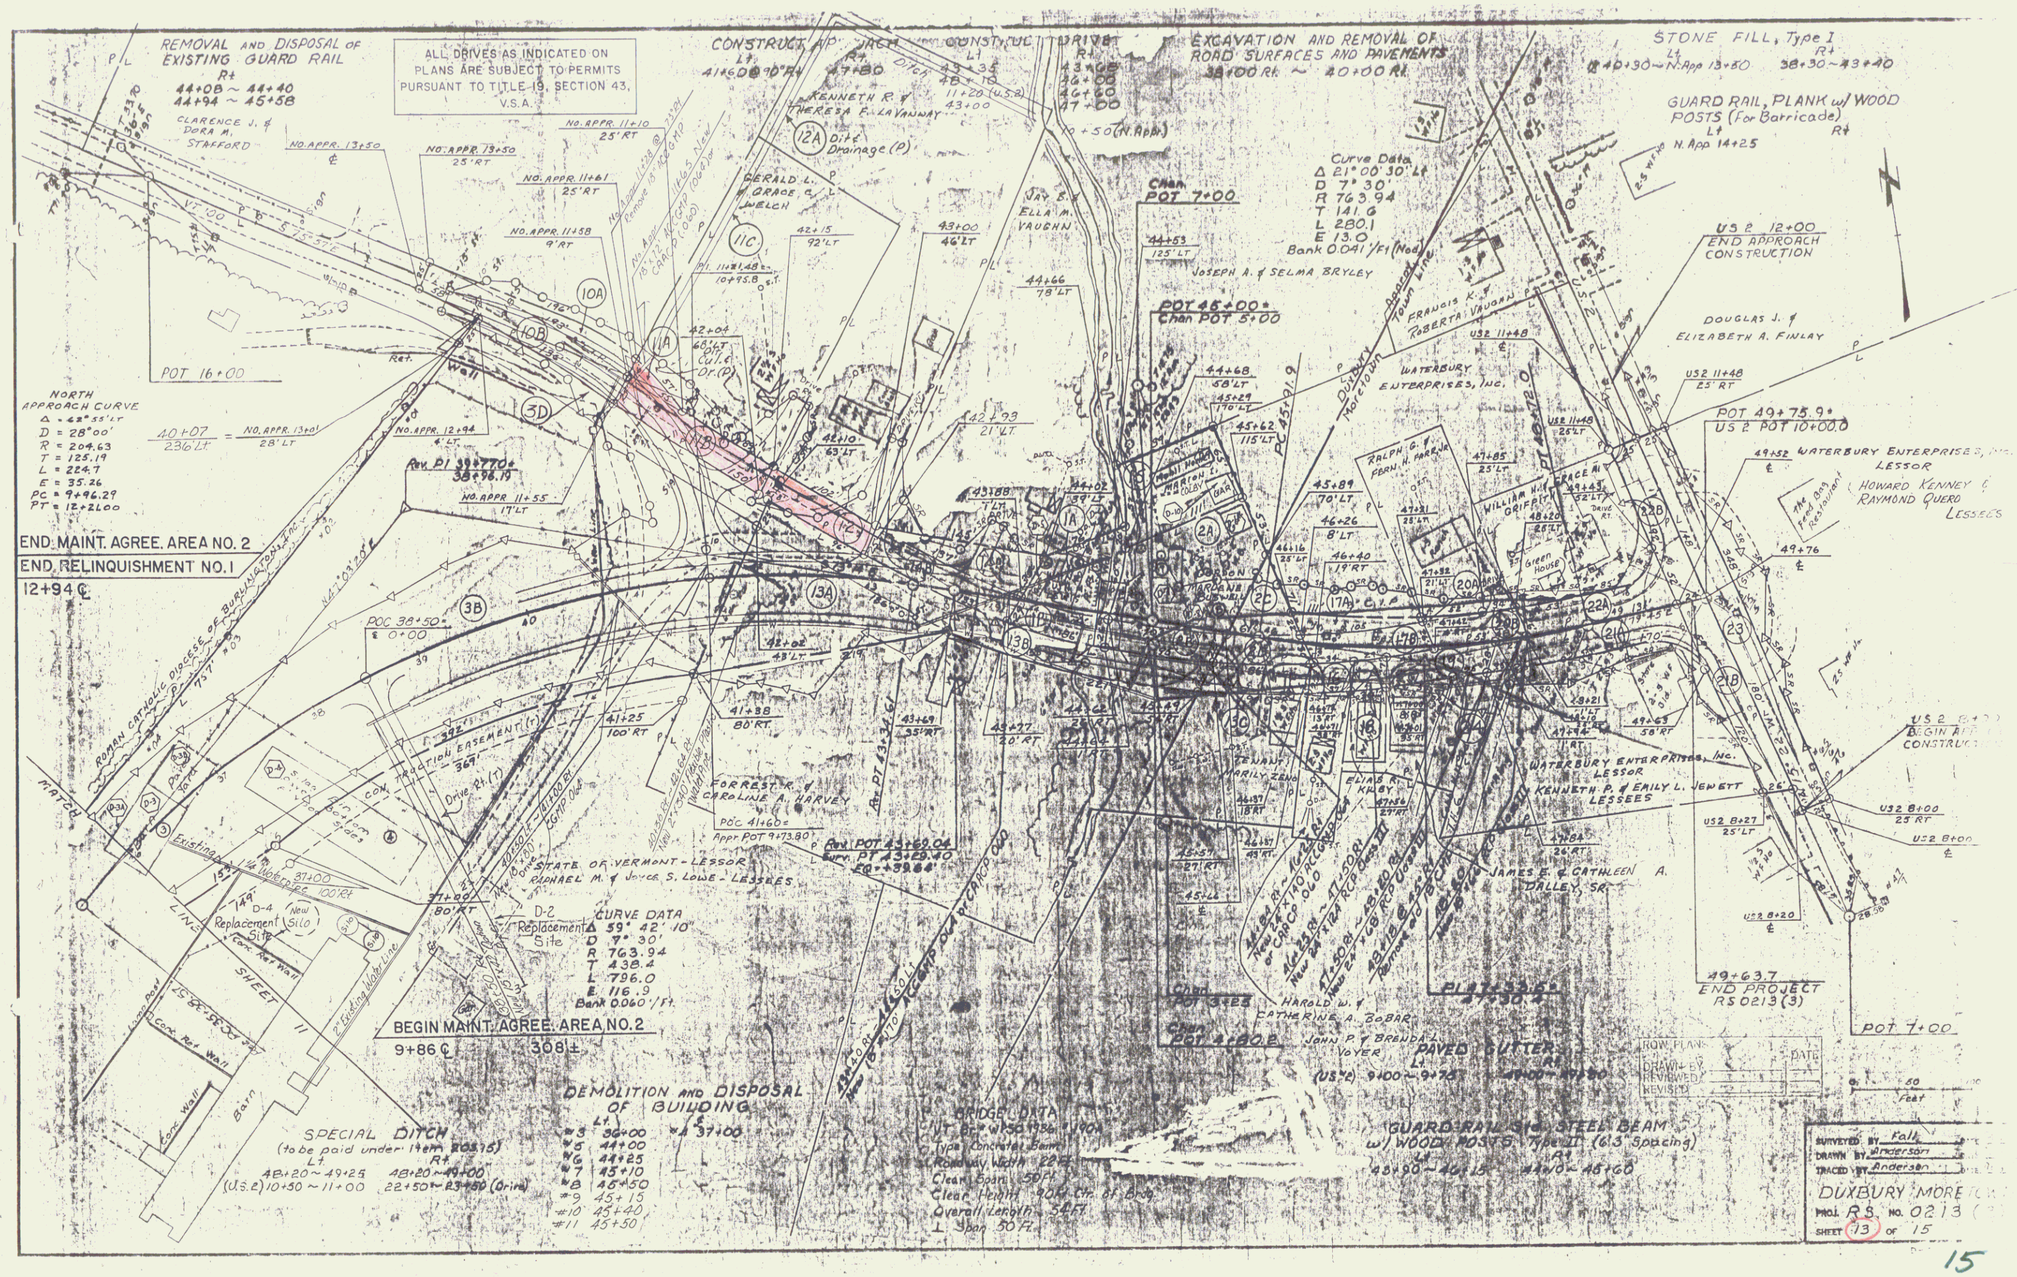

15