


PLAN
 DRAWN BY
 CHECKED BY
 DATE

PROFILE
 DRAWN BY
 CHECKED BY
 DATE

POOR ORIGINAL COPY

ROW PLANS
 DRAWN BY
 CHECKED BY
 DATE

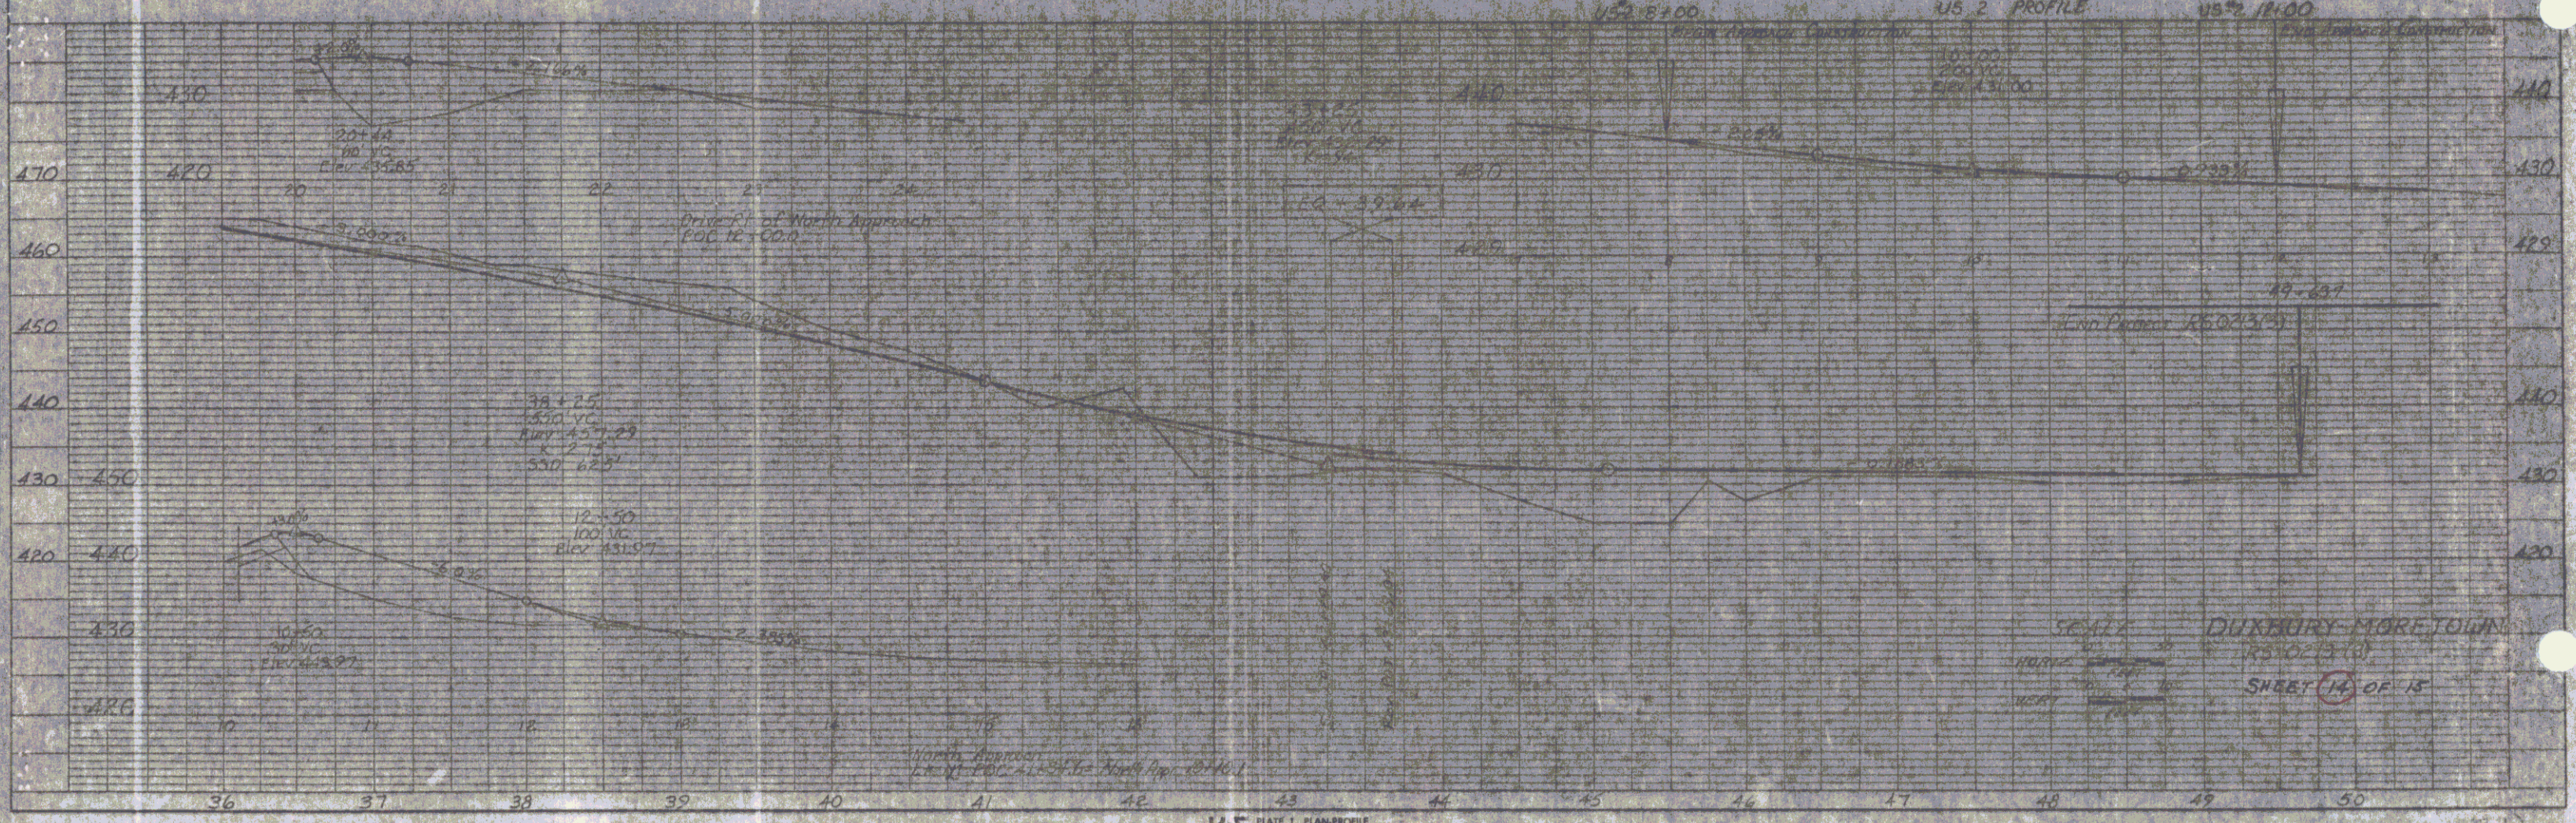

POOR ORIGINAL COPY POOR ORIGINAL COPY POOR ORIGINAL COPY