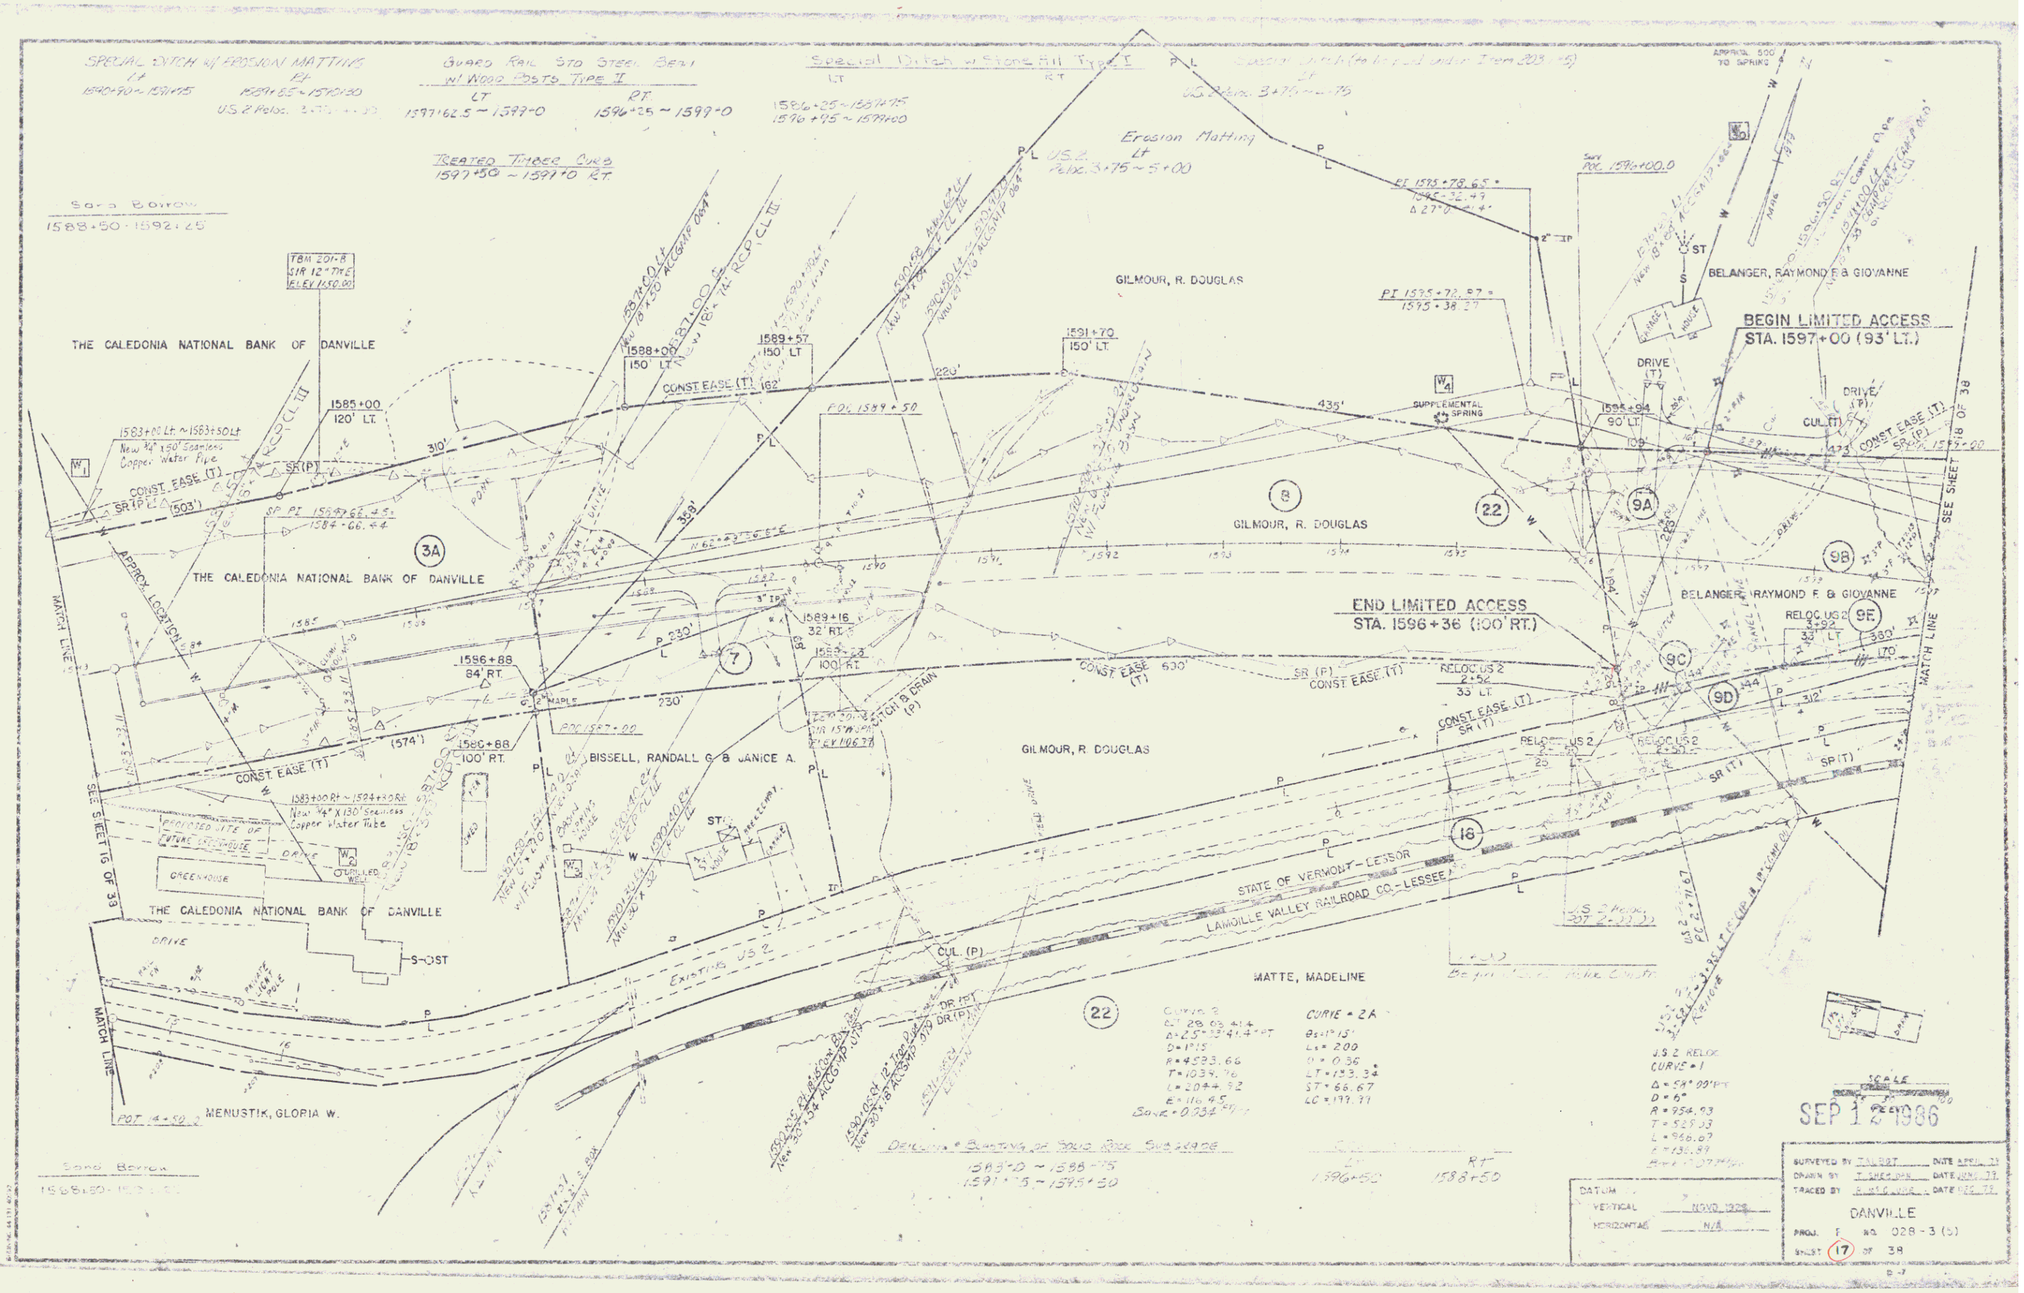
THE CALEDONIA NATIONAL BANK OF DANVILLE
GILMOUR, R. DOUGLAS
BELANGER, RAYMOND F. & GIOVANNE
BEGIN LIMITED ACCESS
STA. 1597+00 (93' LT.)
END LIMITED ACCESS
STA. 1596+36 (100' RT.)
BISSELL, RANDALL G. & JANICE A.
MATTE, MADELINE
MENUSTIK, GLORIA W.
STATE OF VERMONT - LESSOR
LAMOILLE VALLEY RAILROAD CO. - LESSEE
Erosion Matting
Lt
US 2 Reloc. 3+75 ~ 5+00
Special Ditch w/ Stone Fill Type I
Guard Rail Sta Steel Beam w/ Wood Posts Type II
Treated Timber Curb
Sand Borrow
1588+50 - 1592+25
CONST EASE (T)
SEE SHEET 16 OF 33
SEE SHEET 18 OF 38
MATCH LINE
SEP 12 1986