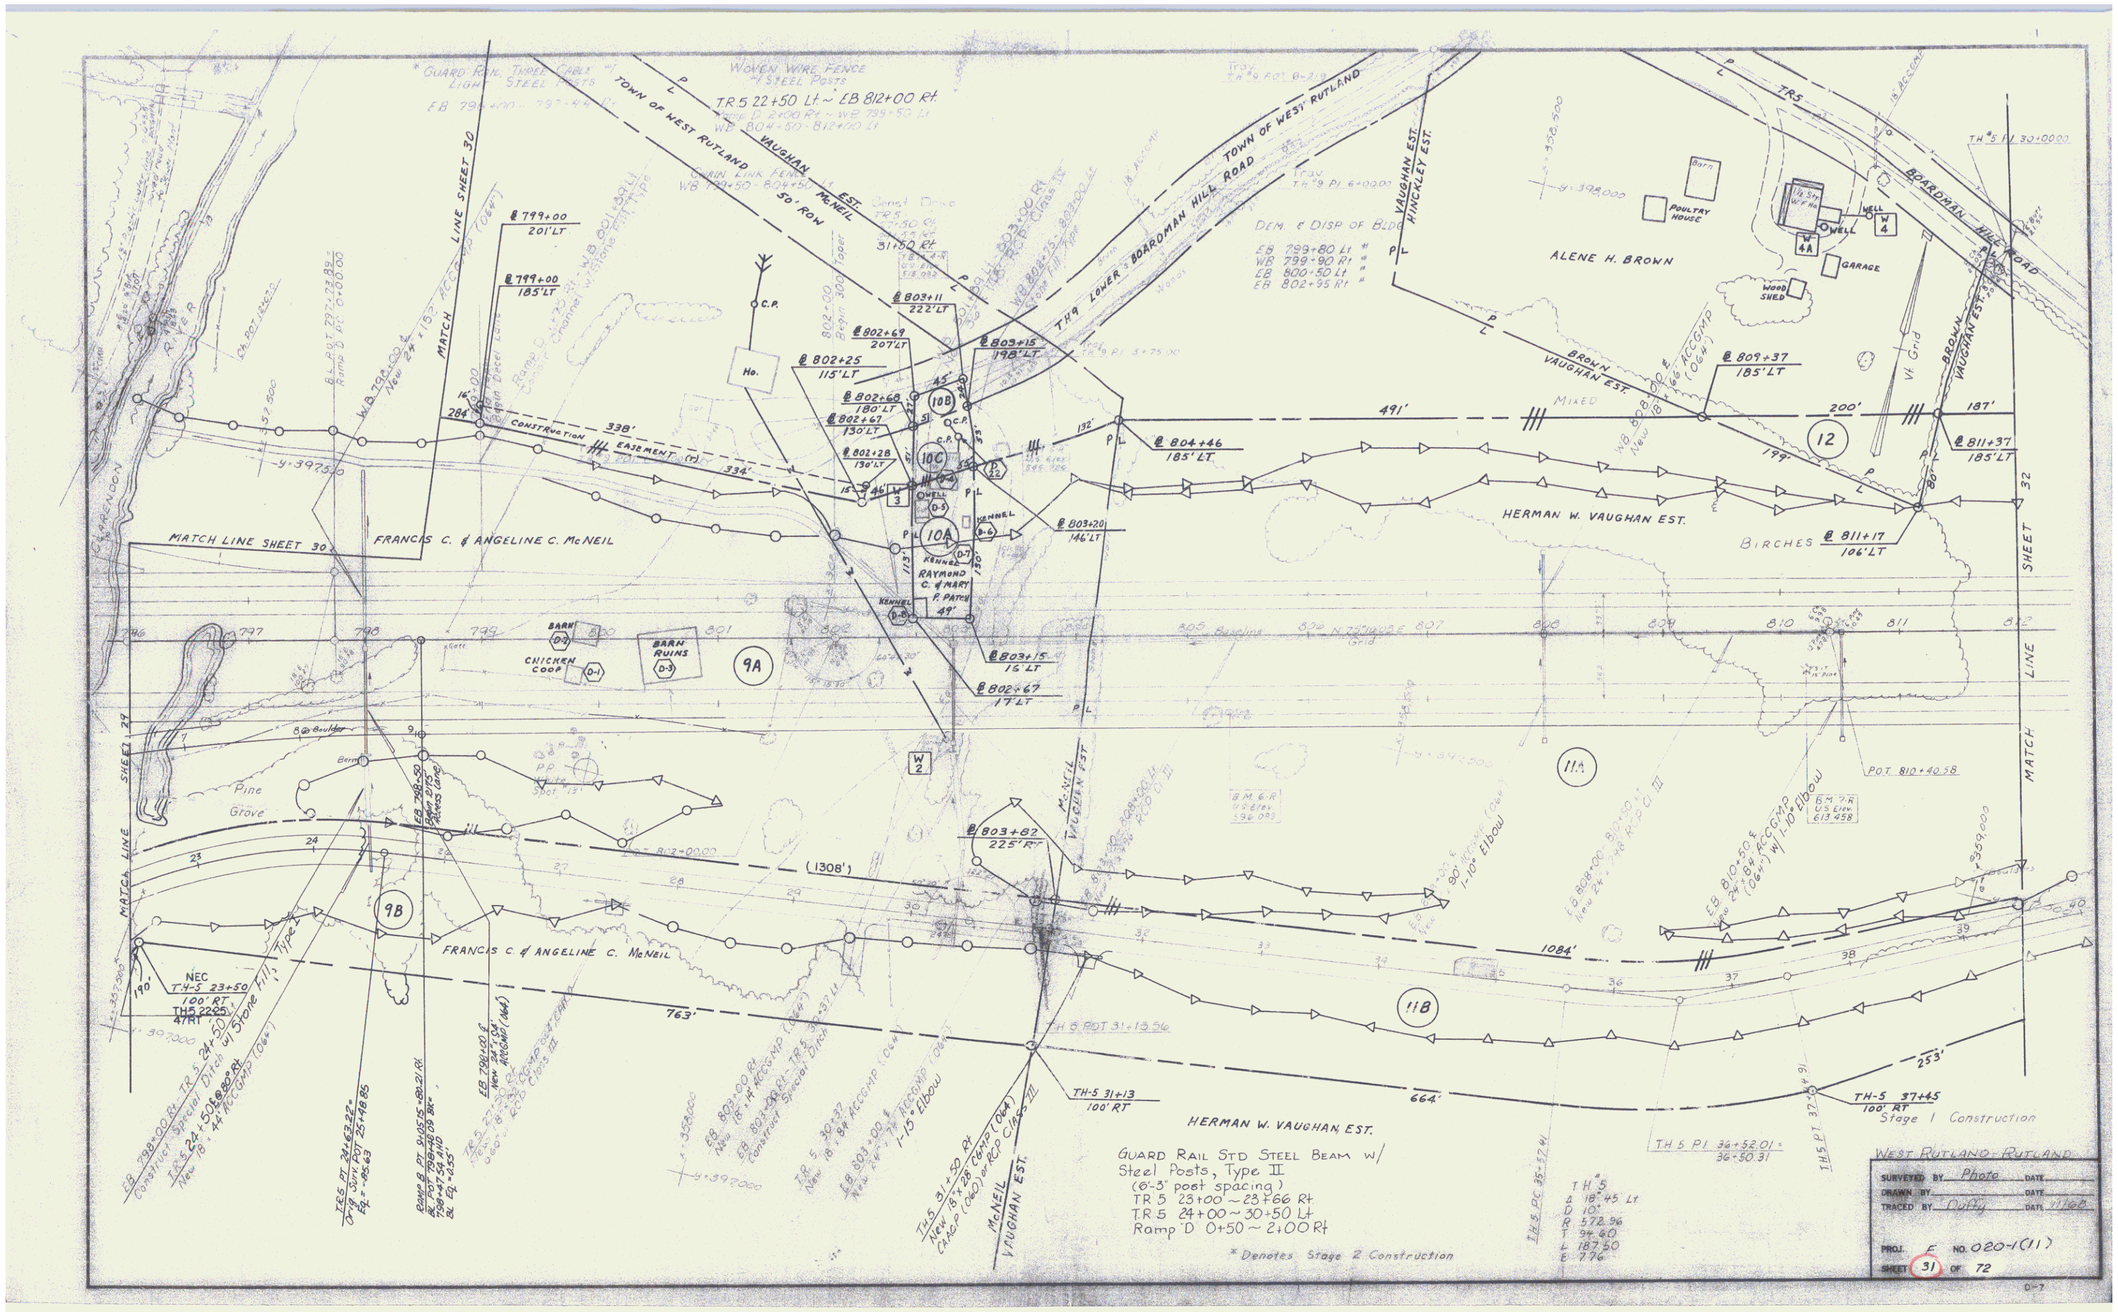
TR 5 22+50 Lt ~ EB 812+00 Rt
TOWN OF WEST RUTLAND
VAUGHAN EST.
McNEIL
50' ROW
TH 9 LOWER BOARDMAN HILL ROAD
TOWN OF WEST RUTLAND
VAUGHAN EST.
HINCKLEY EST.
TR 5
BOARDMAN HILL ROAD
ALENE H. BROWN
POULTRY HOUSE
GARAGE
WOOD SHED
WELL
BROWN
VAUGHAN EST.
MATCH LINE SHEET 30
FRANCIS C. & ANGELINE C. McNEIL
HERMAN W. VAUGHAN EST.
BIRCHES
MATCH LINE SHEET 32
MATCH LINE SHEET 29
Pine Grove
CHICKEN COOP
BARN RUINS
RAYMOND C. & MARY F. PATCH
KENNEL
CONSTRUCTION EASEMENT
(1308')
1084'
763'
664'
253'
GUARD RAIL STD STEEL BEAM W/
Steel Posts, Type II
(6'-3' post spacing)
TR 5 23+00 ~ 23+66 Rt
TR 5 24+00 ~ 30+50 Lt
Ramp D 0+50 ~ 2+00 Rt
* Denotes Stage 2 Construction
TH-5 37+45
100' RT
Stage 1 Construction
WEST RUTLAND-RUTLAND
SURVEYED BY Photo
DRAWN BY
TRACED BY Duffy
PROJ. F NO. 020-1(11)
SHEET 31 OF 72