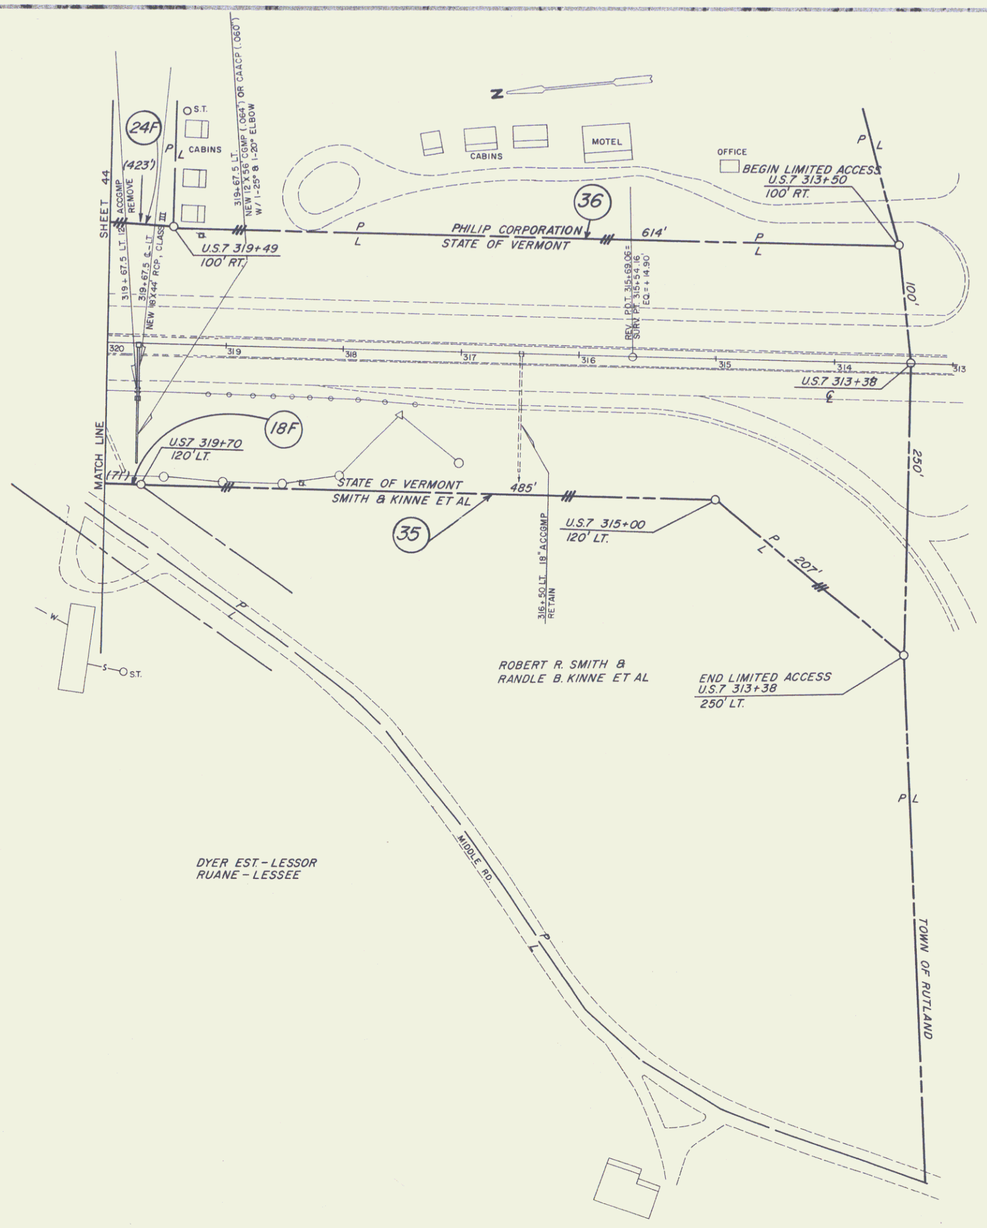

WEST RUTLAND - RUTLAND
F020-1 (11)
SHEET 45 OF 72 SHEETS