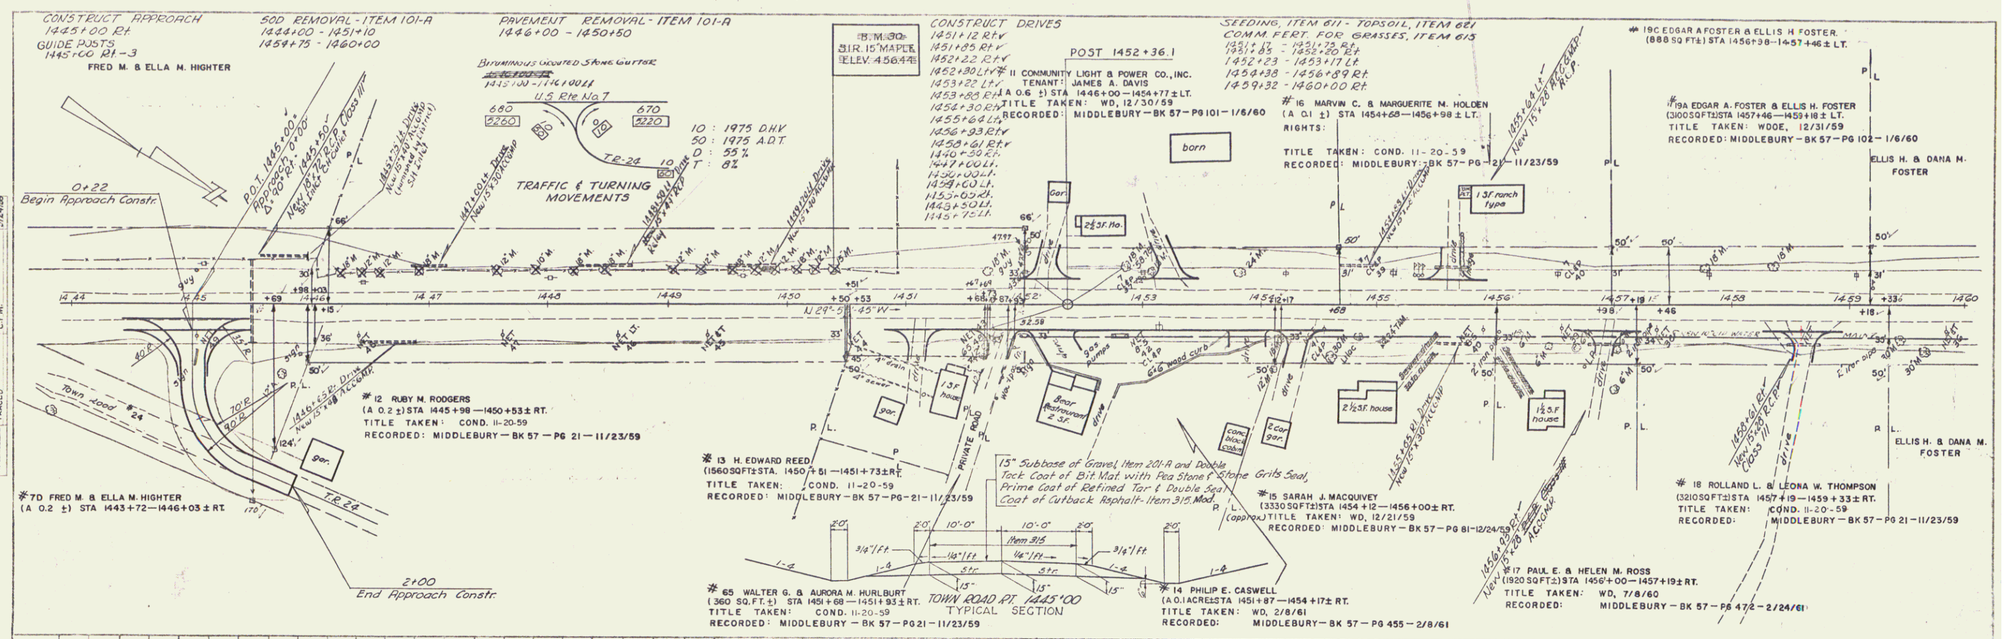
CONSTRUCT APPROACH
1445+00 Rt
GUIDE POSTS
1445+00 Rt -3
FRED M. & ELLA M. HIGHTER
50D REMOVAL - ITEM 101-A
1444+00 - 1451+10
1454+75 - 1460+00
PAVEMENT REMOVAL - ITEM 101-A
1446+00 - 1450+50
BITUMINOUS COATED STONE GUTTER
U.S. Rte No. 7
TRAFFIC & TURNING MOVEMENTS
10 : 1975 D.H.V.
50 : 1975 A.D.T.
D : 55%
T : 8%
B.M. 30
3 IR. 15" MAPLE
ELEV. 456.44
CONSTRUCT DRIVES
POST 1452+36.1
II COMMUNITY LIGHT & POWER CO., INC.
TENANT: JAMES A. DAVIS
(A 0.6 ±) STA 1446+00 — 1454+77 ± LT.
TITLE TAKEN: WD, 12/30/59
RECORDED: MIDDLEBURY — BK 57 — PG 101 — 1/6/60
SEEDING, ITEM 611 - TOPSOIL, ITEM 621
COMM. FERT. FOR GRASSES, ITEM 615
#16 MARVIN C. & MARGUERITE M. HOLDEN
(A 0.1 ±) STA 1454+68 — 1456+98 ± LT.
RIGHTS:
TITLE TAKEN: COND. 11-20-59
RECORDED: MIDDLEBURY — BK 57 — PG 21 — 11/23/59
#19C EDGAR A. FOSTER & ELLIS H. FOSTER
(888 SQ. FT.±) STA 1456+98 — 1457+46 ± LT.
#19A EDGAR A. FOSTER & ELLIS H. FOSTER
(3100 SQ. FT.±) STA 1457+46 — 1459+18 ± LT.
TITLE TAKEN: WDDE, 12/31/59
RECORDED: MIDDLEBURY — BK 57 — PG 102 — 1/6/60
ELLIS H. & DANA M. FOSTER
0+22
Begin Approach Constr.
Town Road #24
#12 RUBY M. RODGERS
(A 0.2 ±) STA 1445+98 — 1450+53 ± RT.
TITLE TAKEN: COND. 11-20-59
RECORDED: MIDDLEBURY — BK 57 — PG 21 — 11/23/59
#7D FRED M. & ELLA M. HIGHTER
(A 0.2 ±) STA 1443+72 — 1446+03 ± RT.
2+00
End Approach Constr.
#13 H. EDWARD REED
(1560 SQ. FT.± STA. 1450+51 — 1451+73 ± RT.
TITLE TAKEN: COND. 11-20-59
RECORDED: MIDDLEBURY — BK 57 — PG 21 — 11/23/59
15" Subbase of Gravel, Item 201-A and Double Tack Coat of Bit. Mat. with Pea Stone & Stone Grits Seal, Prime Coat of Refined Tar & Double Seal Coat of Cutback Asphalt - Item 315, Mod.
#15 SARAH J. MACQUIVEY
(3330 SQ. FT.±) STA 1454+12 — 1456+00 ± RT.
TITLE TAKEN: WD, 12/21/59
RECORDED: MIDDLEBURY — BK 57 — PG 81 — 12/24/59
#18 ROLLAND L. & LEONA W. THOMPSON
(3210 SQ. FT.±) STA 1457+19 — 1459+33 ± RT.
TITLE TAKEN: COND. 11-20-59
RECORDED: MIDDLEBURY — BK 57 — PG 21 — 11/23/59
#17 PAUL E. & HELEN E. ROSS
(1920 SQ. FT.±) STA 1456+00 — 1457+19 ± RT.
TITLE TAKEN: WD, 7/8/60
RECORDED: MIDDLEBURY — BK 57 — PG 472 — 2/24/61
#65 WALTER G. & AURORA M. HURLBURT
(360 SQ. FT.±) STA 1451+68 — 1451+93 ± RT.
TITLE TAKEN: COND. 11-20-59
RECORDED: MIDDLEBURY — BK 57 — PG 21 — 11/23/59
TOWN ROAD PT. 1445+00
TYPICAL SECTION
#14 PHILIP E. CASWELL
(A 0.1 ACRE) STA 1451+87 — 1454+17 ± RT.
TITLE TAKEN: WD, 2/8/61
RECORDED: MIDDLEBURY — BK 57 — PG 455 — 2/8/61
PRIVATE ROAD
barn
gar.
house
Bear Restaurant
P.V.I. 0+50
440.43
50' V.C.
P.V.I. 1+50
445.43
100' V.C.
-1.00%
+3.07%
Town Road 24
+2.140%
P.V.I. 1452+00
462.45
700' V.C.
-1.100%
MIDDLEBURY
Proj. F019-3(11)
Sheet 23 of 182

APR 25 1977 7