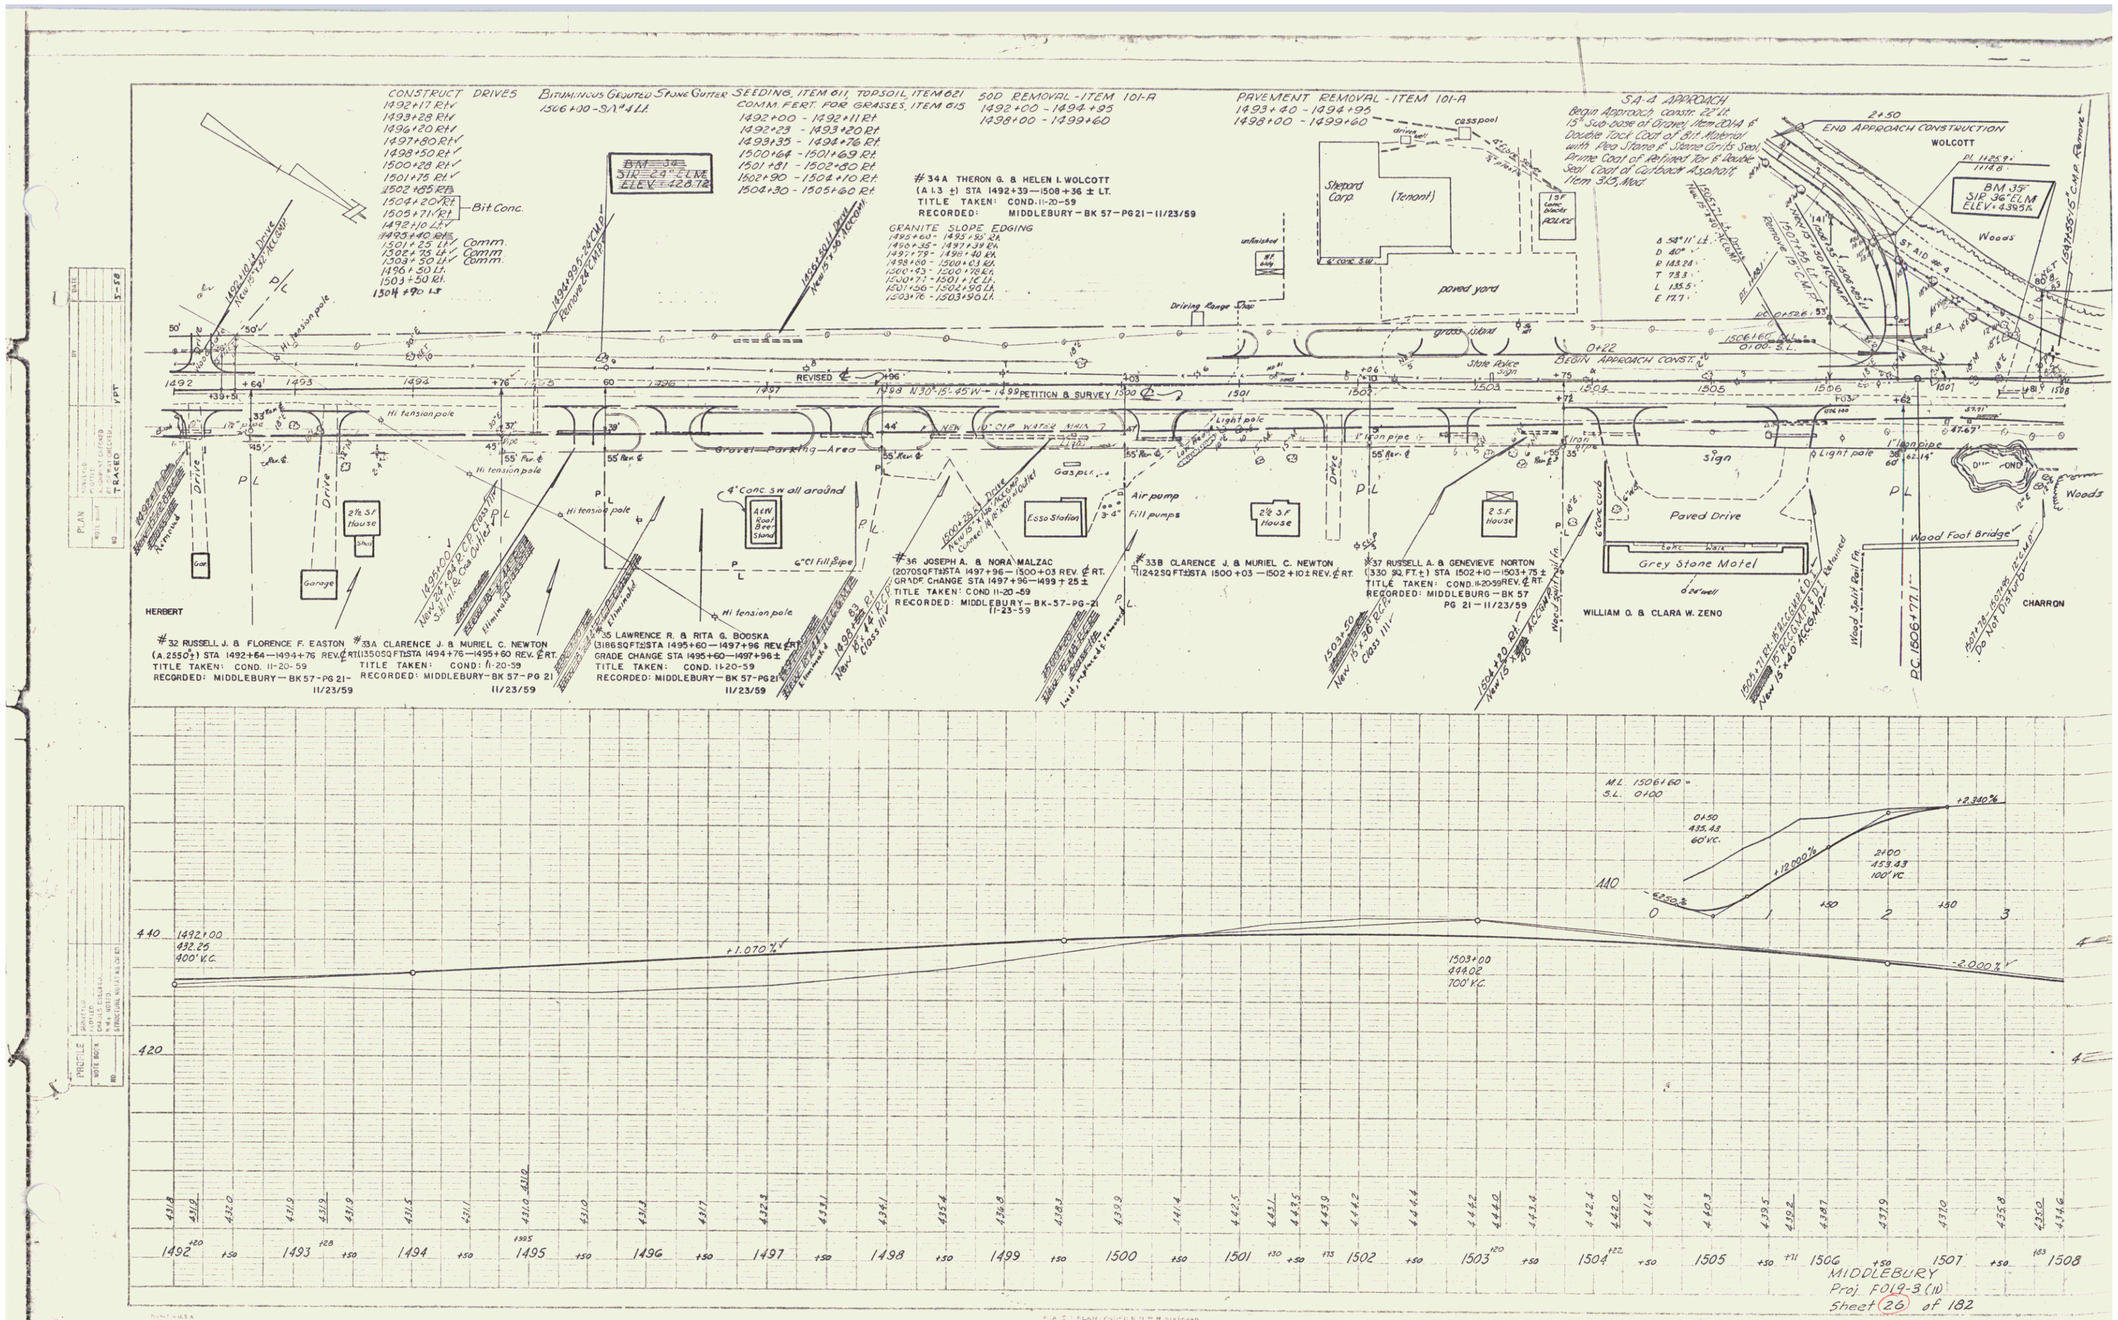

10

APR 25 1977